


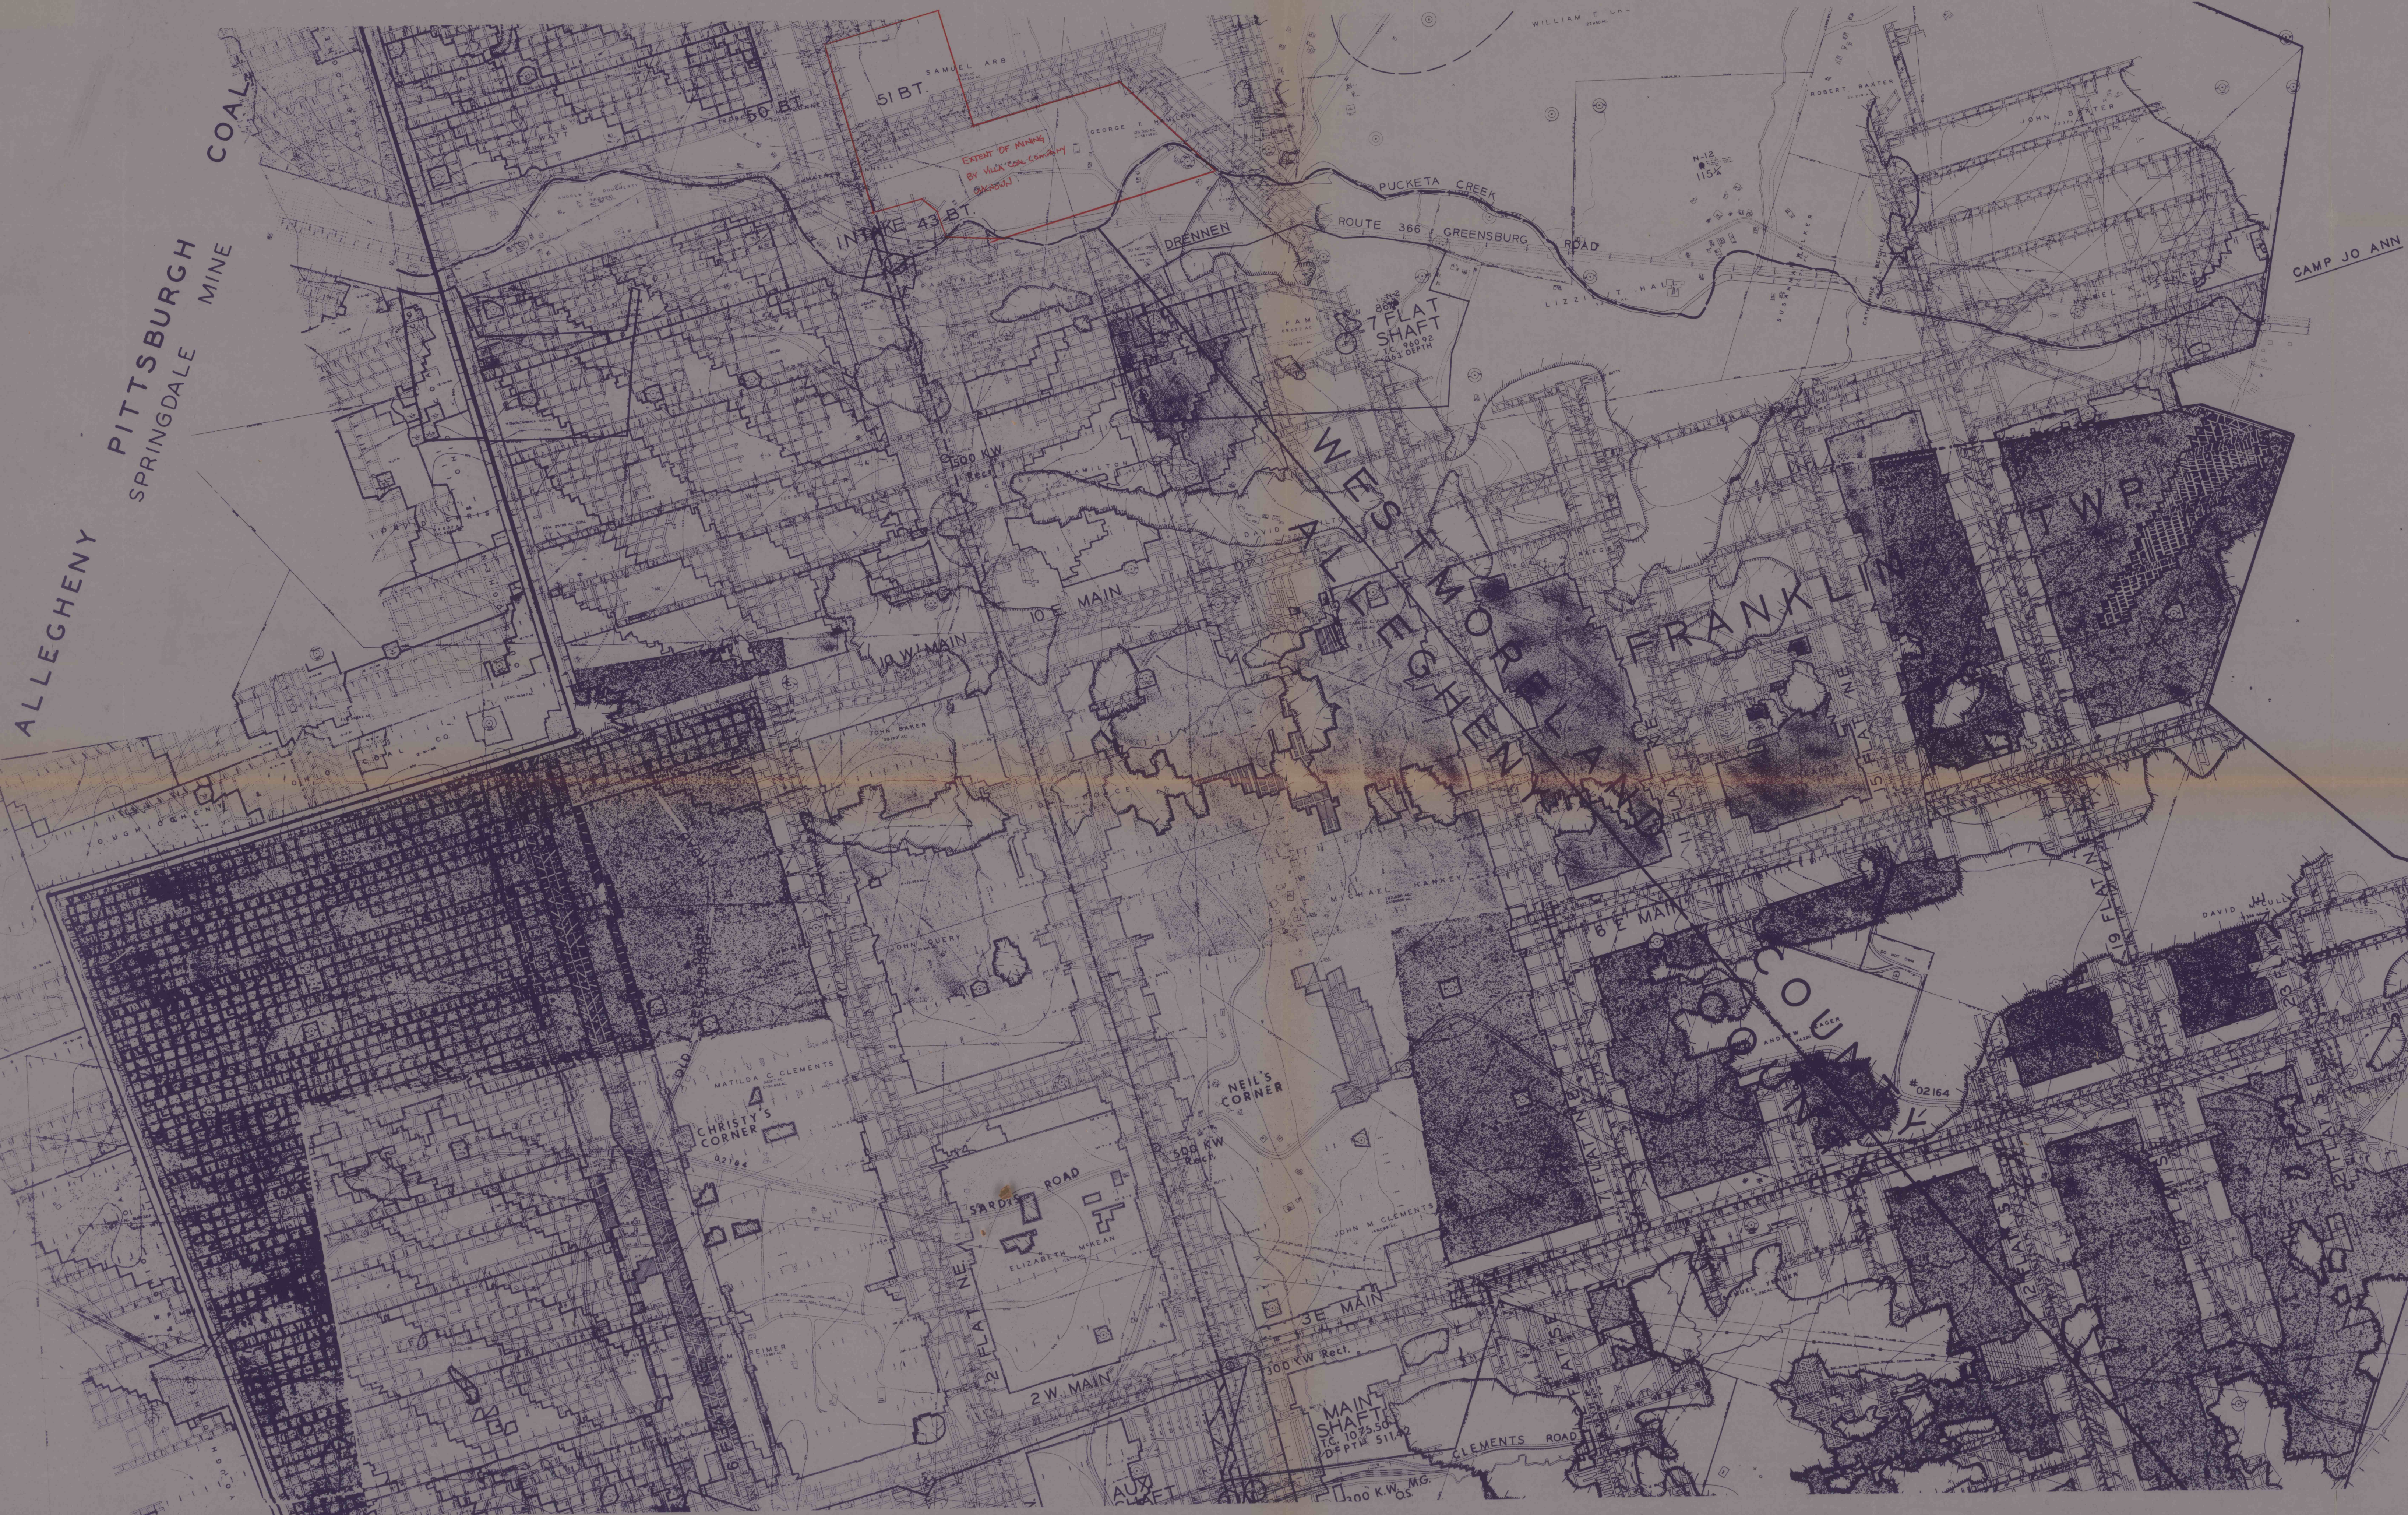

RENTON MINE - WORKS AS OF 11/25/85
1" = 500'
Extent of Mining by Villa Coal Company Unknown as
indicated on Sheet 4

Sheet 3 of 4

RECEIVED
JUN 20 1986
Dept. of Environmental Protection
Mining Control Unit

RECEIVED
MAY 01 1986
Dept. of Environmental Protection
Mining Control Unit