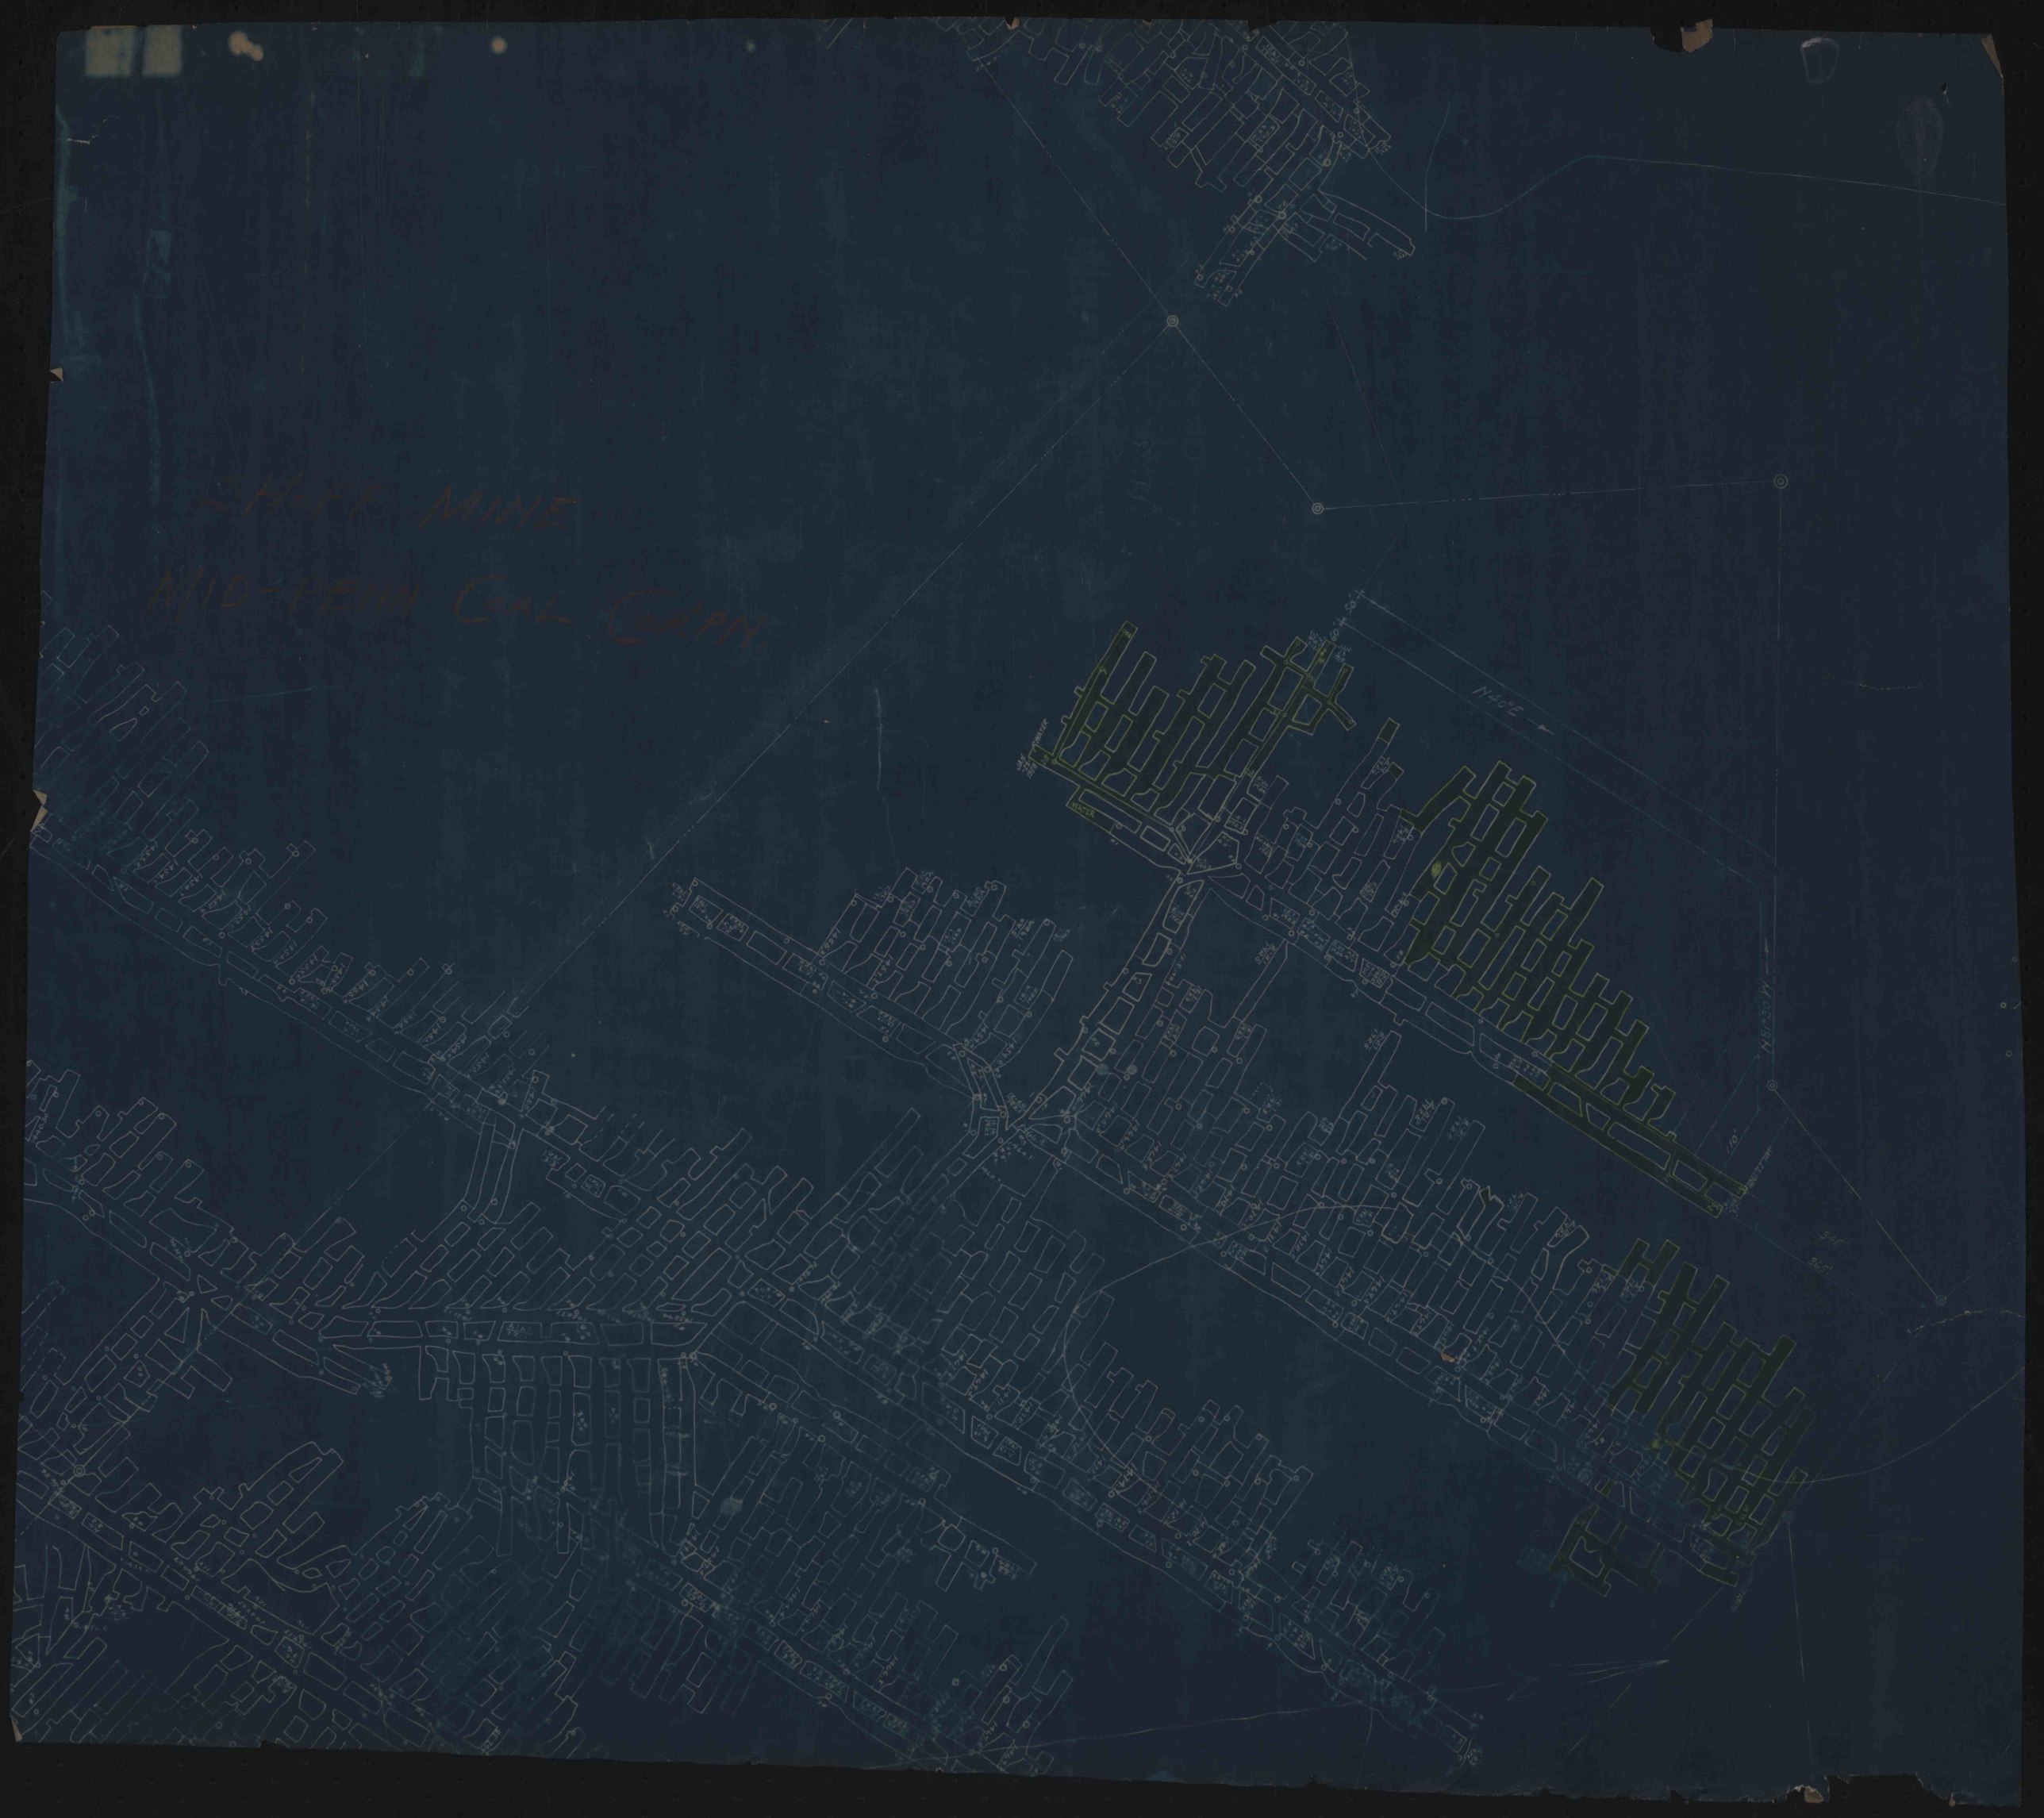
SHAFT MINE
MID-PENN COAL CORP
WATER
N 40°E
N 50°W