


1

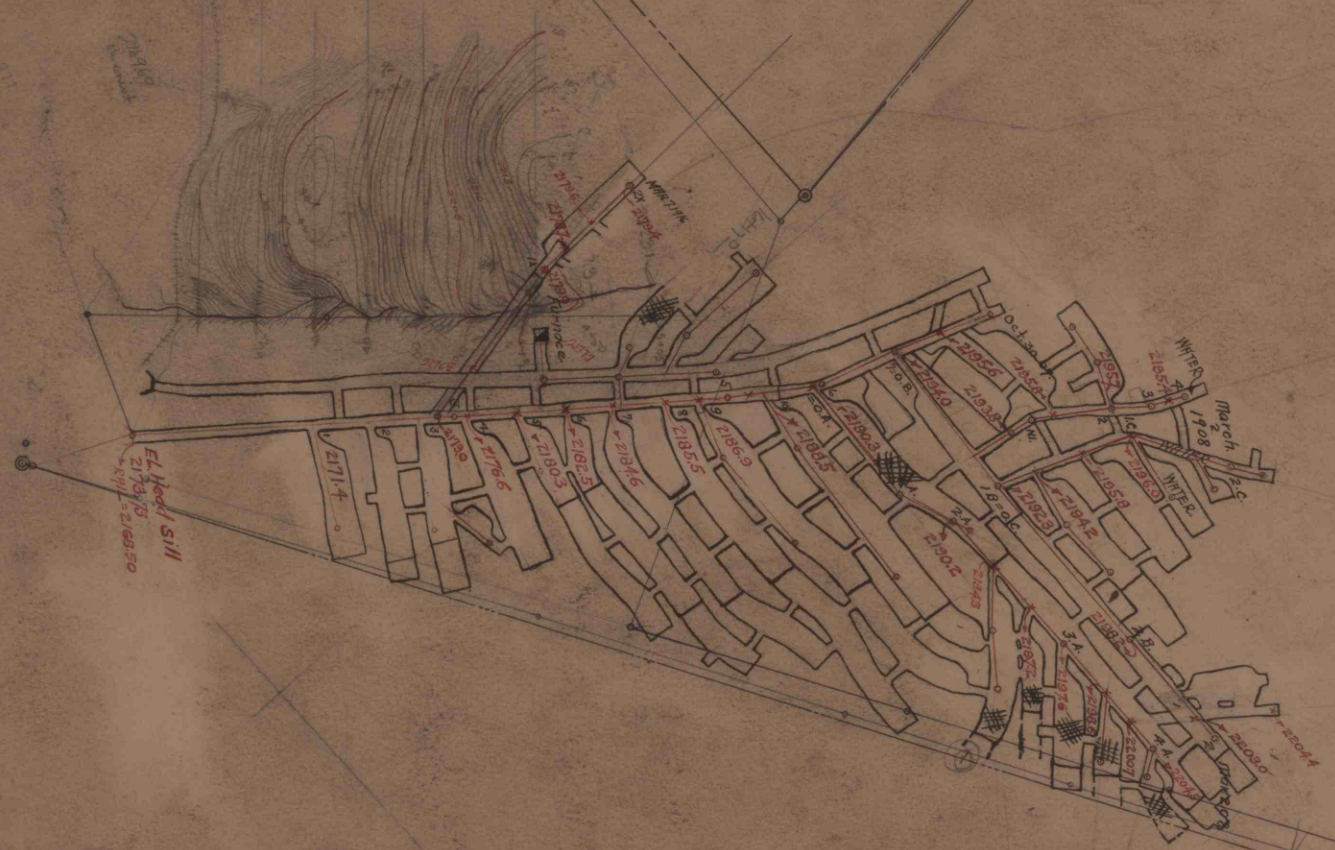


