


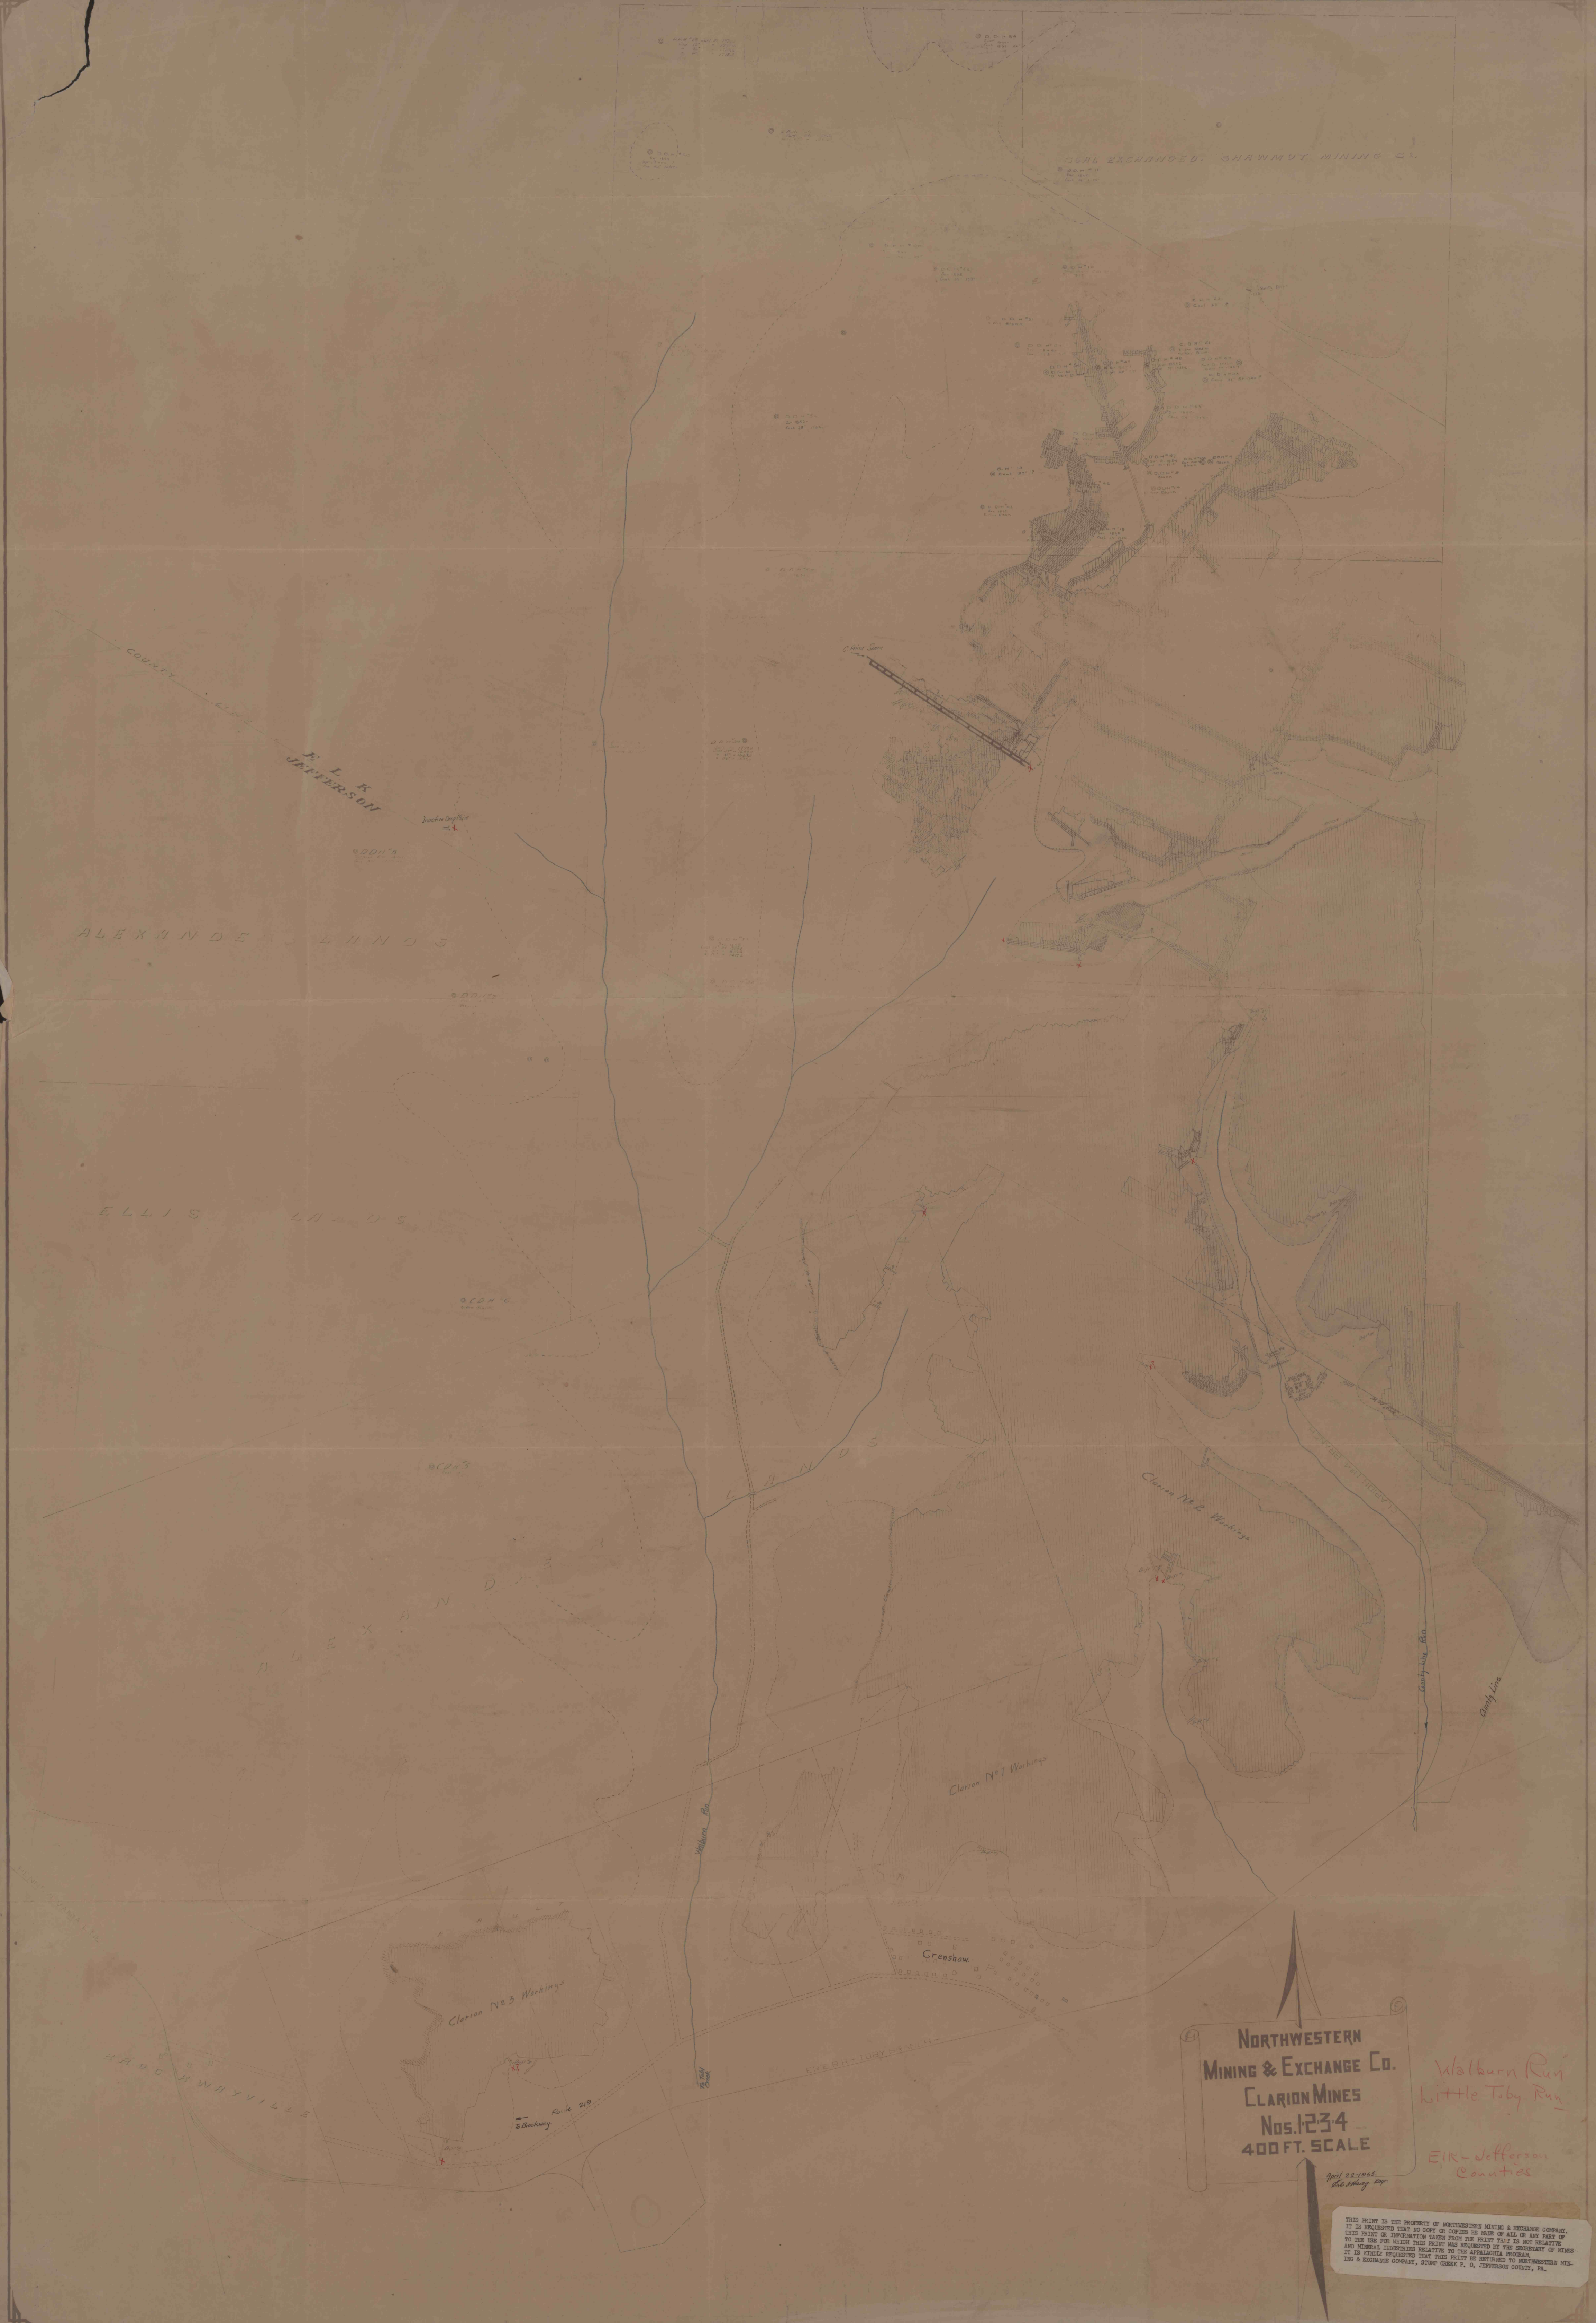

**NORTHWESTERN
MINING & EXCHANGE CO.**
CLARION MINES
Nos. 1234
400 FT. SCALE

Walburn Run
Little Toby Run
EIK-Jefferson
Counties

THIS PRINT IS THE PROPERTY OF NORTHWESTERN MINING & EXCHANGE COMPANY, IT IS REQUESTED THAT NO COPY OR COPIES BE MADE OF ALL OR ANY PART OF THIS PRINT OR INFORMATION TAKEN FROM THE PRINT. THIS PRINT IS NOT RELATIVE AND MINERAL INTERESTS RELATIVE TO THE APPALACHIAN REGION. IT IS ALSO REQUESTED THAT THIS PRINT BE RETURNED TO NORTHWESTERN MINING & EXCHANGE COMPANY, STOP CREEK P. O. JEFFERSON COUNTY, PA.