


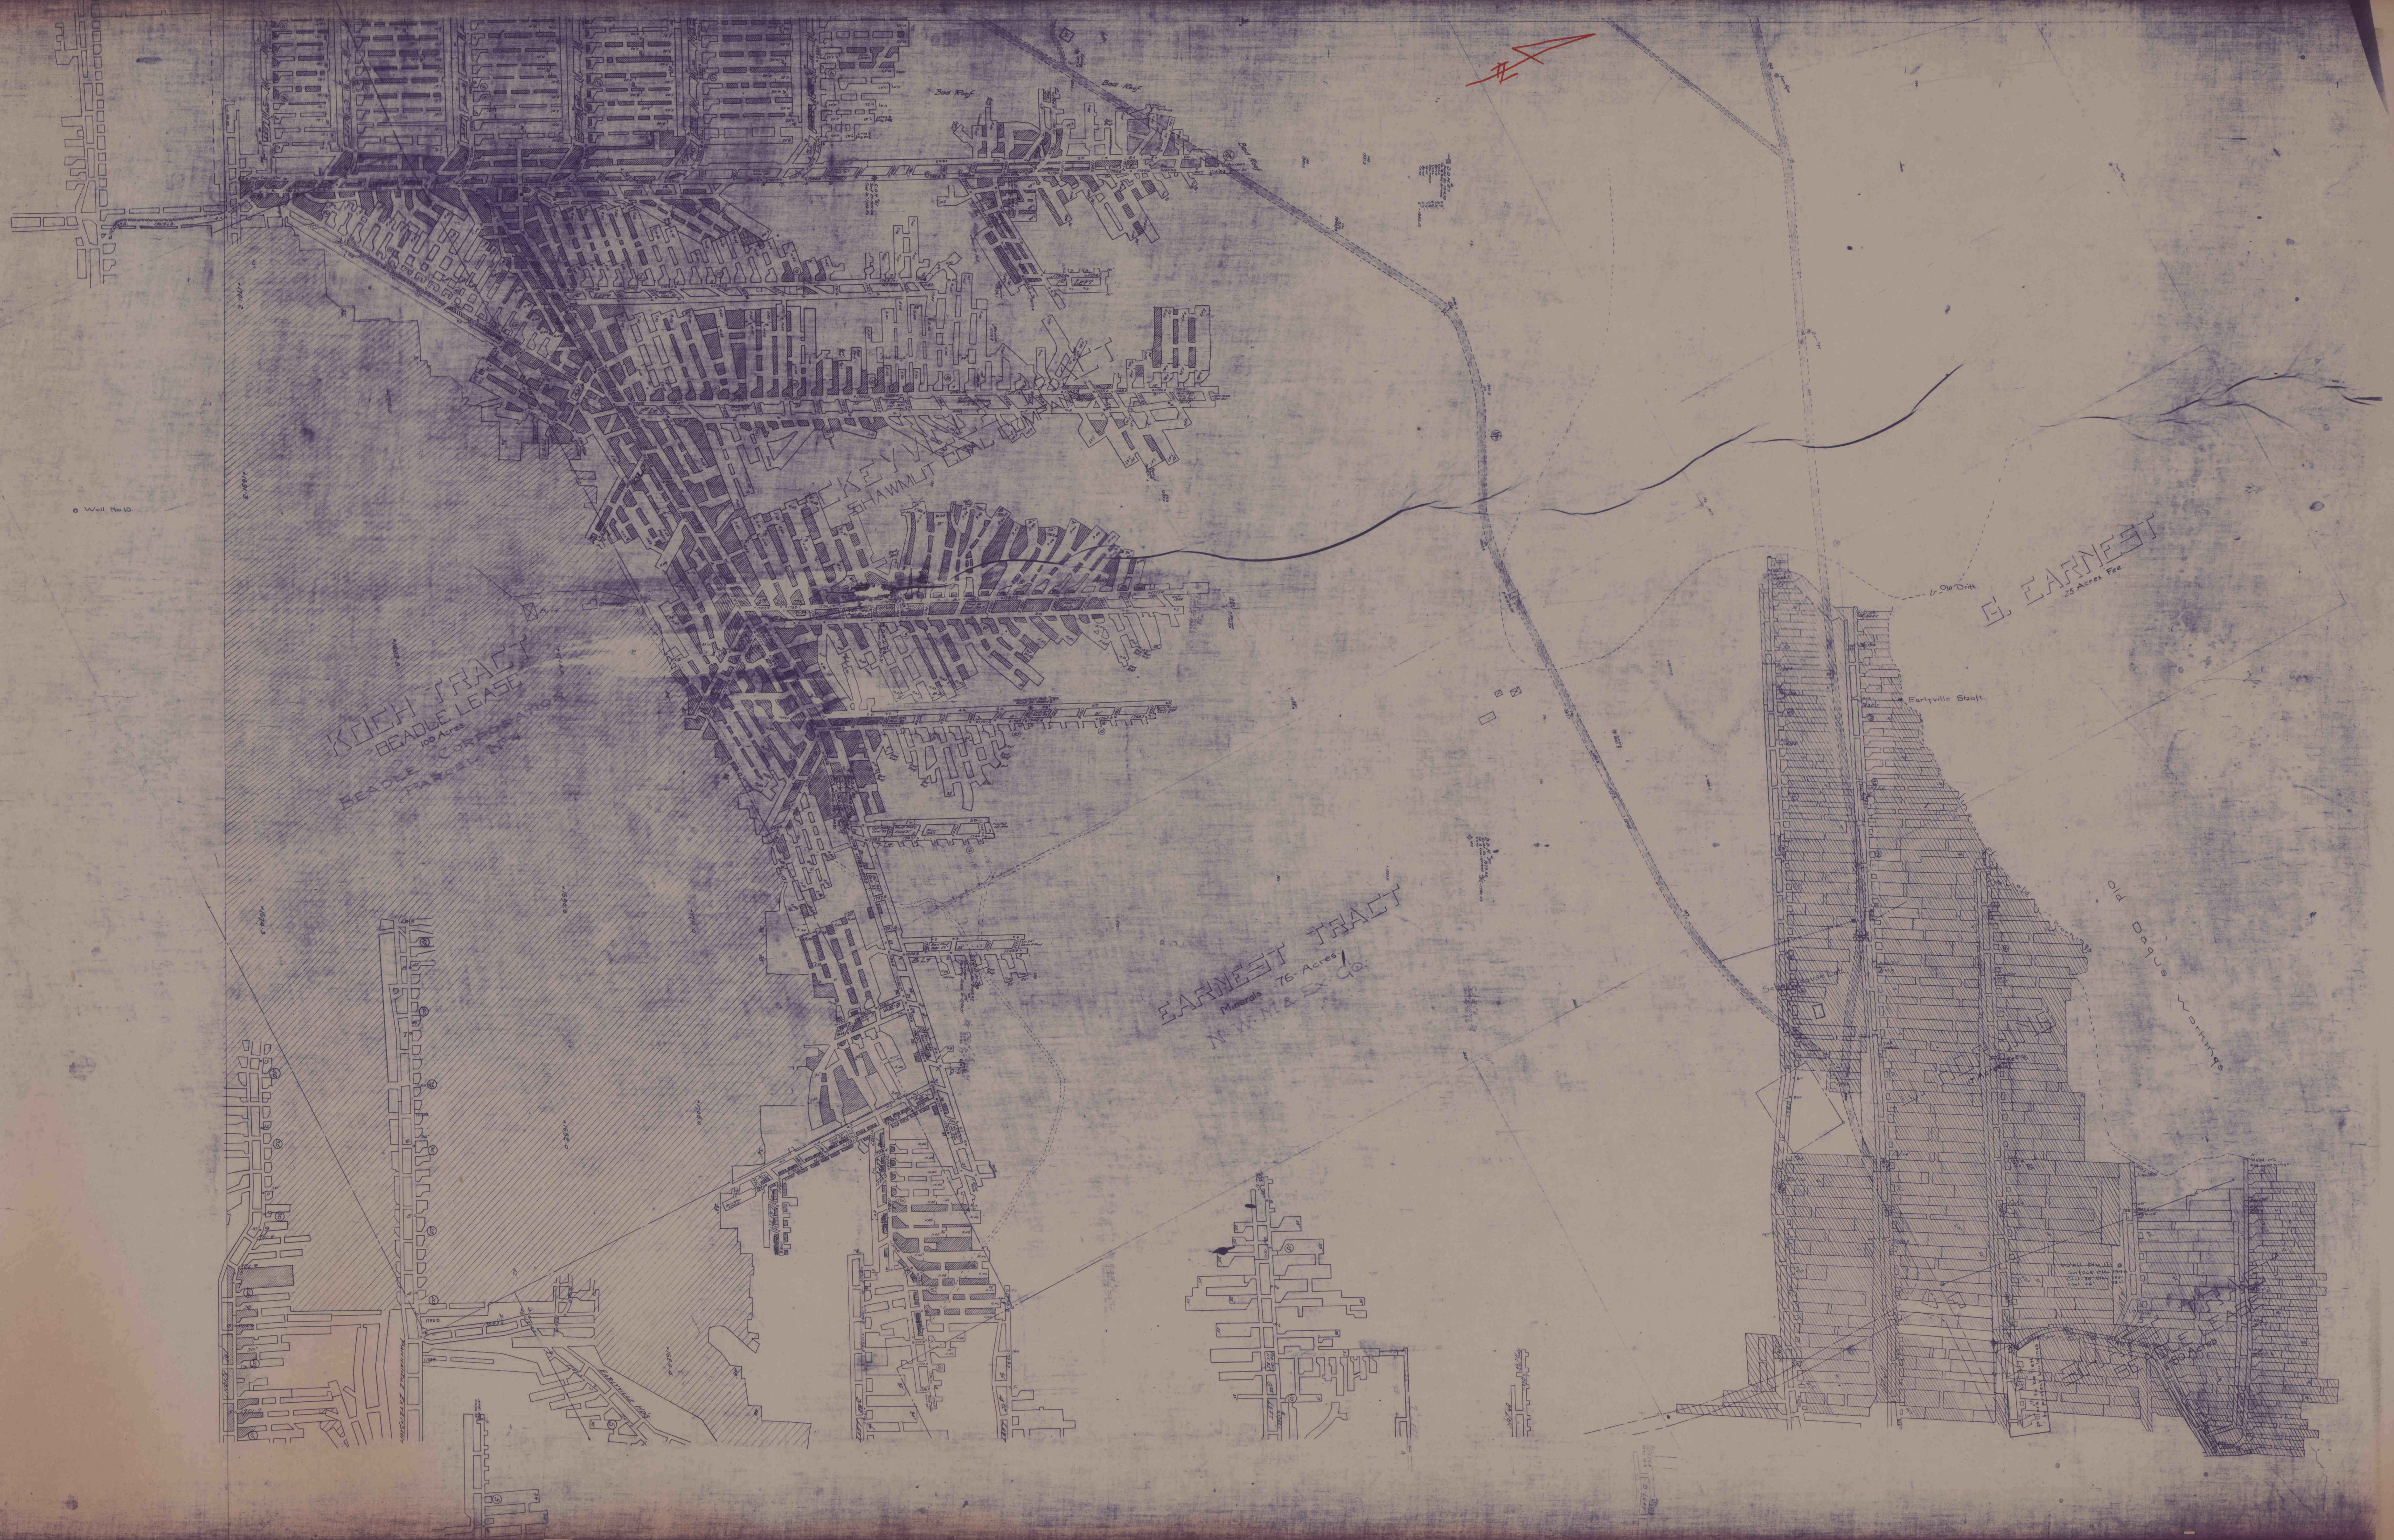

1880