


Warrant 2434
Leased from Elk Co. Mining Co.
for 100 Years

4422
Do not own

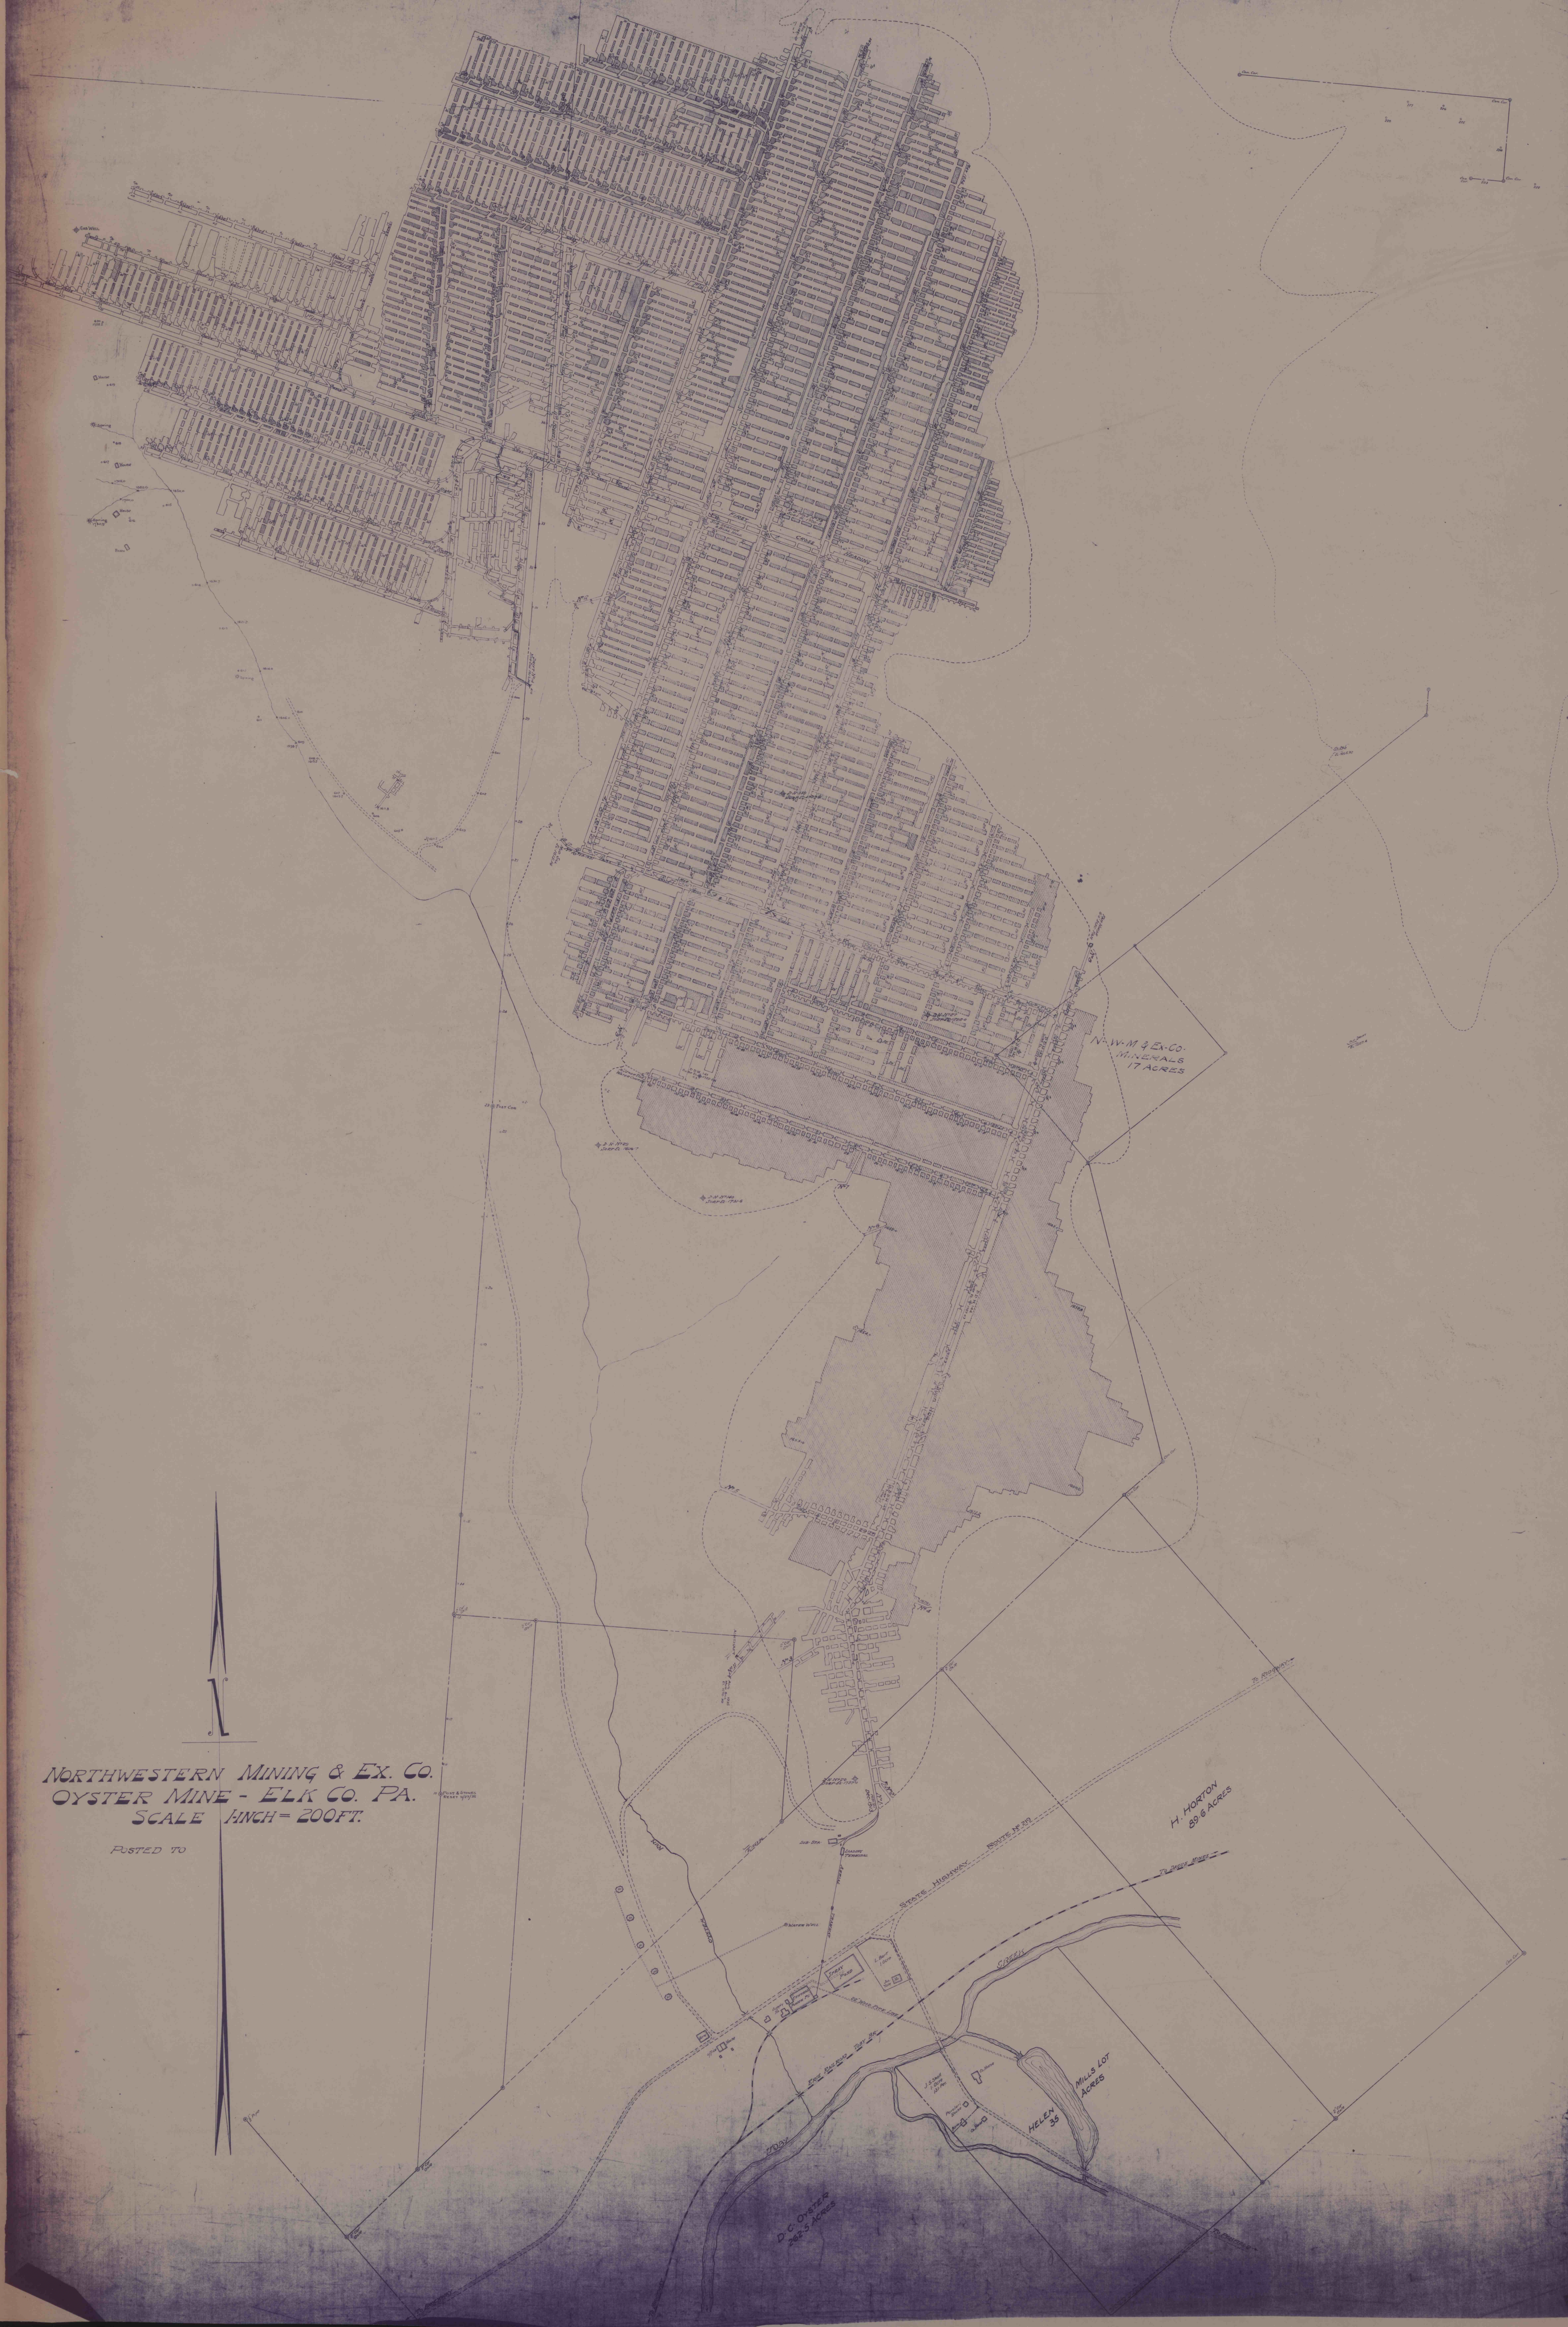

NORTHWESTERN MINING & EX. CO.
OYSTER MINE - ELK CO. PA.
SCALE 1 INCH = 200 FT.

POSTED TO