


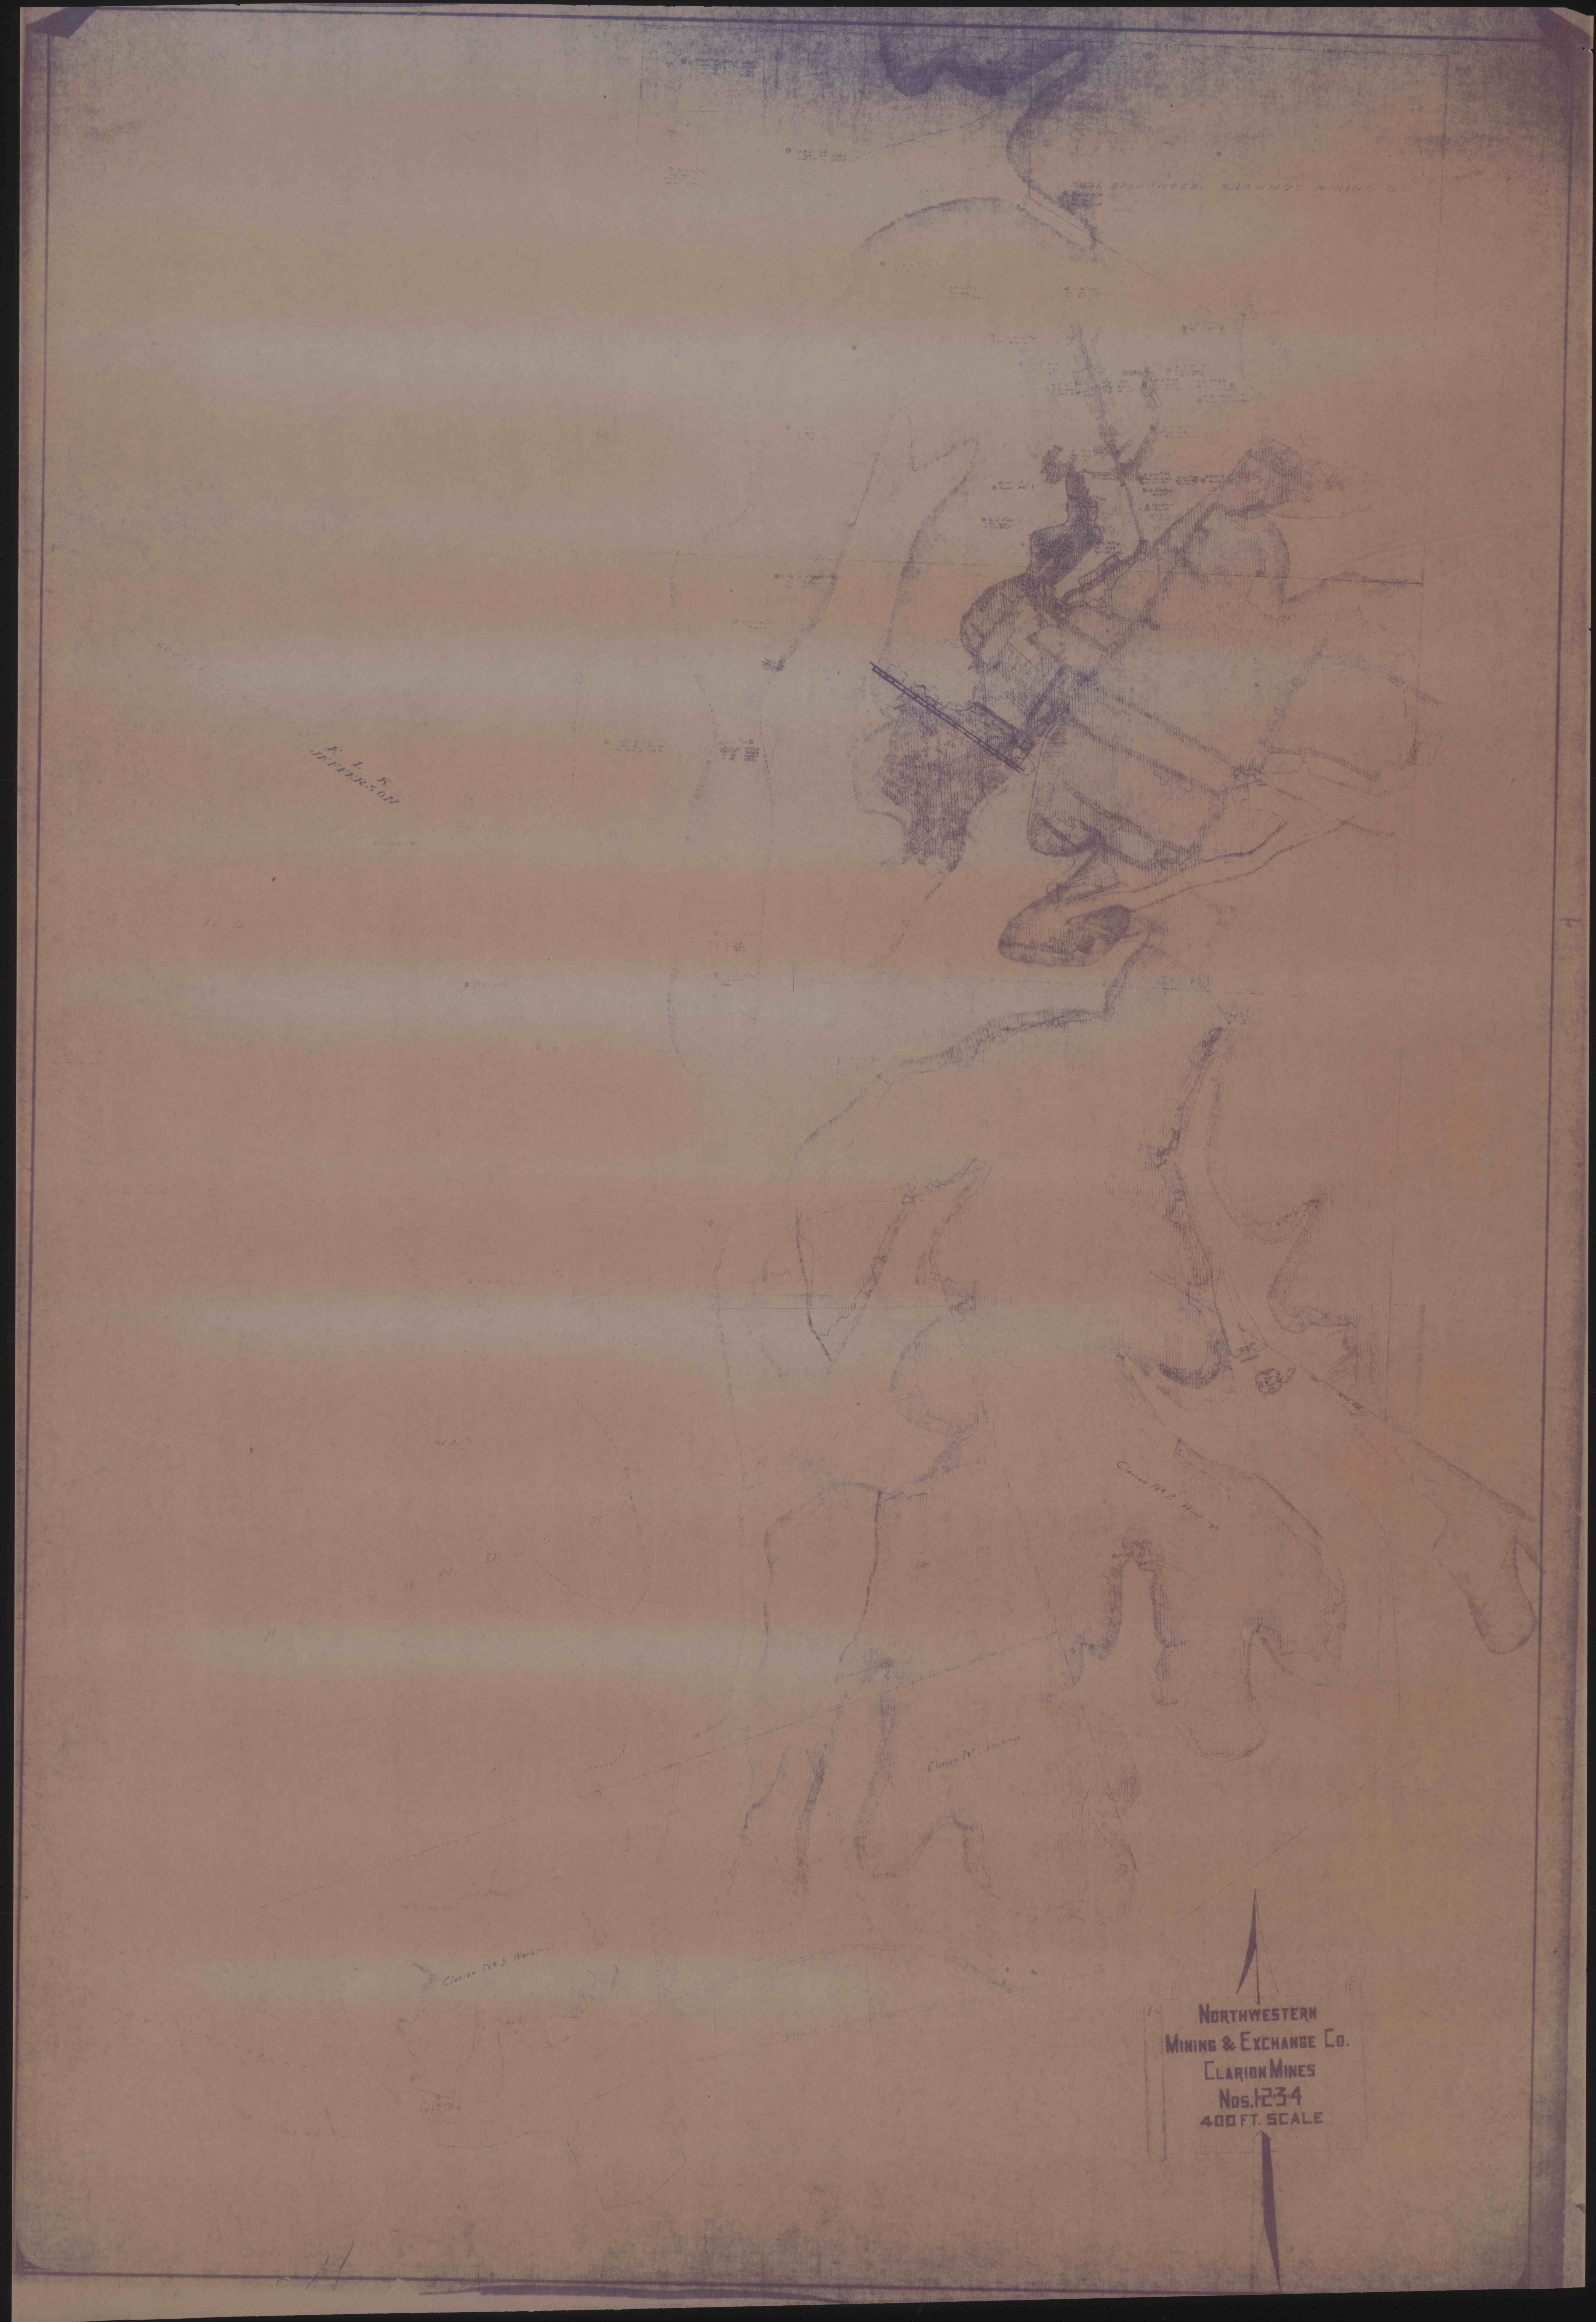

NORTHWESTERN  
MINING & EXCHANGE CO.  
Nos. 1234  
400 FT. SCALE