


C8C34-6

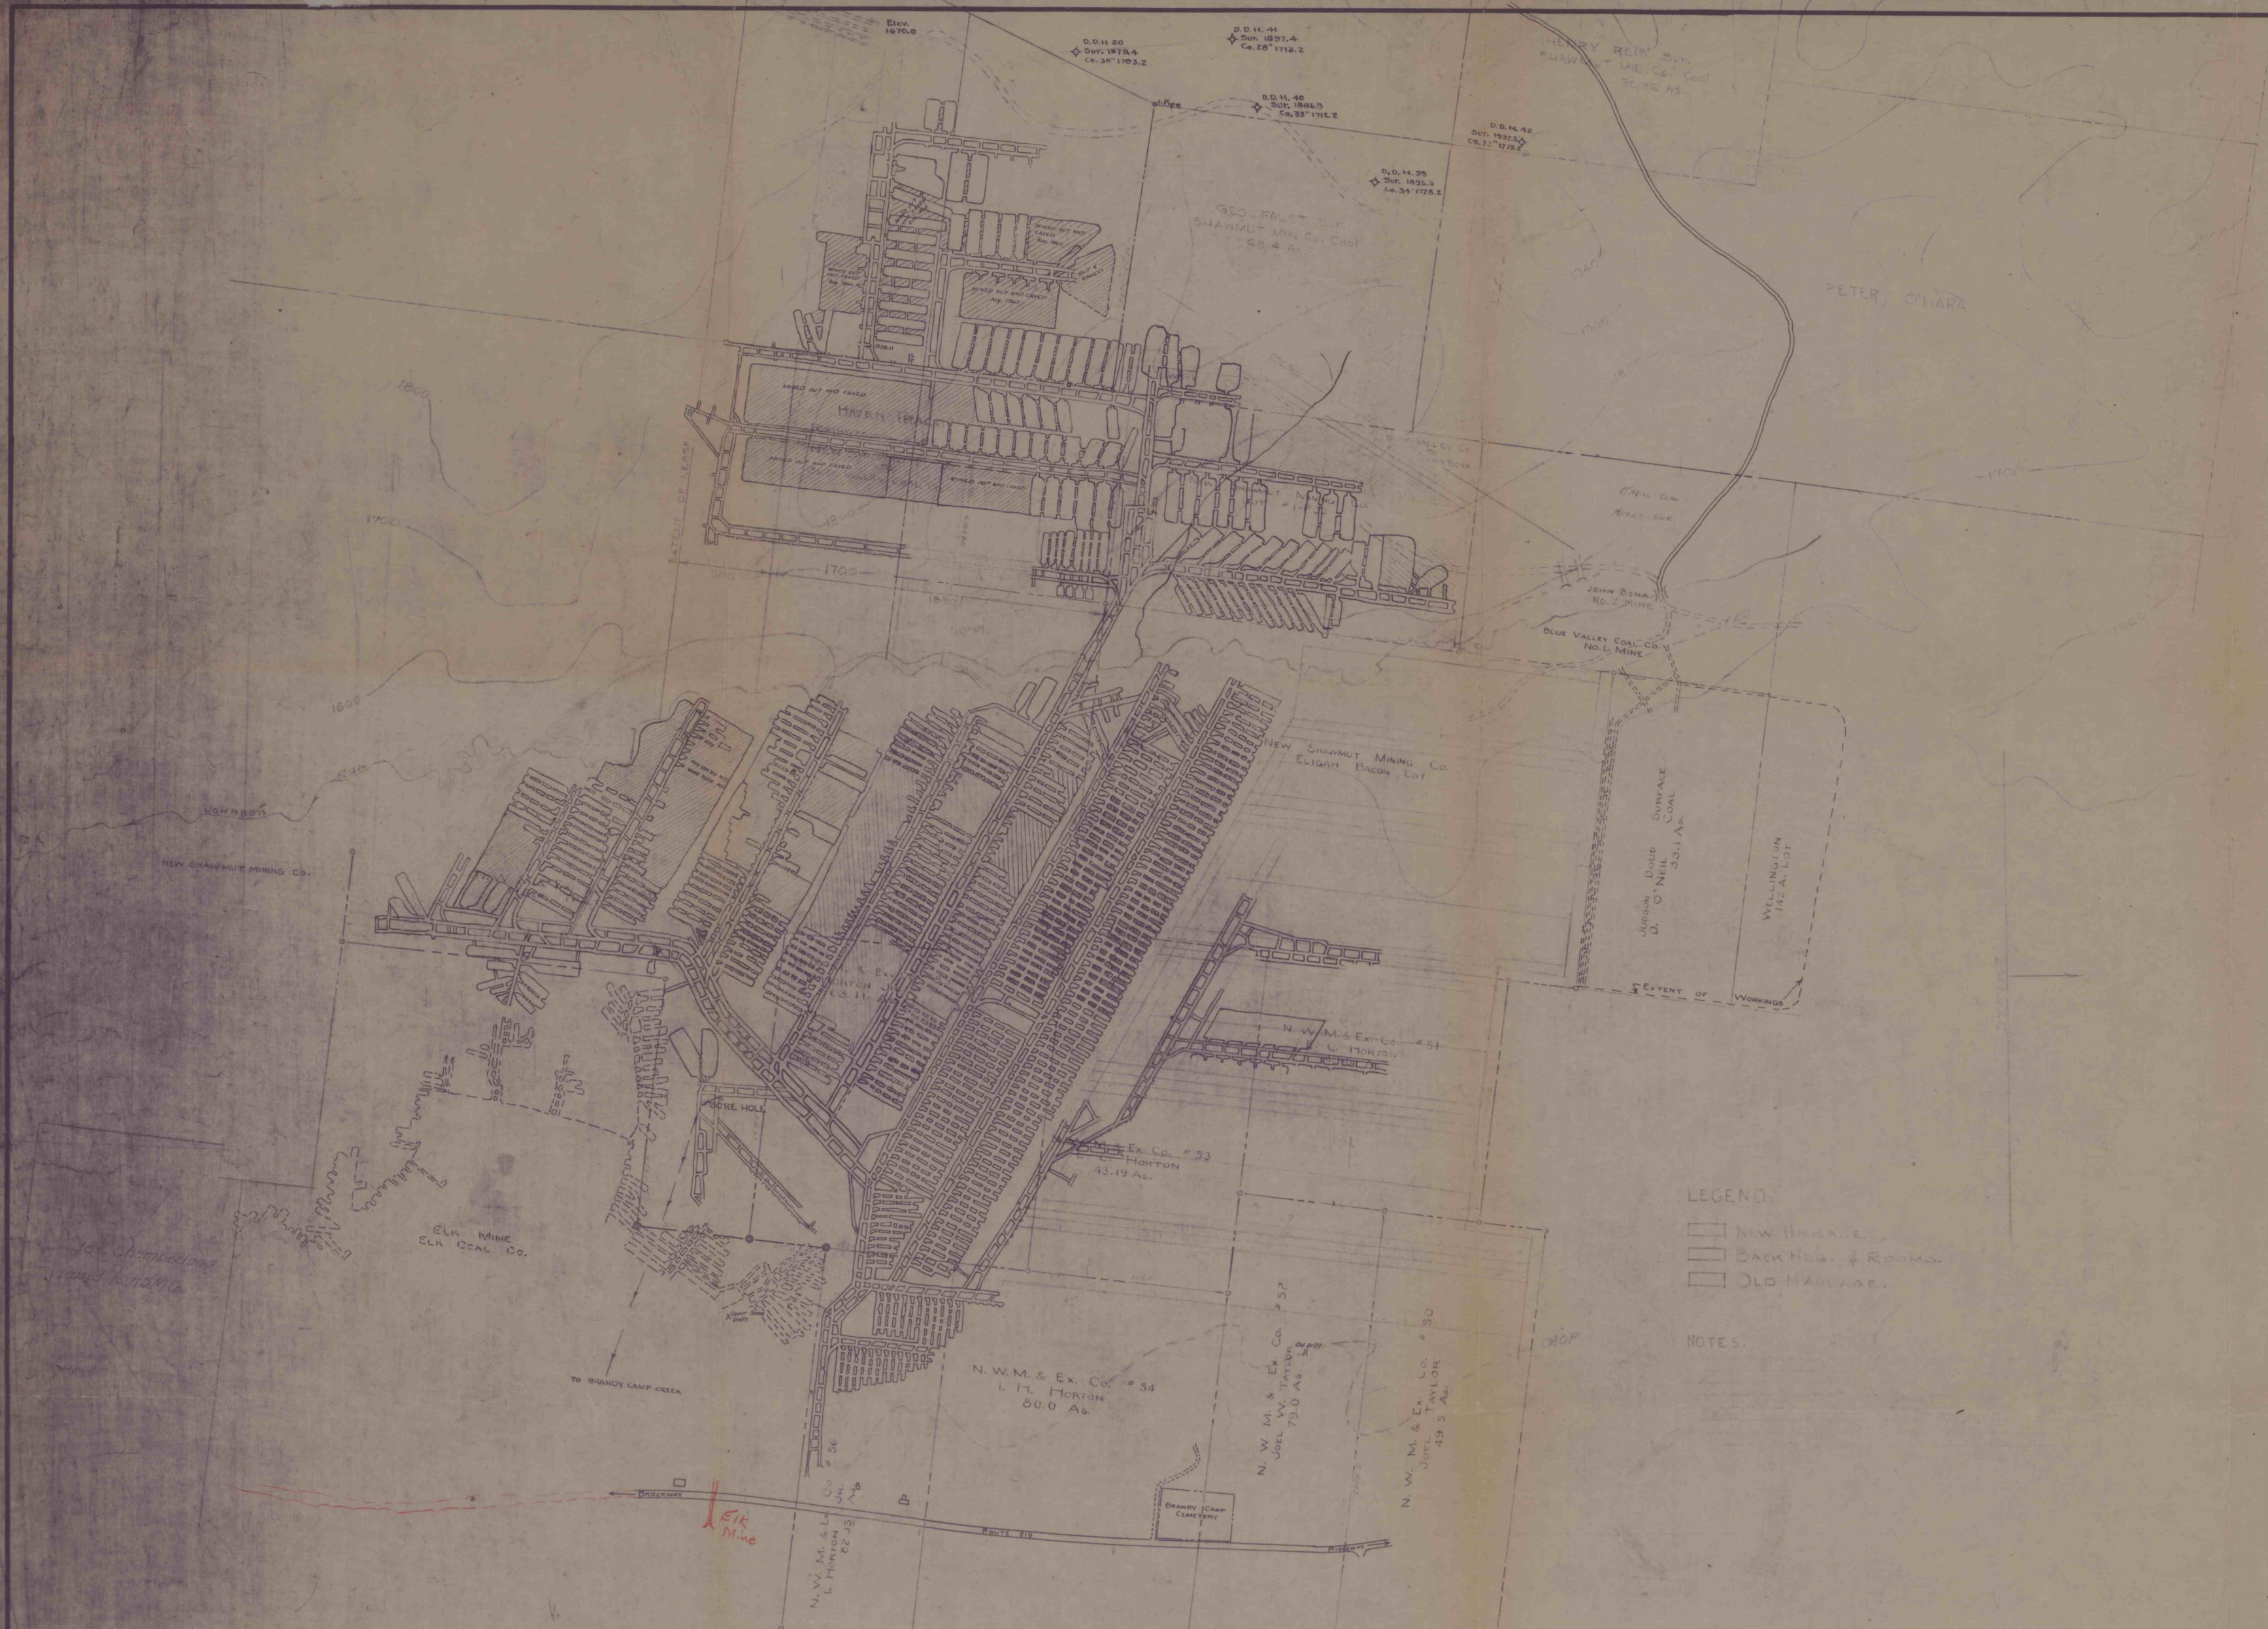

BLUE VALLEY COAL CO.
URMAN BROTHERS
RIDGEWAY, PA.
Coal Mine Operations at
Brandy Camp, Horton Twp., Elk Co., Pa.
Scale: 1" = 400' Jan. 21, 1947
Yost, Bromfield & Hess, ENGRS.
Du Bois, PA. CLEARFIELD, PA.

TO DATE AS OF
JANUARY 13, 1952
FEBRUARY 11, 1956
OCT. 6, 1957
JANUARY 5, 1961