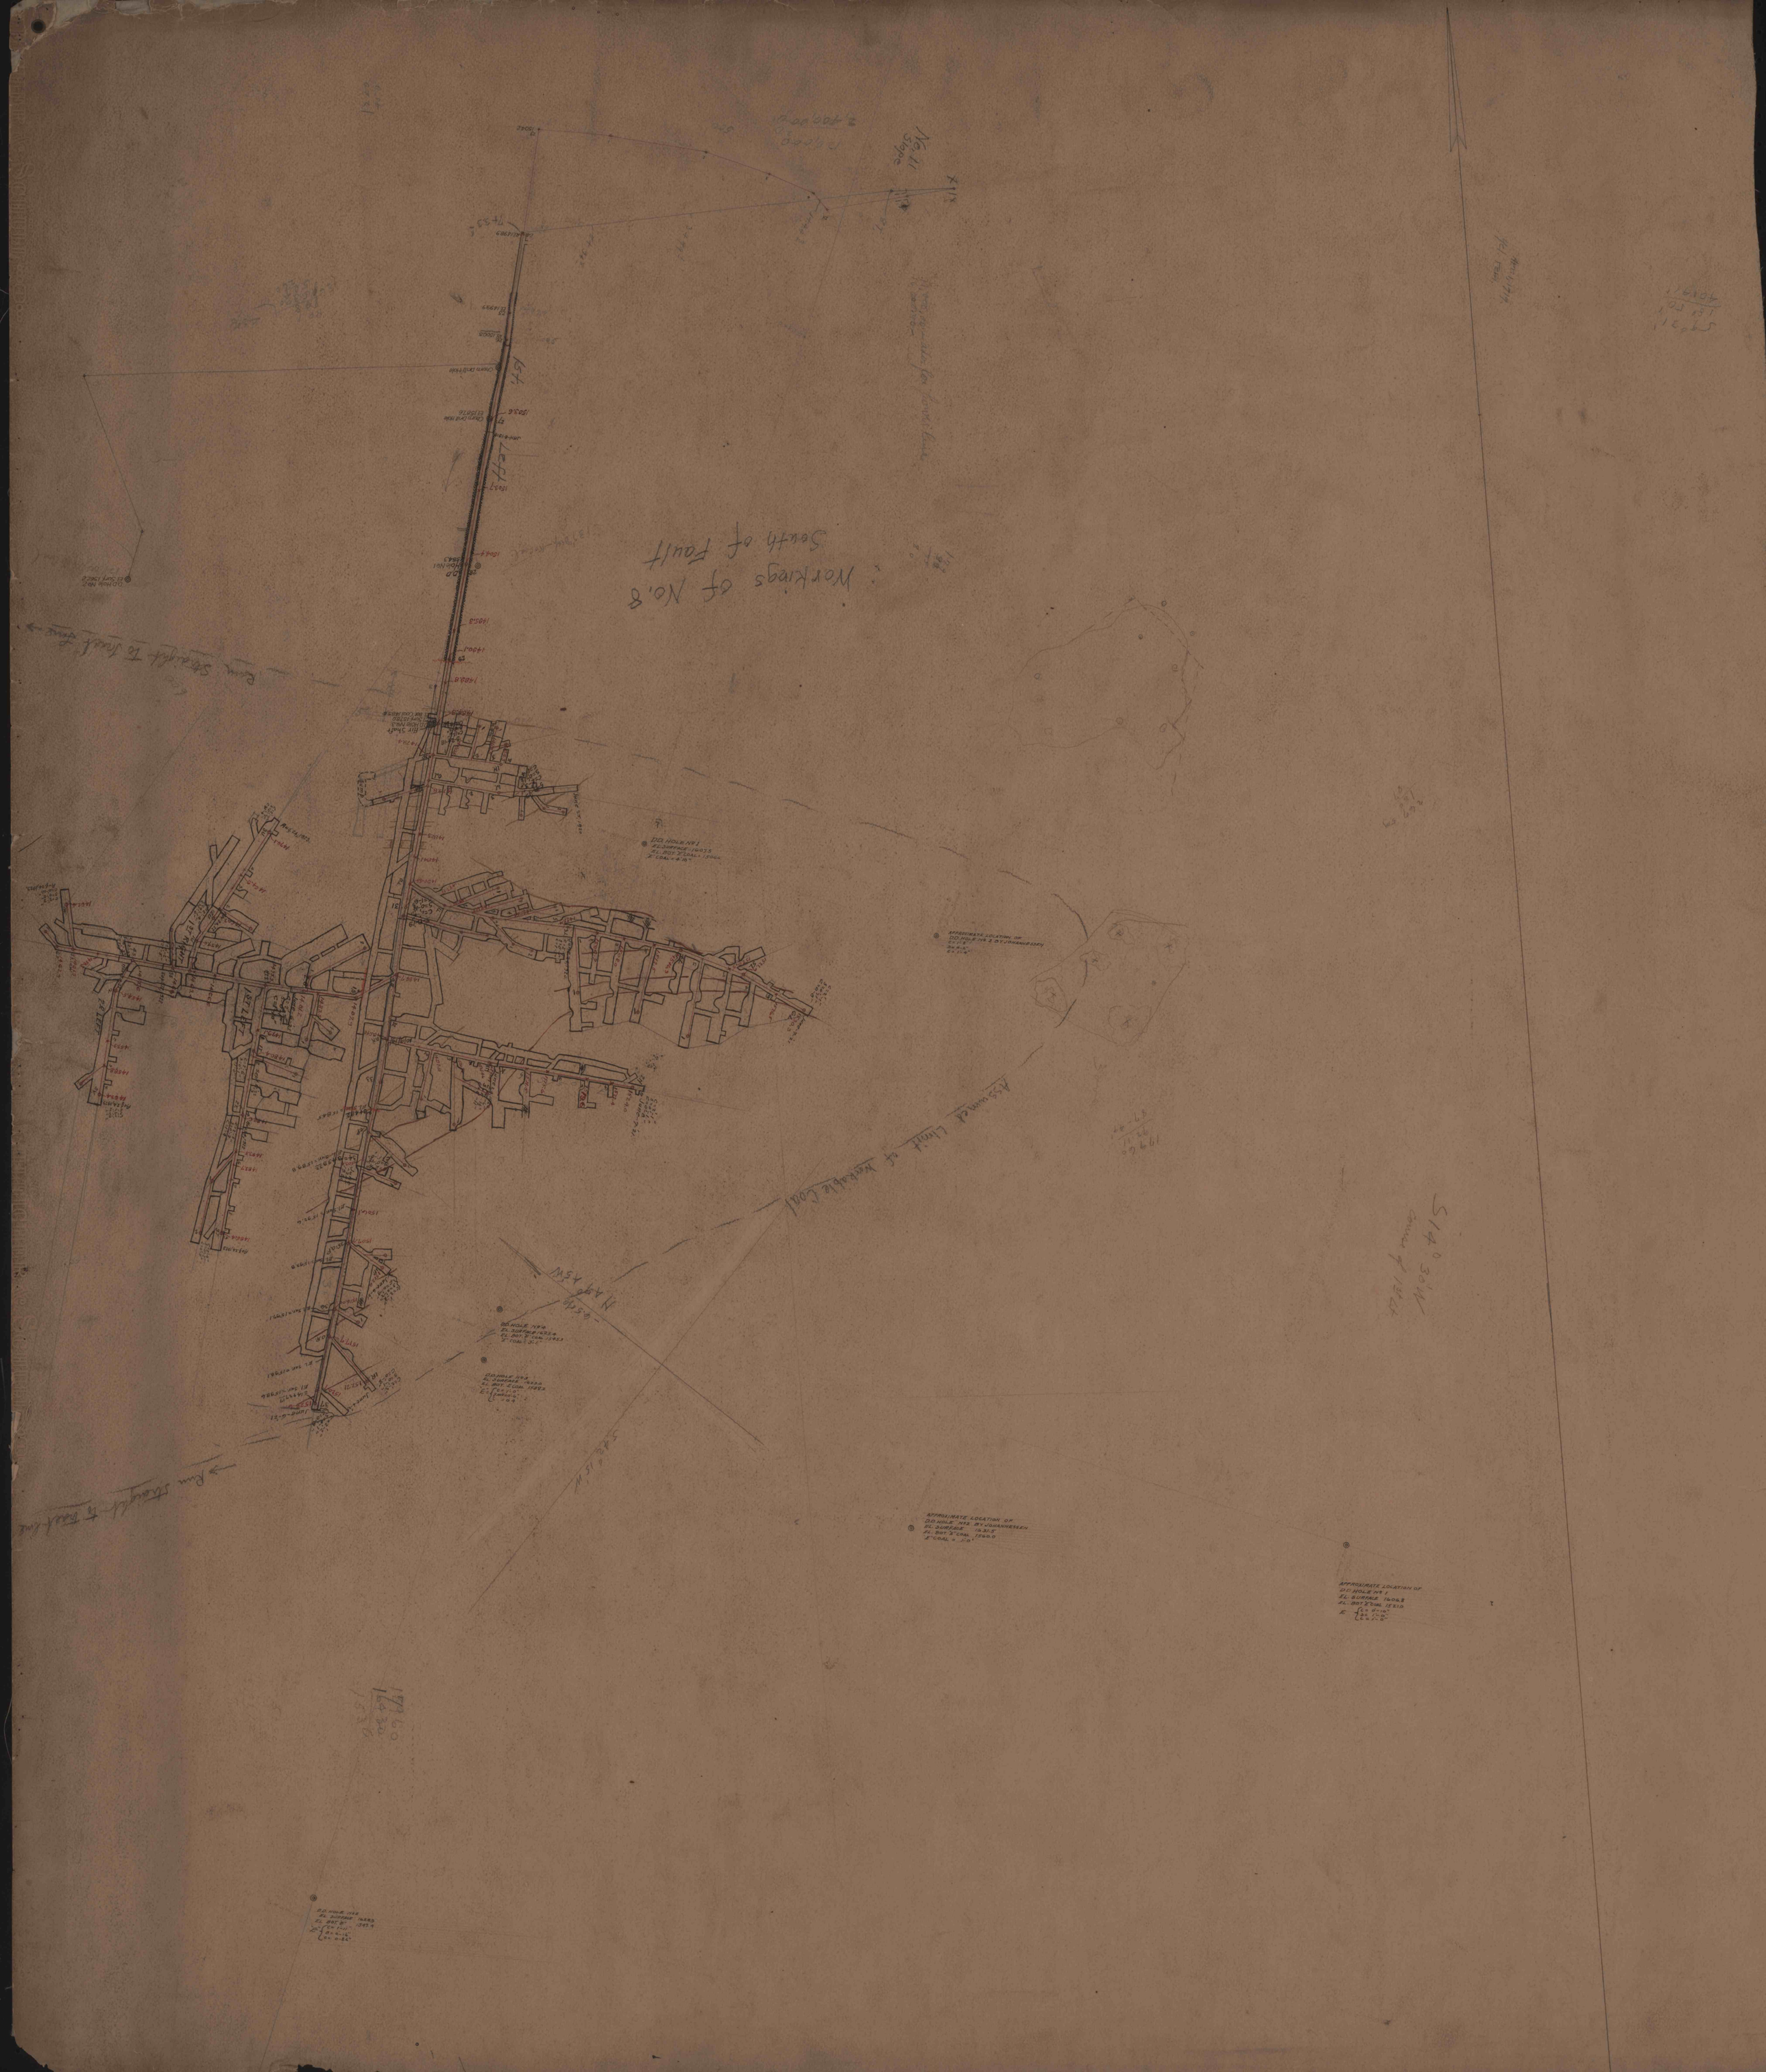
Workings of No.8
South of Fault
Assumed Limit of Workable Coal
Run Strength & Fault Line
Run Strength & Fault Line
D.D. HOLE No 1
D.D. HOLE No 2
D.D. HOLE No 3
D.D. HOLE No 4
D.D. HOLE No 5
APPROXIMATE LOCATION OF
D.D. HOLE No 1
EL. SURFACE 1460.8
EL. BOT 2' COAL 1210.0
APPROXIMATE LOCATION OF
D.D. HOLE No 2 BY JOHANNESSEN
EL. SURFACE 1631.5
EL. BOT 2' COAL 1320.0
APPROXIMATE LOCATION OF
D.D. HOLE No 3 BY JOHANNESSEN
D.D. HOLE No 4
EL. SURFACE 1460.8
EL. BOT 2' COAL 1347.4
Dip Strength & Fault Line
Dip Strength & Fault Line
No. 11 Slope
No. 8 Slope
Air Shaft
No. 1 Slope
No. 2 Slope
