


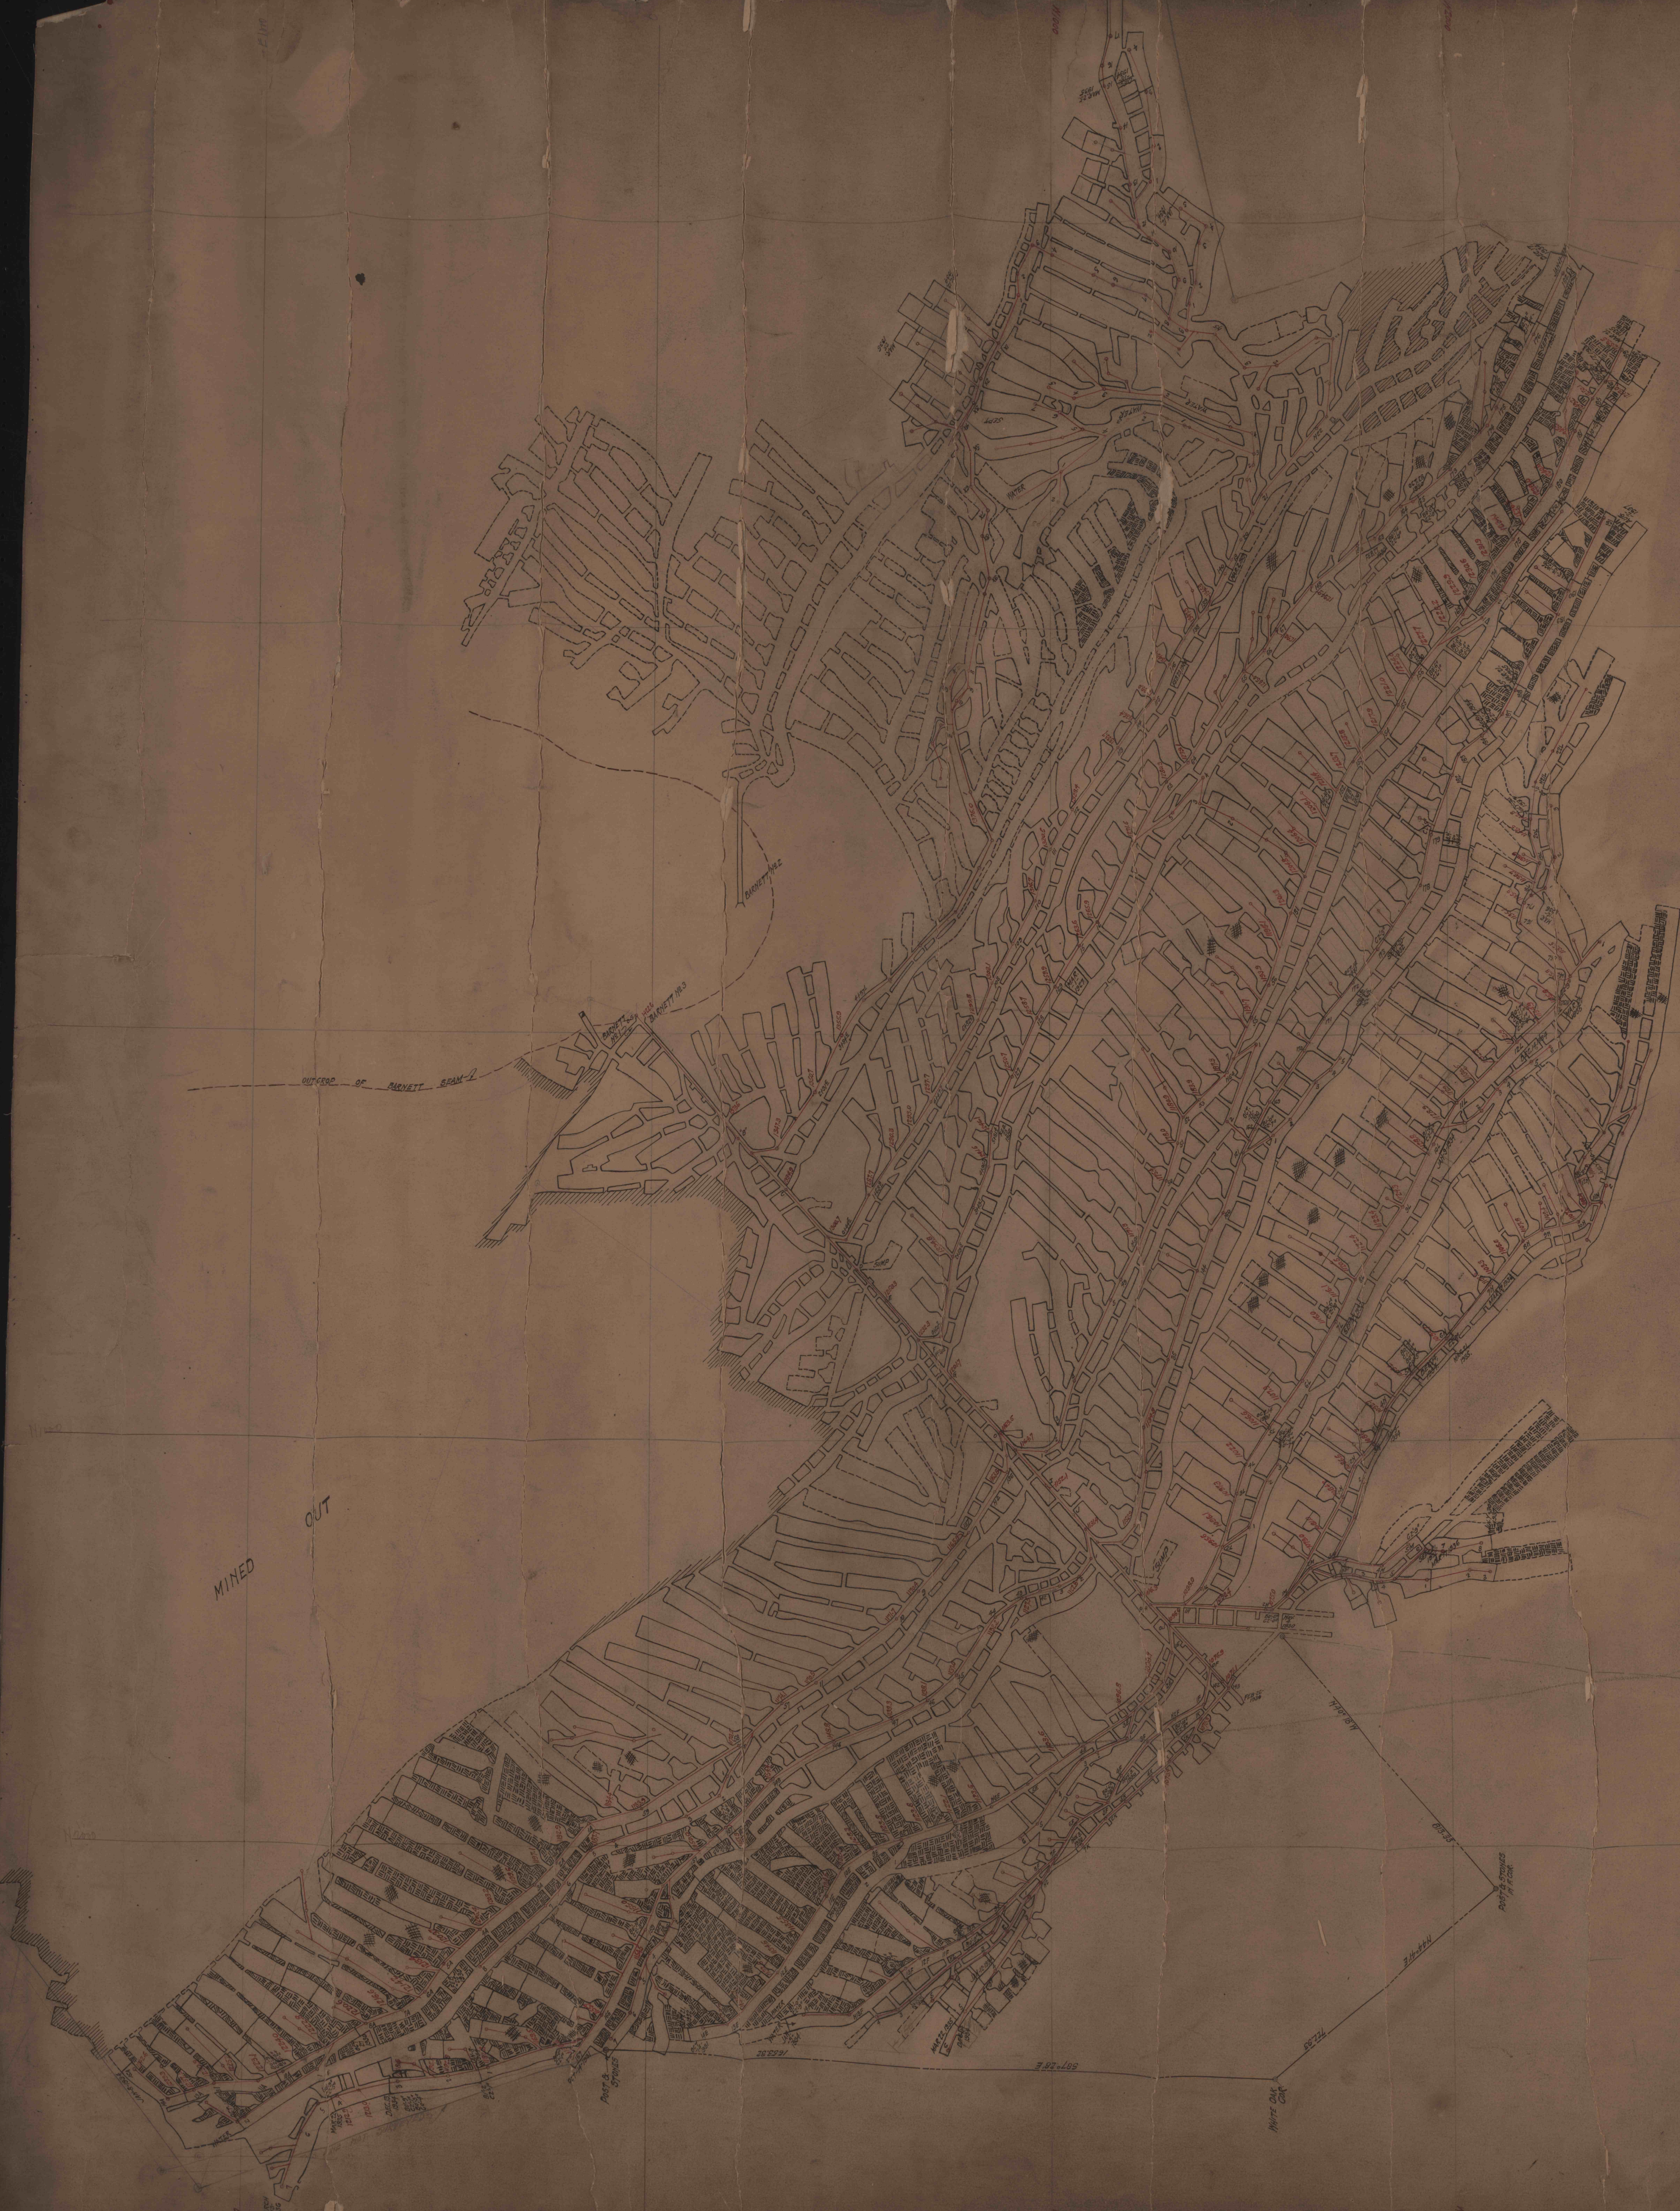

MINED
OUT

OUTLINE OF BARNETT SPAN-1





