


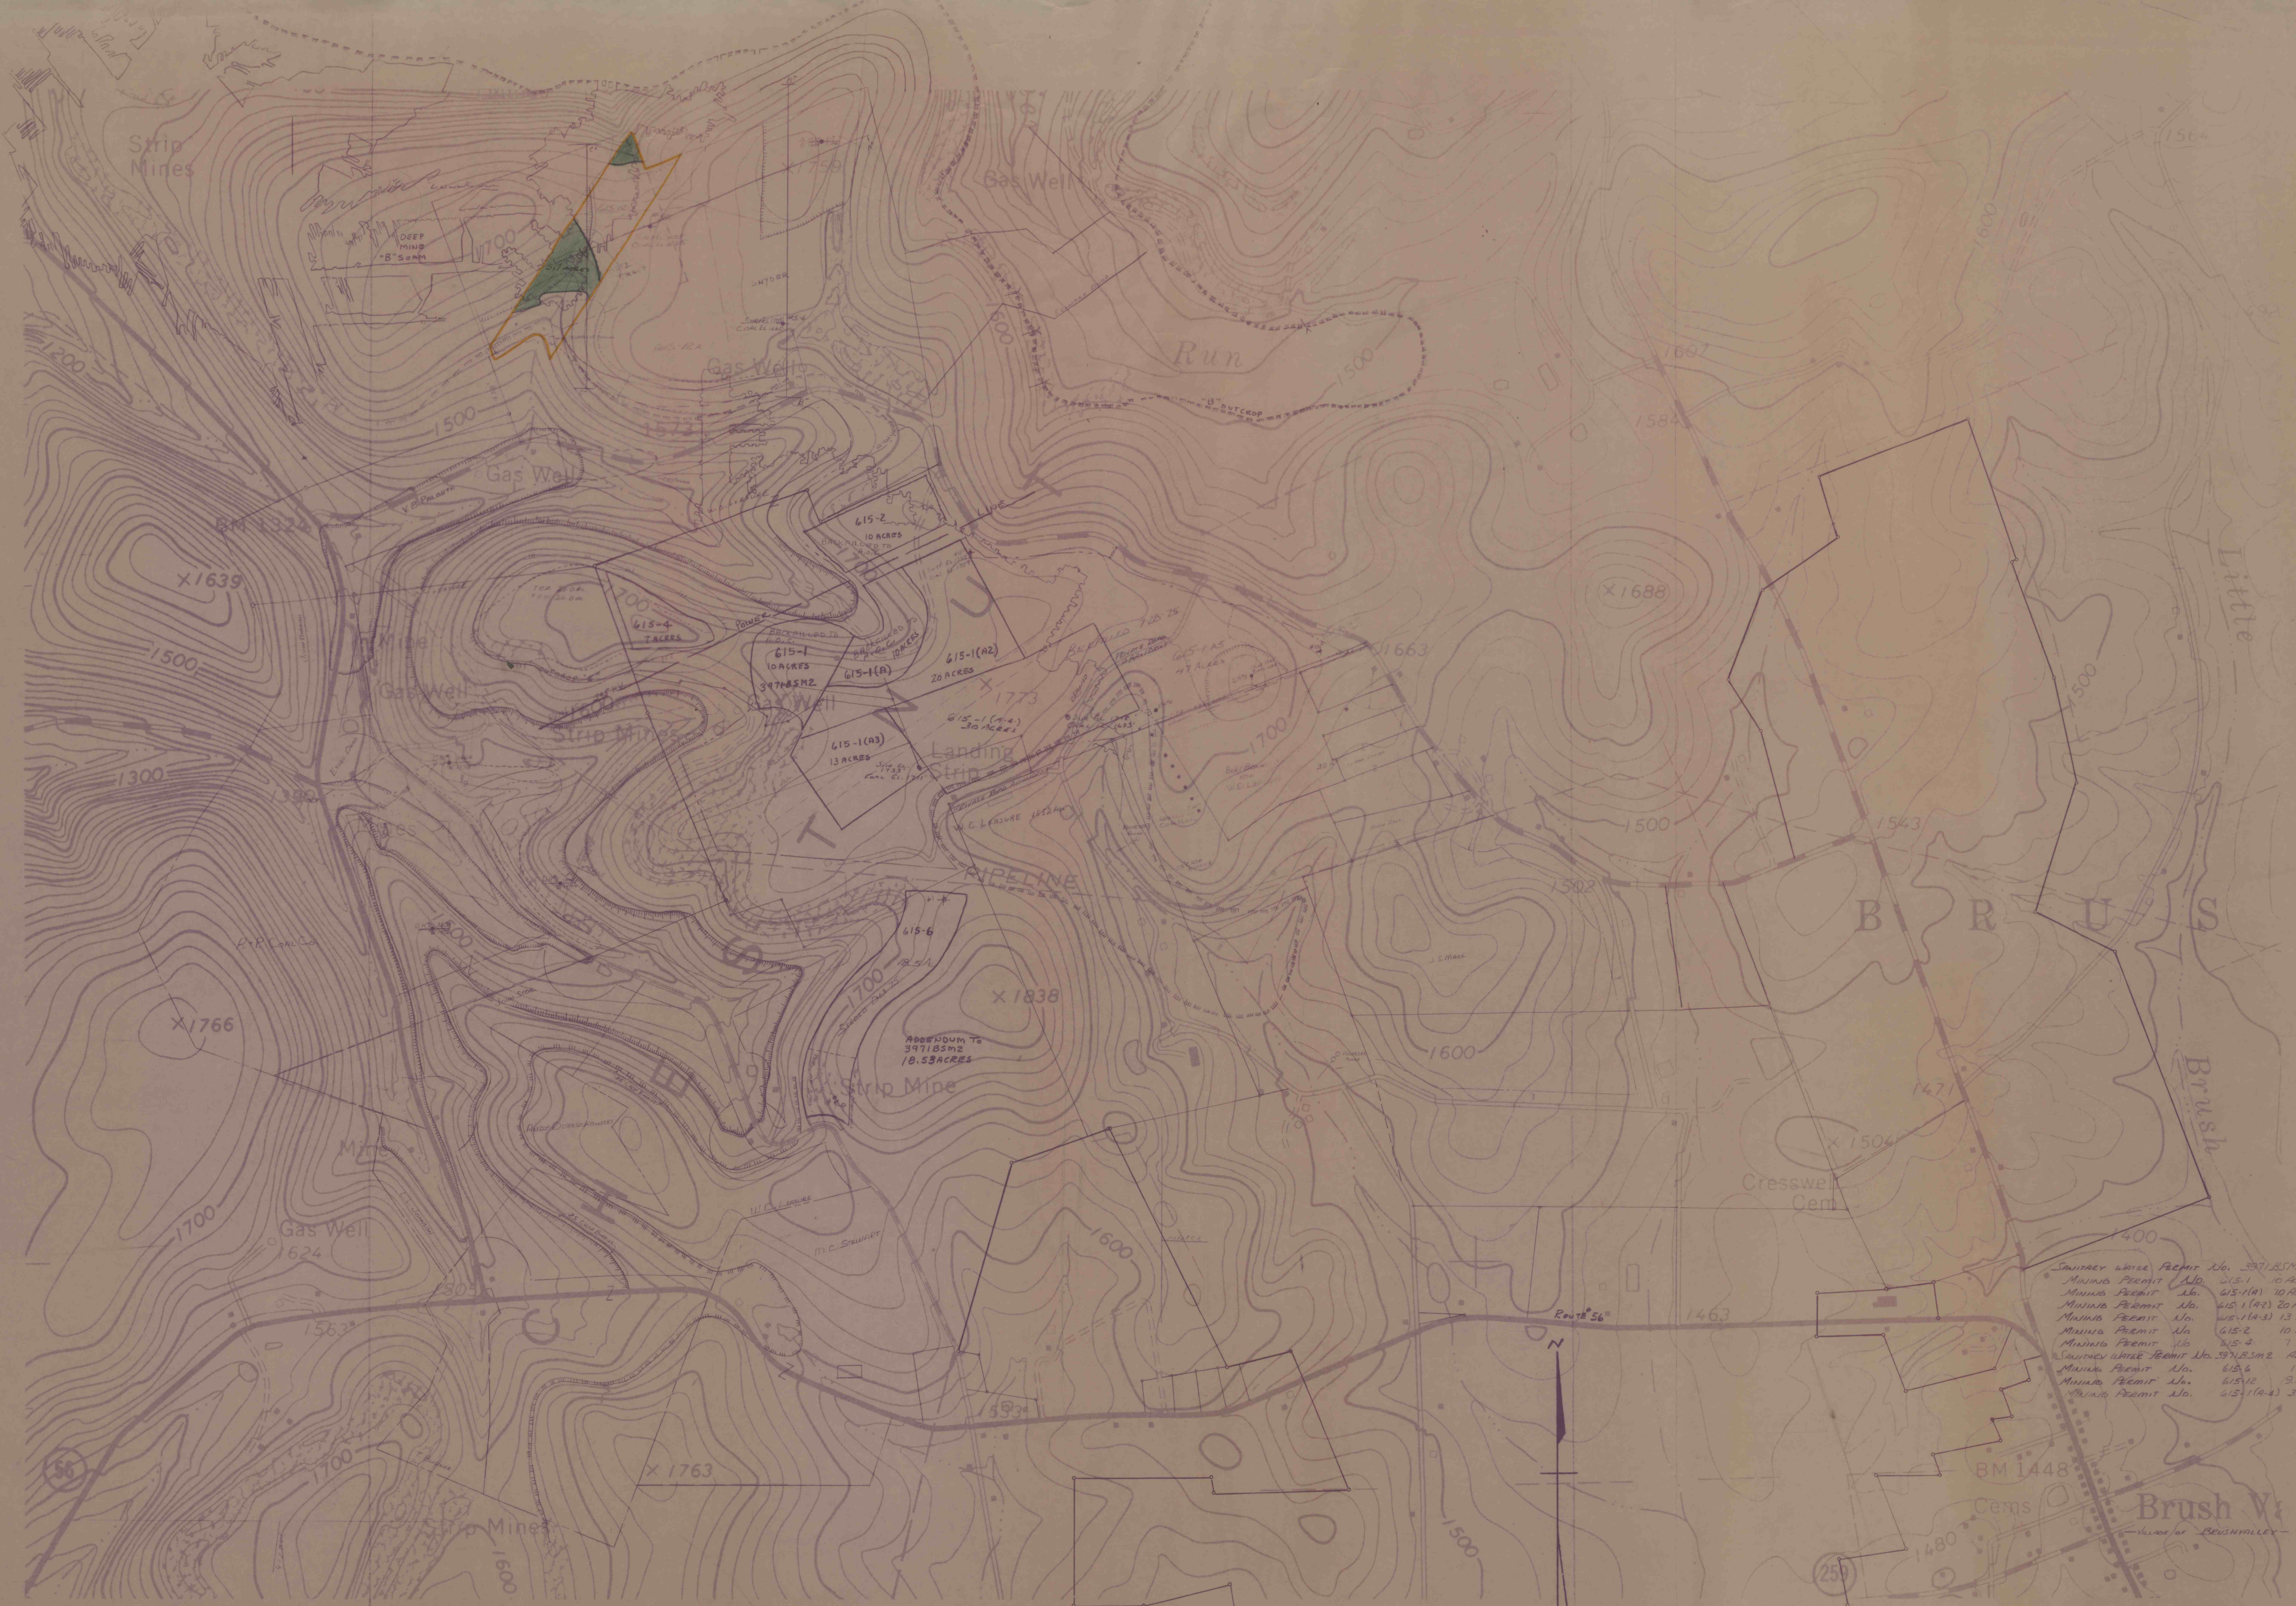

IMAPS # 20559

- | | | |
|-------------------|------------|------------------|
| Sandrey White | Permit No. | 397185M2 |
| Mining Permit No. | 615-1 | 10 ACRES |
| Mining Permit No. | 615-1(A) | 10 ACRES |
| Mining Permit No. | 615-1(A2) | 20 ACRES |
| Mining Permit No. | 615-1(A3) | 13 ACRES |
| Mining Permit No. | 615-2 | 10 ACRES |
| Mining Permit No. | 615-4 | 7 ACRES |
| Sandrey White | Permit No. | 397185M2 AMENDED |
| Mining Permit No. | 615-6 | 18.53 ACRES |
| Mining Permit No. | 615-1E | 31 ACRES |
| Mining Permit No. | 615-1(A-4) | 30 ACRES |

MINING OPERATIONS OF
OLD HOME MINING, INC.
LANDS OF
W.C. LEASURES
BRUSH VALLEY TWP INDIANA CO. IN.
JAN 26, 1973 SCALE 1"=400'
GEORGE R. JONES, JR. RE. #4234
JUNIOR CITY, IN.