


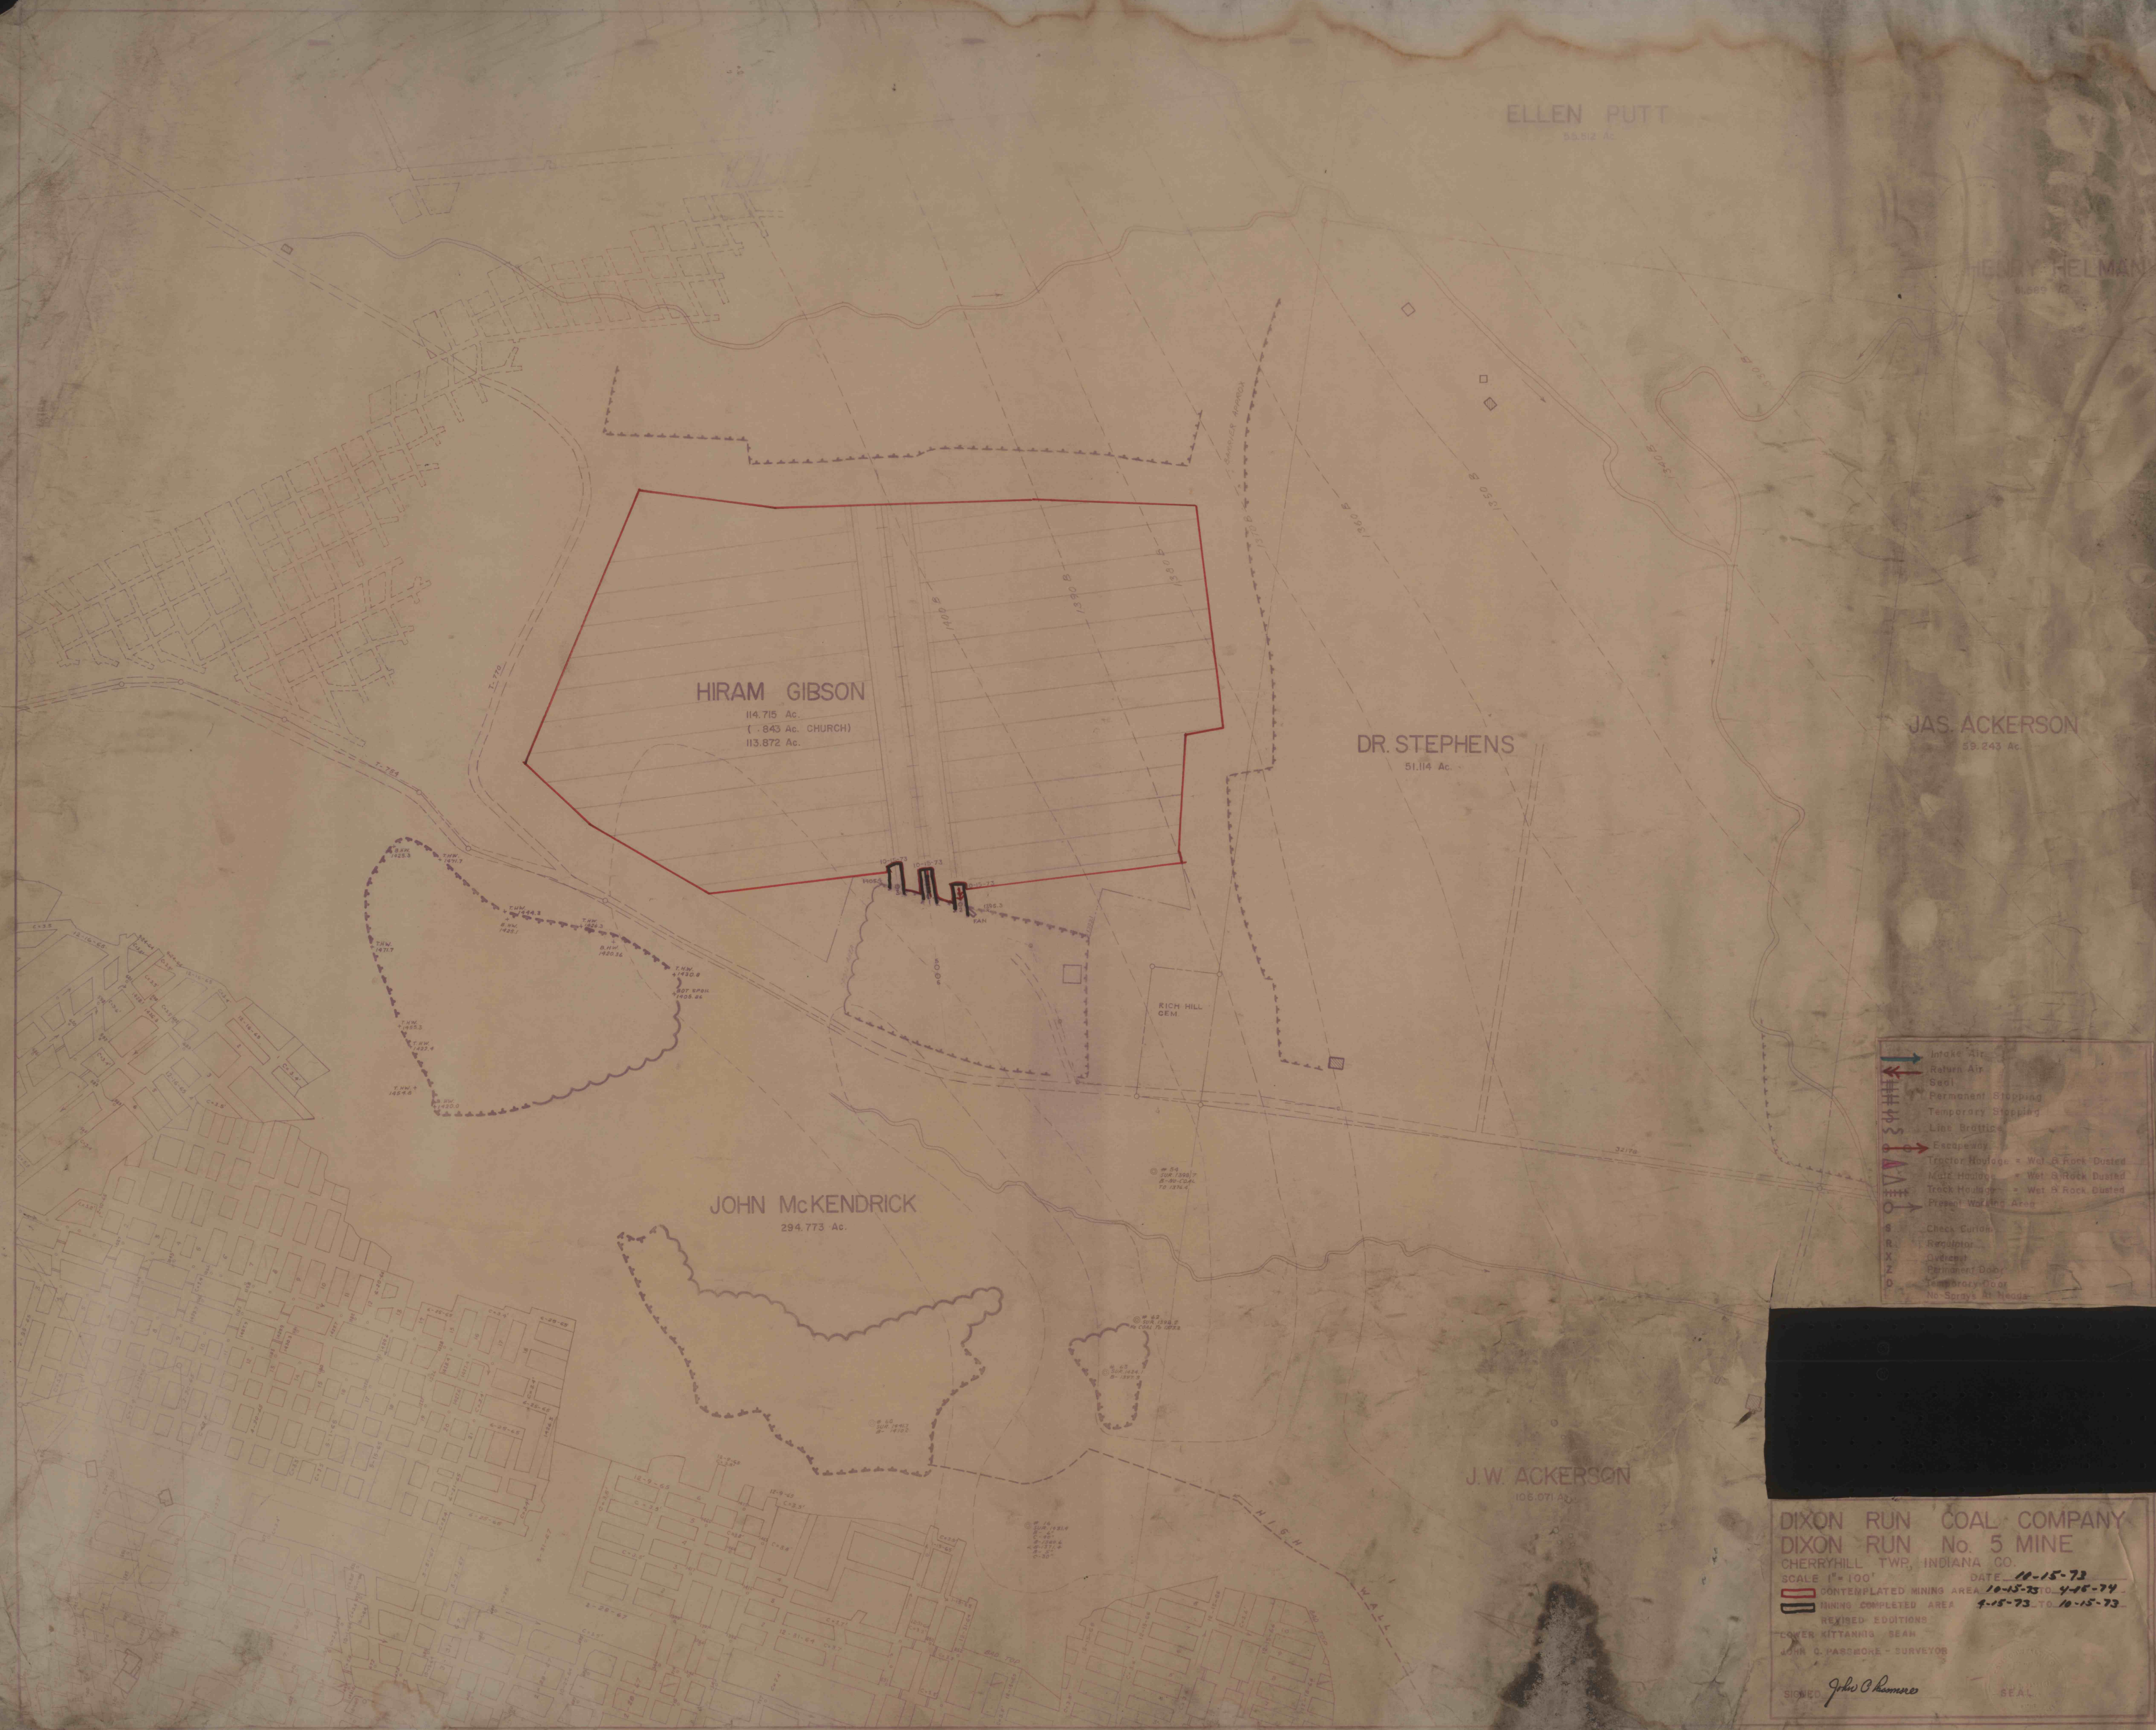

ELLEN PUTT
56.817 Ac.

HENRY HELMAN
8.669 Ac.

HIRAM GIBSON

114.715 Ac.
(.843 Ac. CHURCH)
113.872 Ac.

DR. STEPHENS

51.114 Ac.

JAS. ACKERSON

59.243 Ac.

JOHN MCKENDRICK

294.773 Ac.

J.W. ACKERSON

108.071 Ac.

- Intake Air
- Return Air
- Seal
- Permanent Stopping
- Temporary Stopping
- Line Bittles
- Escapeway
- Tractor House - Wet & Rock Dusted
- Wet House - Wet & Rock Dusted
- Truck House - Wet & Rock Dusted
- Project Working Area
- Check Curian
- Regulator
- Cylinder
- Permanent Door
- Temporary Door
- No Sprays at Heads

DIXON RUN COAL COMPANY
DIXON RUN No. 5 MINE
CHERRY HILL TWP, INDIANA CO.
SCALE 1"=100' DATE 10-15-73
CONTINGENT MINING AREA 10-15-73 TO 4-15-74
MINING COMPLETED AREA 4-15-73 TO 10-15-73
REVISED EDITIONS
LOVER KITTANNIS SEAN
JOHN C. PASMORE - SURVEYOR

SIGNED *John C. Pasmore*

SEAL