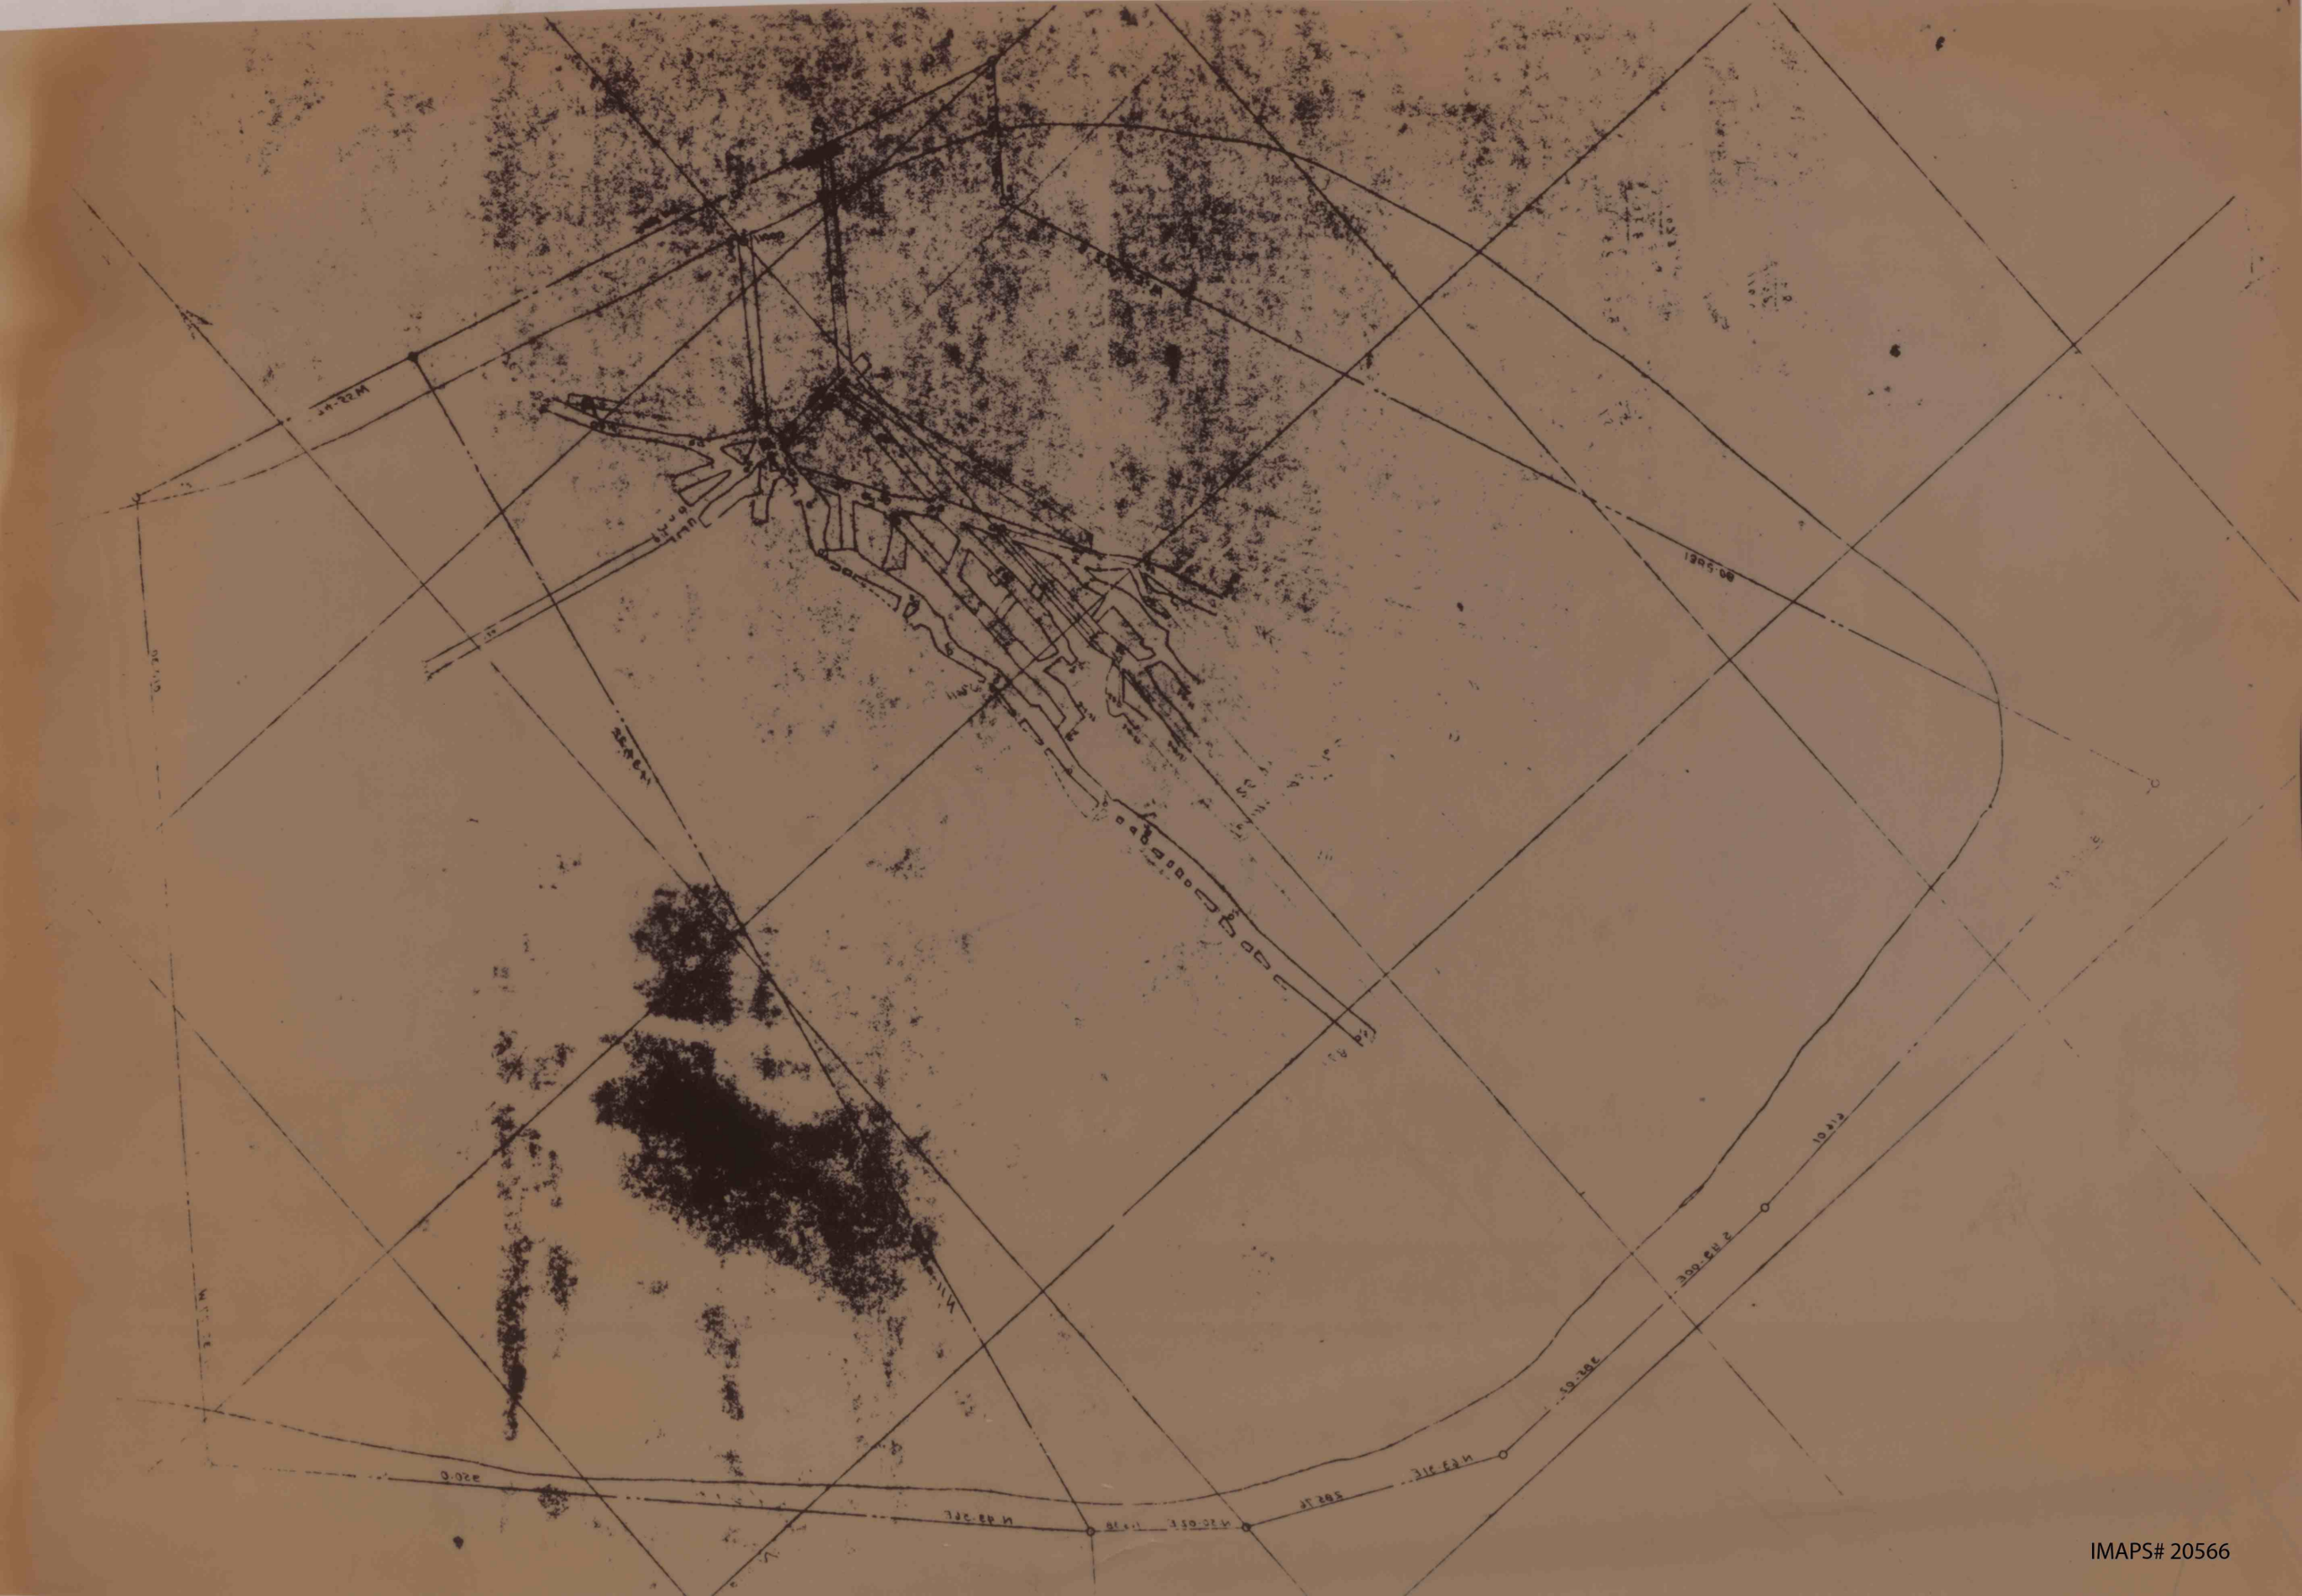

IMAPS# 20566