


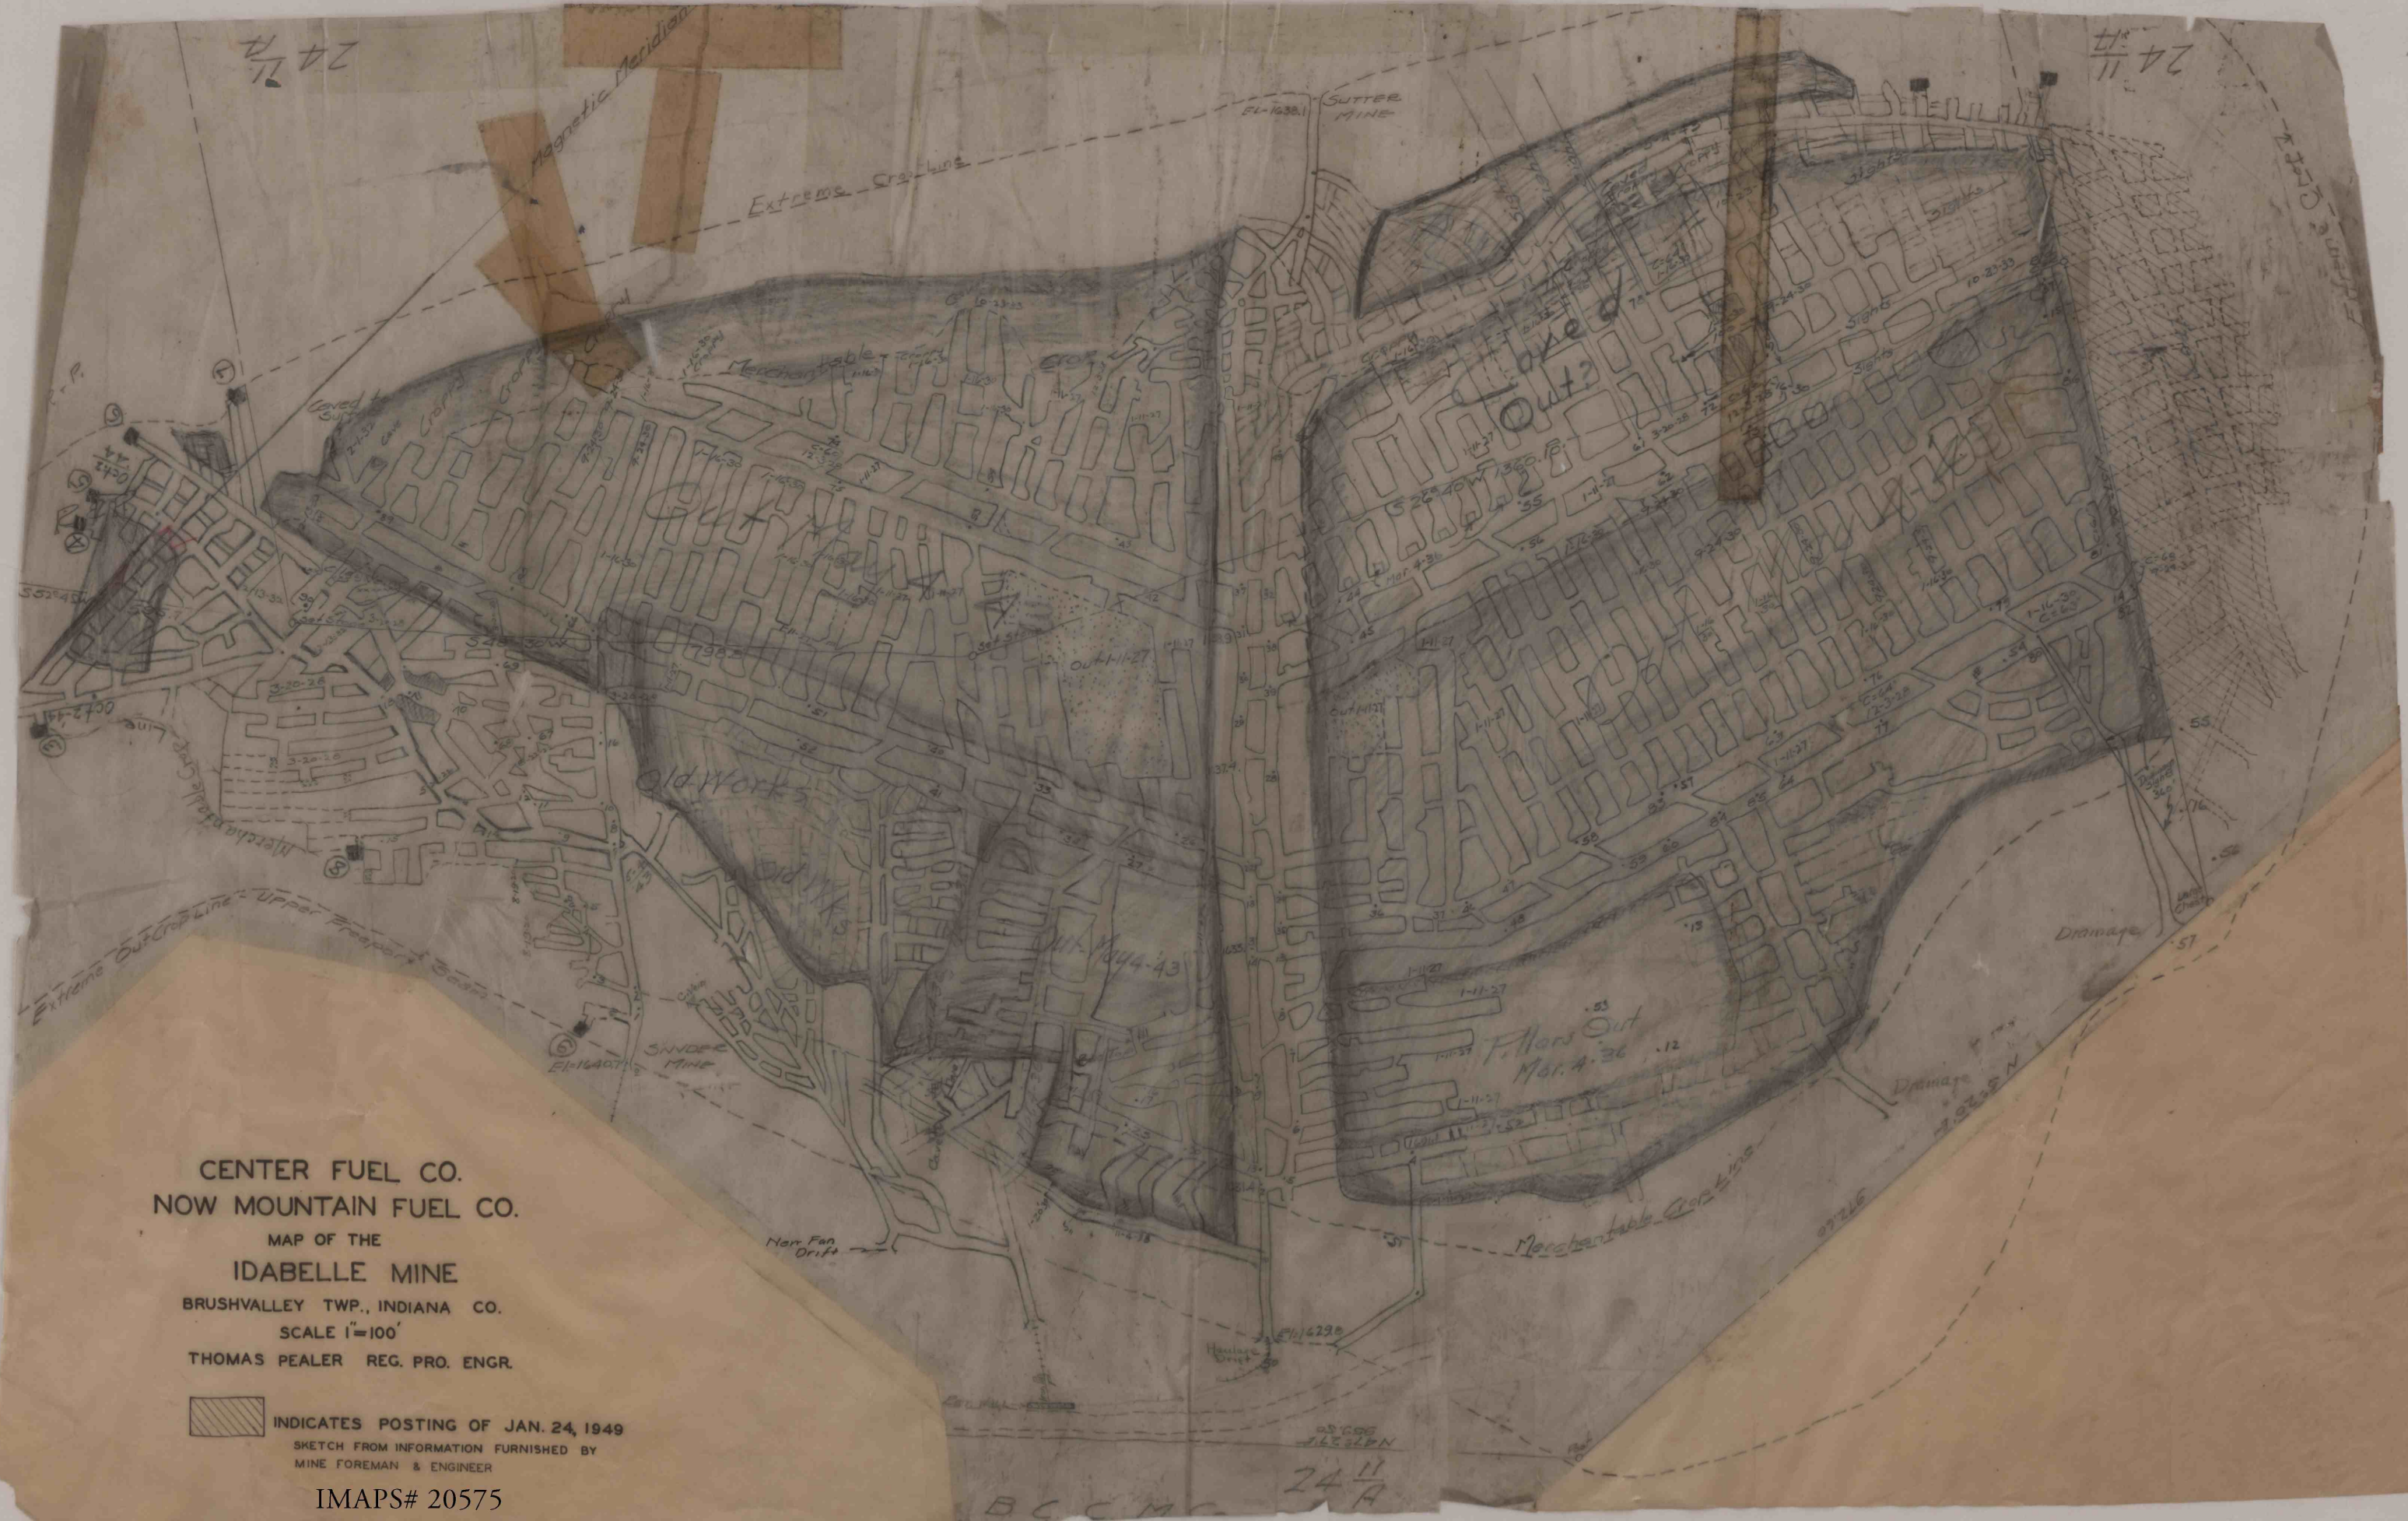

CENTER FUEL CO.
NOW MOUNTAIN FUEL CO.
MAP OF THE
IDABELLE MINE
BRUSHVALLEY TWP., INDIANA CO.
SCALE 1"=100'
THOMAS PEALER REG. PRO. ENGR.

 INDICATES POSTING OF JAN. 24, 1949
SKETCH FROM INFORMATION FURNISHED BY
MINE FOREMAN & ENGINEER