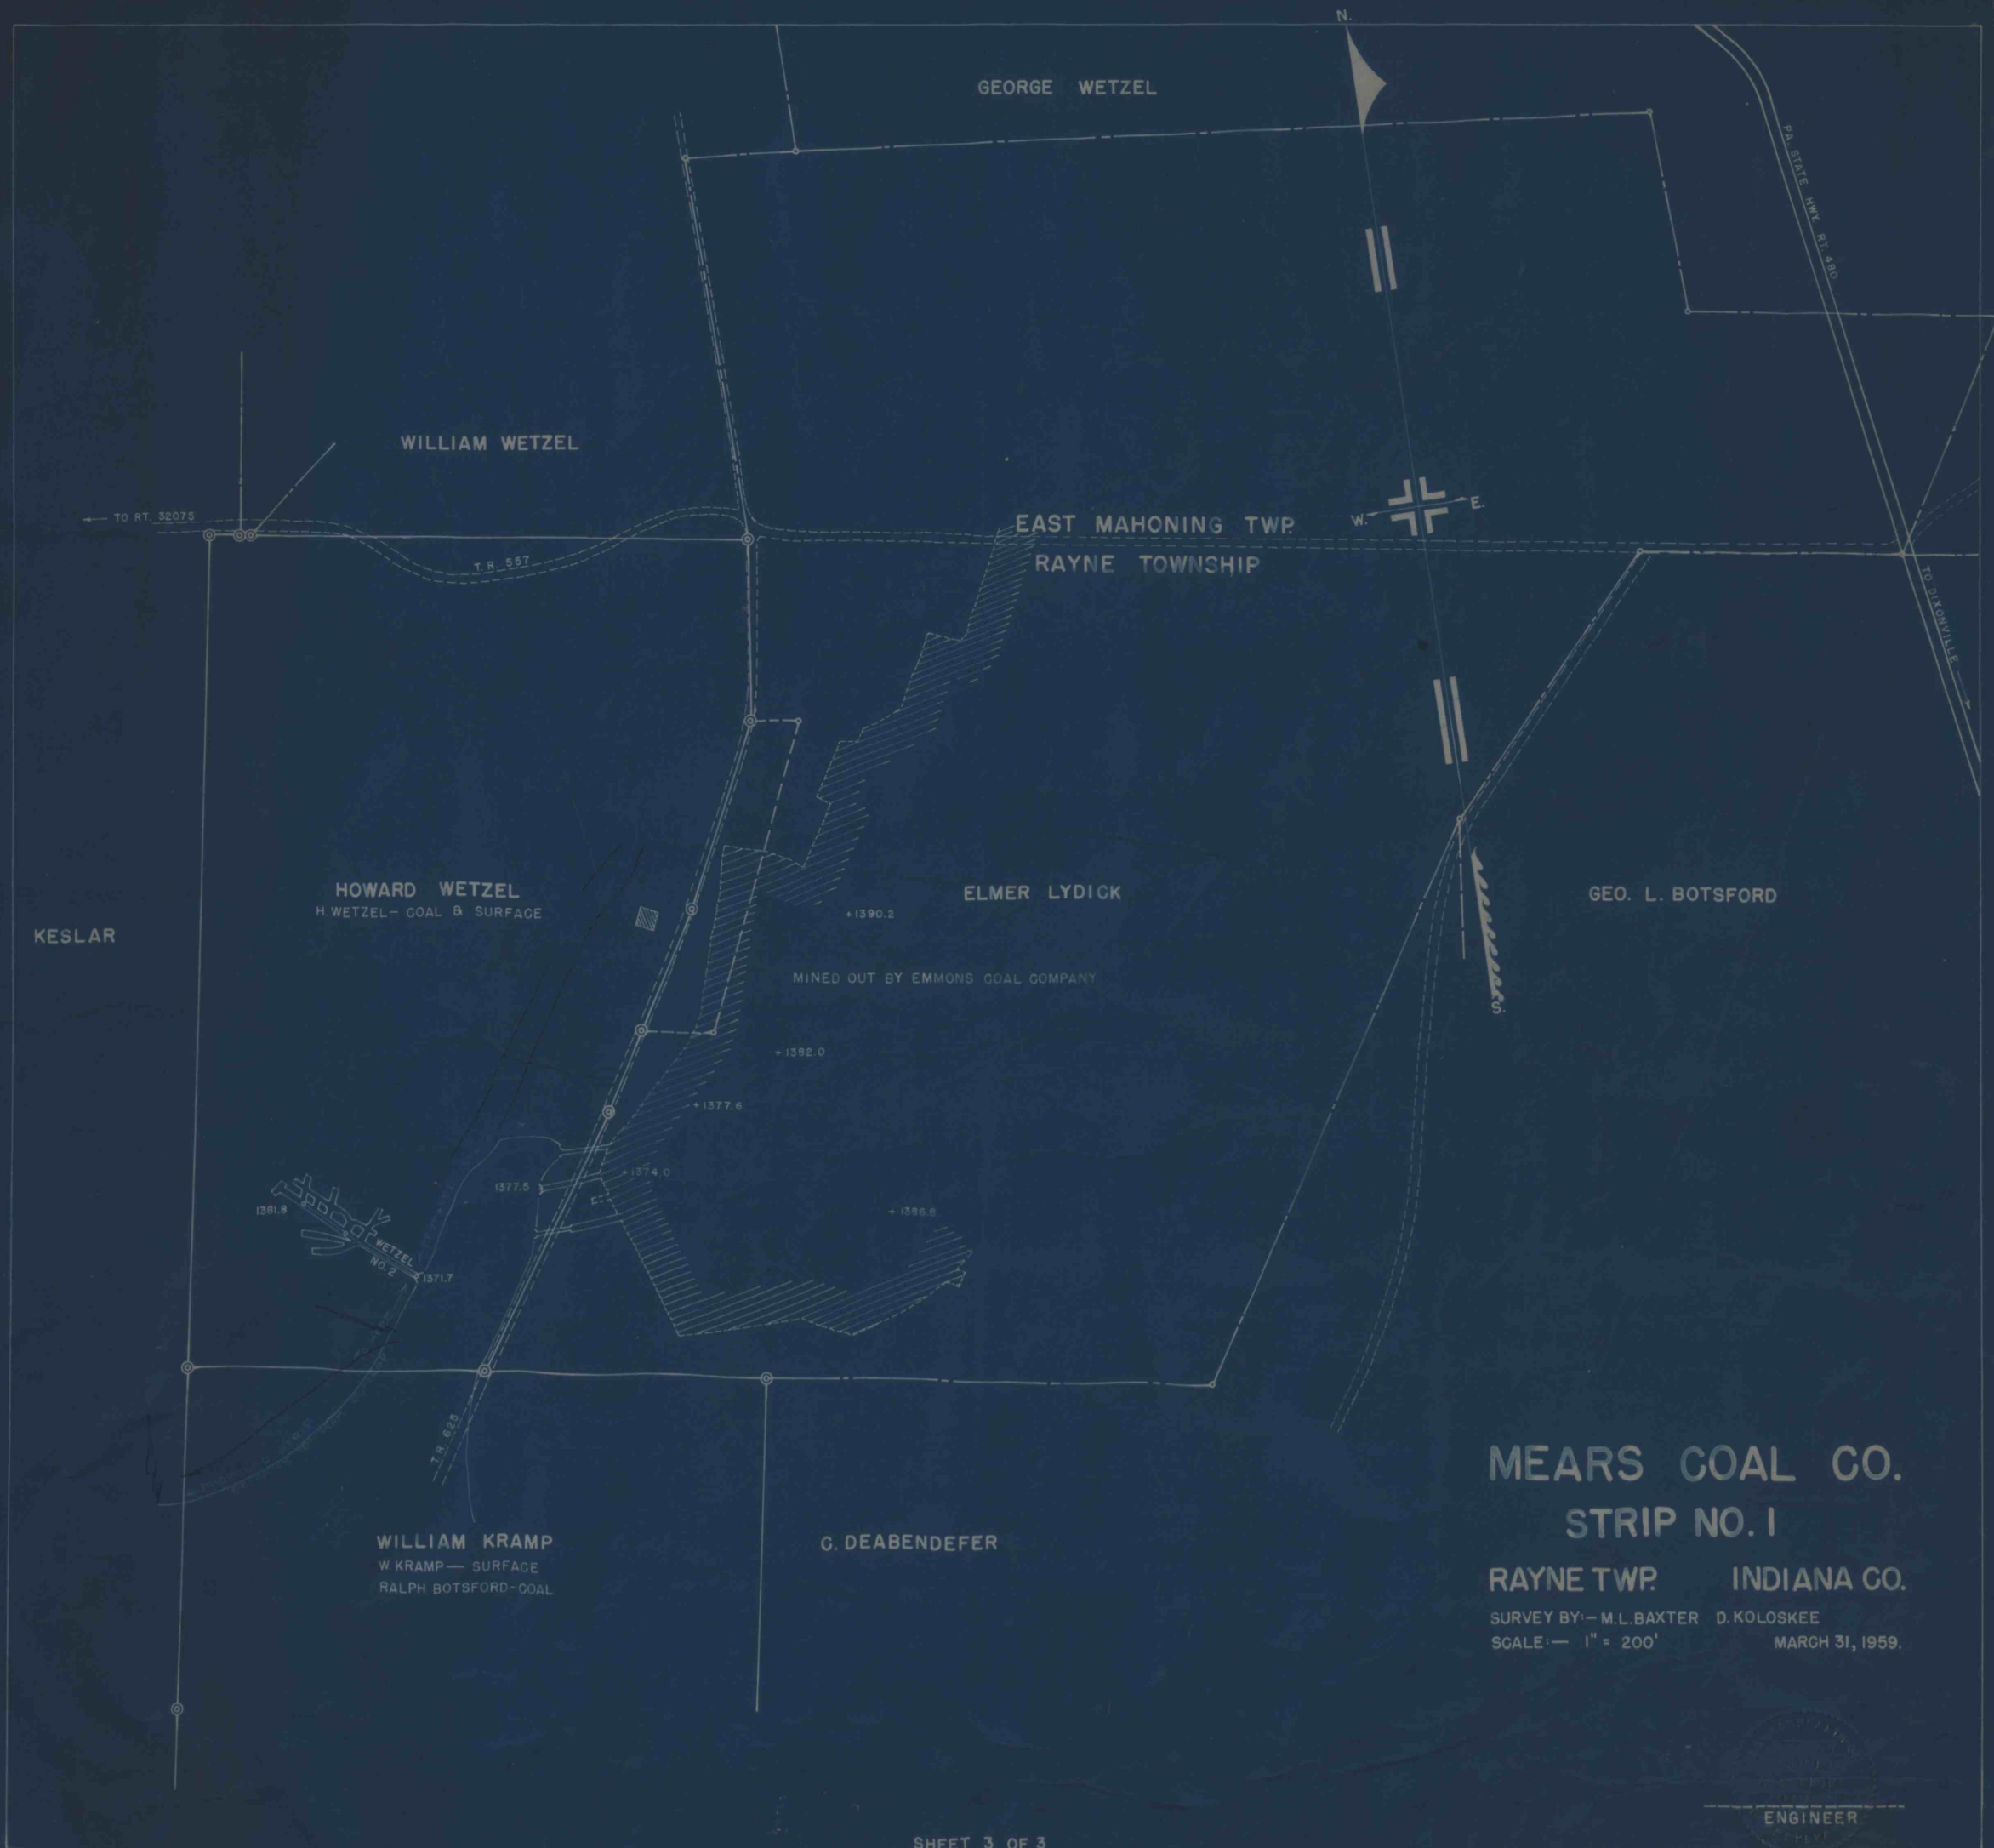

SHEET 3 OF 3

IMAPS # 20587