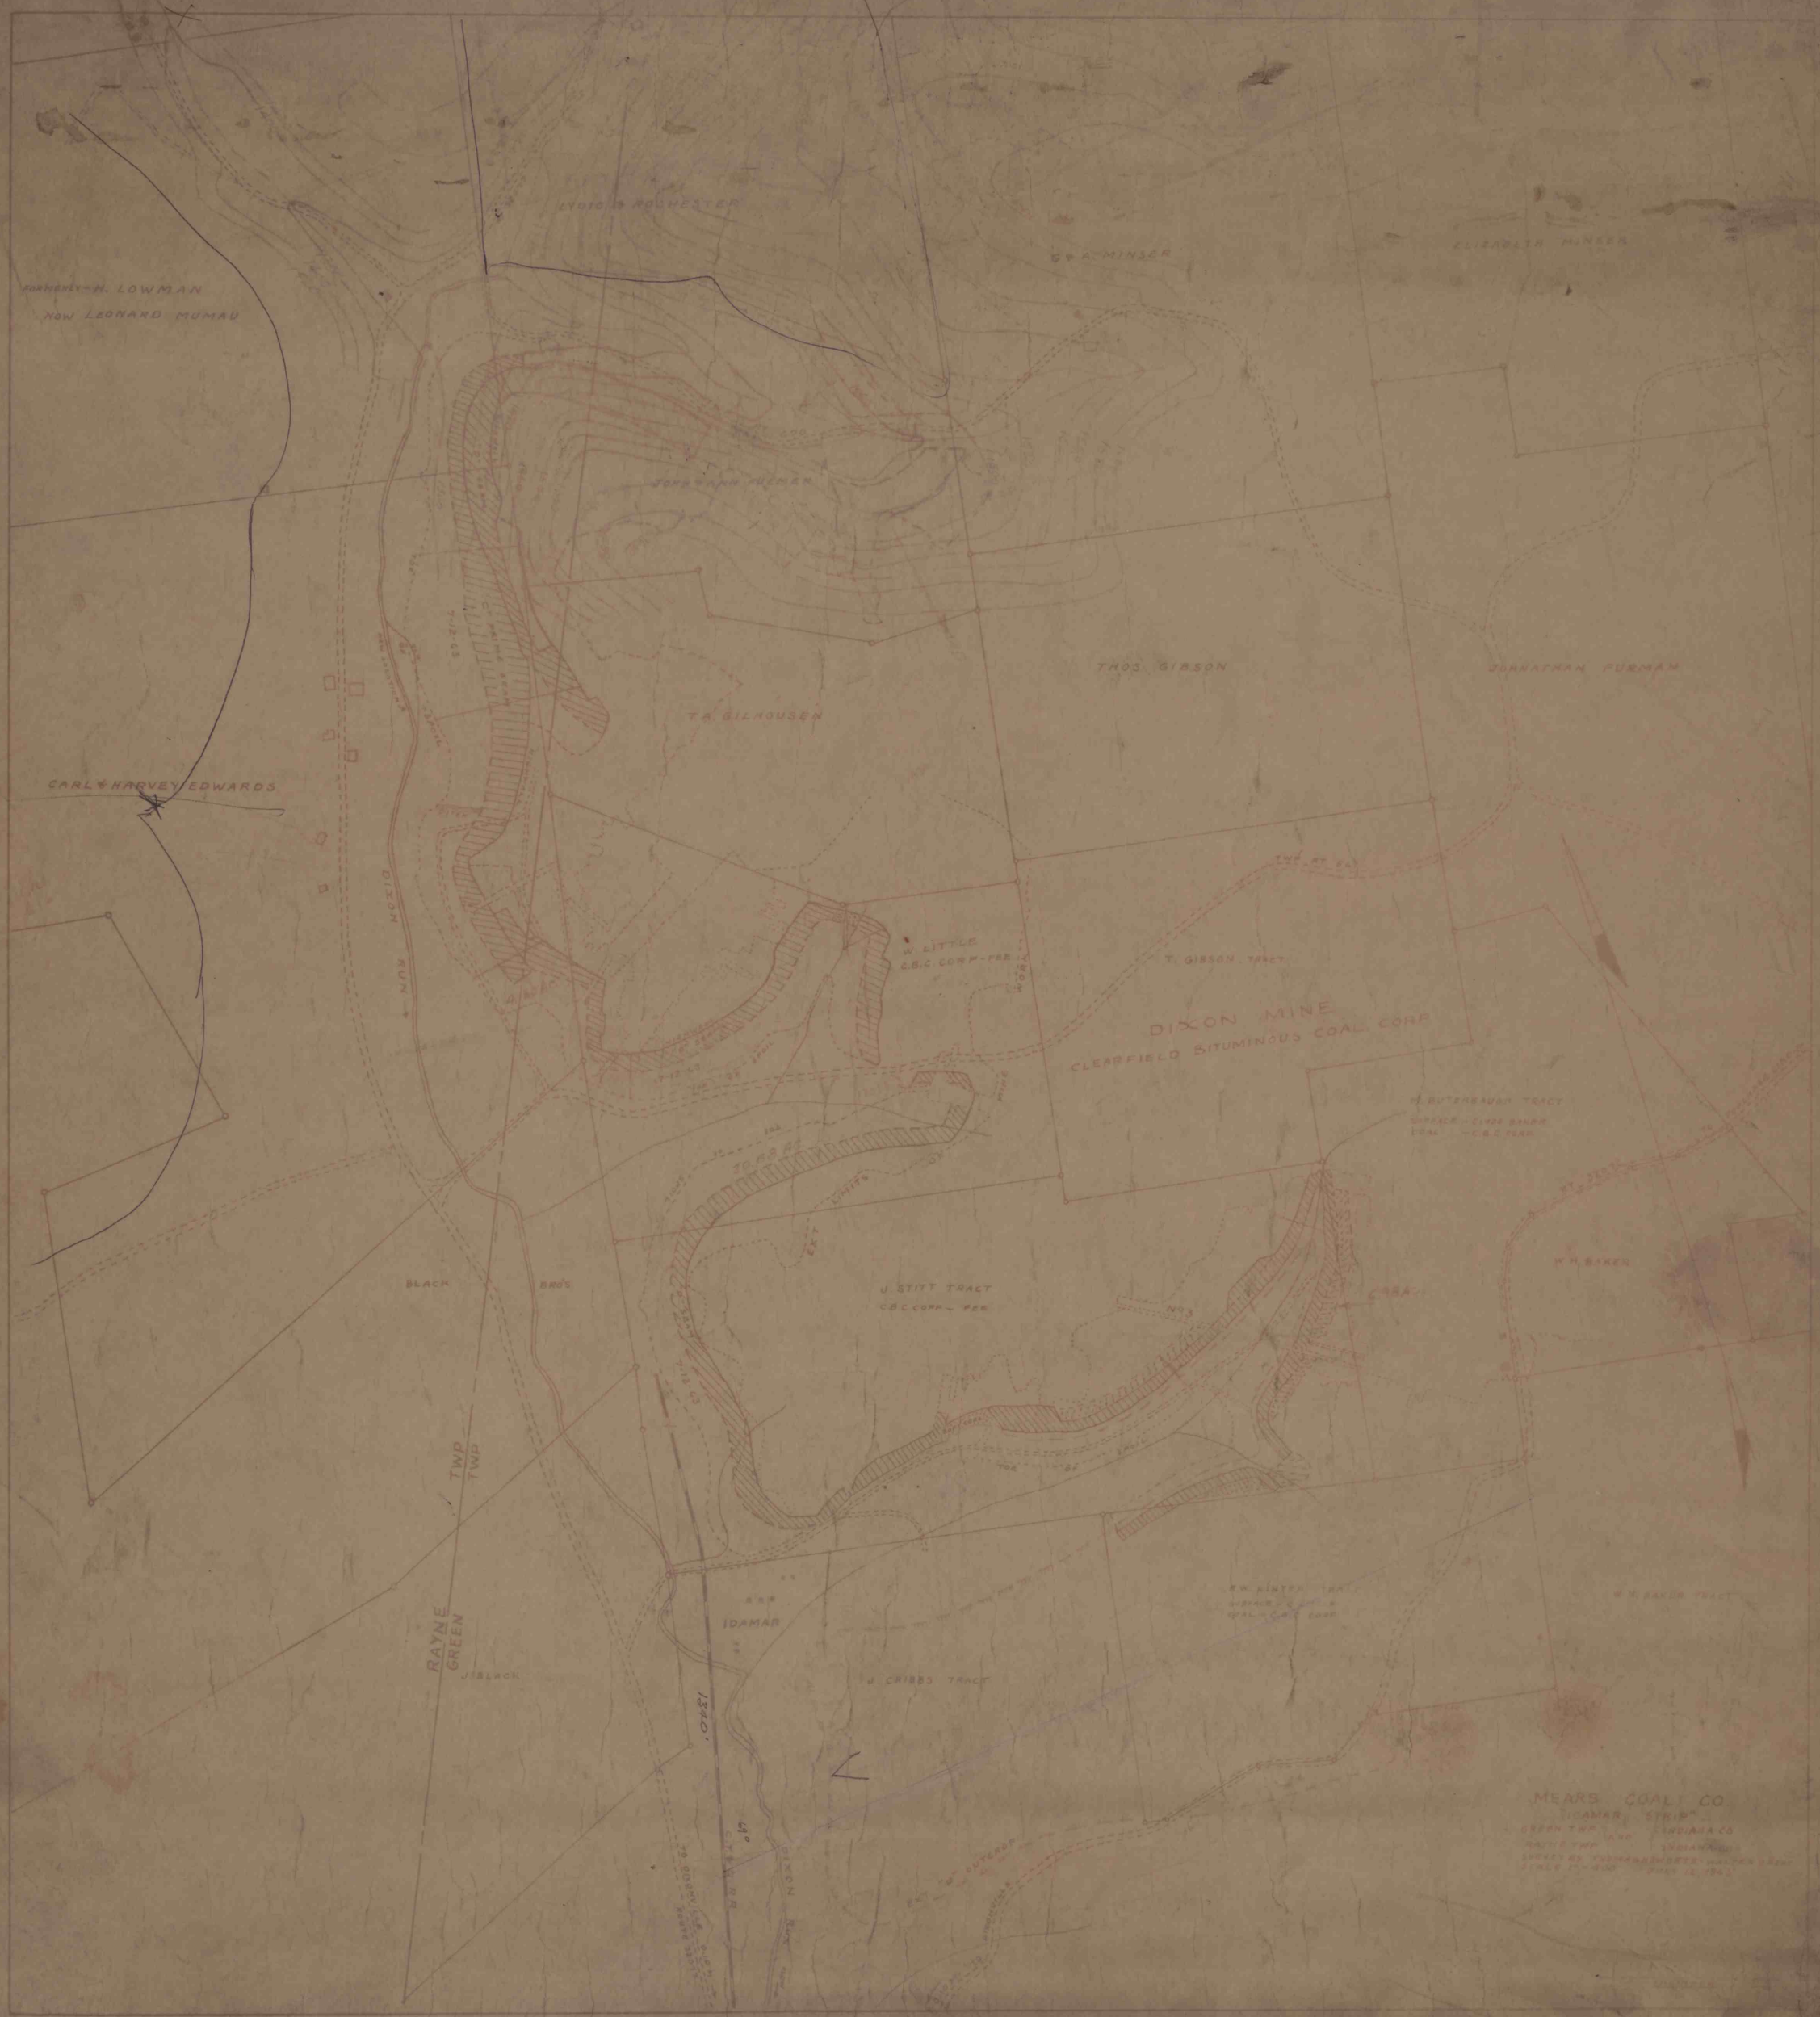
FORMERLY - H. LOWMAN
NOW LEONARD MUMAU
LYDIA A. ROCHESTER
G. A. MINSER
ELIZABETH MINSER
JONATHAN FULMER
THOS. GIBSON
JONATHAN FURMAN
T. A. GILHOUSEN
CARL & HARVEY EDWARDS
DIXON RUN
W. LITTLE
C.B.C. CORP - FEE
T. GIBSON TRACT
CLEARFIELD BITUMINOUS COAL CORP
W. BUTTERBAUGH TRACT
BLACK
BRO'S
J. STITT TRACT
C.B.C. CORP - FEE
W. H. BAKER
TWP
TWP
RAYNE
GREEN
J. BLACK
IDAMAR
J. CRIBBS TRACT
49°
DIXON RUN
MEARS COAL CO
IDAMAR STRIP

IMAPS # 20624