

DRILL HOLE SUMMARY				
DRILL HOLE ID	SURFACE ELEVATION	BOC	SEAM	SWL
DH-12	1328.4	1299.2	L. FREEPORT RIDER	1279.4
		1286.2	LOWER FREEPORT	
DH-13	1327.0	1299.0	UPPER KITTANNING	1250.0
		1299.0	L. FREEPORT RIDER	
		1290.8	LOWER FREEPORT	
OB-14	1360.4	1309.4	UPPER KITTANNING	1316.4
		1309.4	FREEPORT RIDER	
DH-15	1336.3	1312.3	LOWER FREEPORT	ND
		1298.8	L. FREEPORT RIDER	
DH-16	1263.1	1238.6	UPPER KITTANNING	1233.1
DH-17	1192.7	1249.1	UPPER KITTANNING	1158.7
DH-18	1258.7	1157.4	LOWER KITTANNING	1189.7
DH-19	1196.5	1176.1	LOWER KITTANNING	1189.7
DH-20	1196.5	1176.5	LOWER KITTANNING	1189.7
DH-21	1316.3	1269.3	UPPER KITTANNING	1259.3
DH-22	1240.6	1196.7	LOWER KITTANNING	1198.6
DH-23	1243.3	1204.8	LOWER KITTANNING	1192.3
		1179.8	L. KITTANNING LEADER	
DH-24	1239.7	1203.2	LOWER KITTANNING	1205.7
DH-25	1239.6	1201.4	LOWER KITTANNING	1201.1
DH-26	1242.1	1198.3	LOWER KITTANNING	1201.1
DH-27	1247.1	1190.9	LOWER KITTANNING	1152.1
		1177.6	L. KITTANNING LEADER	
DH-28	1258.3	1246.3	MIDDLE KITTANNING	1186.3
		1196.8	LOWER KITTANNING	
		1184.7	L. KITTANNING LEADER	
DH-29	1272.4	NO COAL		1209.4
DH-30	1279.4	1207.4	LOWER KITTANNING	1210.4
DH-31	1279.3	1202.5	LOWER KITTANNING	1205.3
		1184.0	L. KITTANNING LEADER	
DH-32	1260.8	1196.3	LOWER KITTANNING	1192.8
OB-33	1255.2	1191.2	LOWER KITTANNING	1203.2
DH-34	1263.9	1210.9	LOWER KITTANNING	1203.2
		1192.8	L. KITTANNING LEADER	
		1136.4	CLARION	
DH-35	1186.9	NO COAL		
DH-36	1203.8	1180.8	LOWER KITTANNING	1191.8
DH-37	1221.9	1197.3	LOWER KITTANNING	1200.3
DH-38	1221.9	1195.9	LOWER KITTANNING	1195.7
DH-39	1220.6	1195.6	LOWER KITTANNING	1195.7
DH-40	1388.3	1349.6	UPPER KITTANNING	1411.3
DH-41	1394.7	1350.2	UPPER KITTANNING	1411.3
DH-42	1384.7	1355.4	UPPER KITTANNING	1359.1
DH-43	1425.4	1404.7	UPPER FREEPORT	1425.0
DH-44	1454.4	1401.3	UPPER FREEPORT	1412.4
DH-45	1481.3	1399.8	UPPER FREEPORT	1411.3
DH-46	1461.9	1390.1	UPPER FREEPORT	1424.9
DH-47	1477.0	1384.0	UPPER FREEPORT	1425.0
DH-48	1486.4	1397.6	UPPER FREEPORT	1443.4
DH-49	1447.2	1403.9	UPPER FREEPORT	1444.4
DH-50	1450.4	1409.4	UPPER FREEPORT	1404.2
DH-51	1276.7	1195.7	LOWER KITTANNING	1212.7
DH-52	1265.0	1200.0	LOWER KITTANNING	1212.0
DH-53	1219.6	1197.3	LOWER KITTANNING	1152.6
		1118.6	CLARION	
DH-54	1219.1	1197.8	LOWER KITTANNING	1206.1
DH-55	1284.0	1220.8	LOWER KITTANNING	1224.0
DH-56	1286.2	1222.4	LOWER KITTANNING	1224.2
DH-57	1294.5	1286.3	MIDDLE KITTANNING	1227.5
		1227.0	LOWER KITTANNING	
OB-51	1239.2	1173.2	LOWER KITTANNING	1183.0
DH-52	1252.3	1176.3	LOWER KITTANNING	1187.3
OB-53	1243.4	1174.4	LOWER KITTANNING	1181.4

WATER MONITORING LOCATIONS

MP-4	UNNAMED TRIB. NO. 1 DOWNSTREAM
MP-23	UNNAMED TRIB. NO. 1 UPSTREAM
MP-50	SOUTH FORK PINE CREEK BELOW
	UNNAMED TRIB. NO. 1
MP-51	SOUTH FORK PINE CREEK DOWNSTREAM
MP-52	SOUTH FORK PINE CREEK UPSTREAM
MP-54	UNNAMED TRIB. NO. 2 DOWNSTREAM
MP-55	UNNAMED TRIB. NO. 2 UPSTREAM

PROPERTY OWNER INDEX KEYED TO MODULE 5

MAP KEY NO.	PROPERTY OWNER
7	CLARENCE E. LOUDEN JR. & M. JEAN LOUDEN
8	CLARENCE E. LOUDEN JR. & M. JEAN LOUDEN
17	ROSE MARY SITA & PAUL J. SITA
4	BERNARD COBLEY JR.
5	BUFFALO & PITTSBURGH RAILROAD INC.
9	K. GLENN CORNMAN
13	JACK MECHLING
14	EVARD GARNER
15	CHARLES S. DILL
16	KEN MCCLAFFERTY
18	WILLIAM STEWART
22	ORLEN SCHRECKENGOST
23	MARGARET TEMPLETON
2	JOHN HANNA
10	CLARENCE LOUDEN JR.
11	HERBERT MCINTYRE
19	DENNIS BITTINGER
20	WILLIAM SHICK
24	PETER SERENE
25	VERNON GARNER
26	WILLIAM SHICK
27	EDWARD LEARD, ET AL
28	EDWARD LEARD, ET AL
29	JEFF ADAMS




NOTES:

UNDER AND SUBJECT TO EXCEPTIONS, RESERVATIONS, GRANTS, EASEMENTS, AND RIGHT-OF-WAYS WHICH ARE OF RECORD AND/OR VISIBLE AND MAY OR MAY NOT BE SHOWN ON PLAT.

THIS MAP HAS BEEN PREPARED FROM COUNTY TAX MAPS, DEEDS AND FIELD EVIDENCE. THIS MAP DOES NOT REPRESENT AN ACTUAL SURVEY OF THE PROPERTIES SHOWN.

CONTOURS AND NATURAL FEATURES ARE TAKEN FROM THE U.S.G.S. 7.5 MINUTE RURAL VALLEY QUADRANGLE. CONTOURS ARE ON A RANDOM DATA BASE RELATIVE TO THIS SITE ONLY.

PENNSYLVANIA ONE CALL SYSTEM, INC.
BEFORE YOU DIG ANYWHERE IN PENNSYLVANIA CALL 1-800-242-1776.

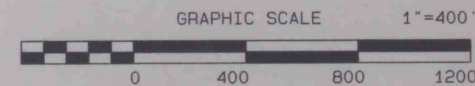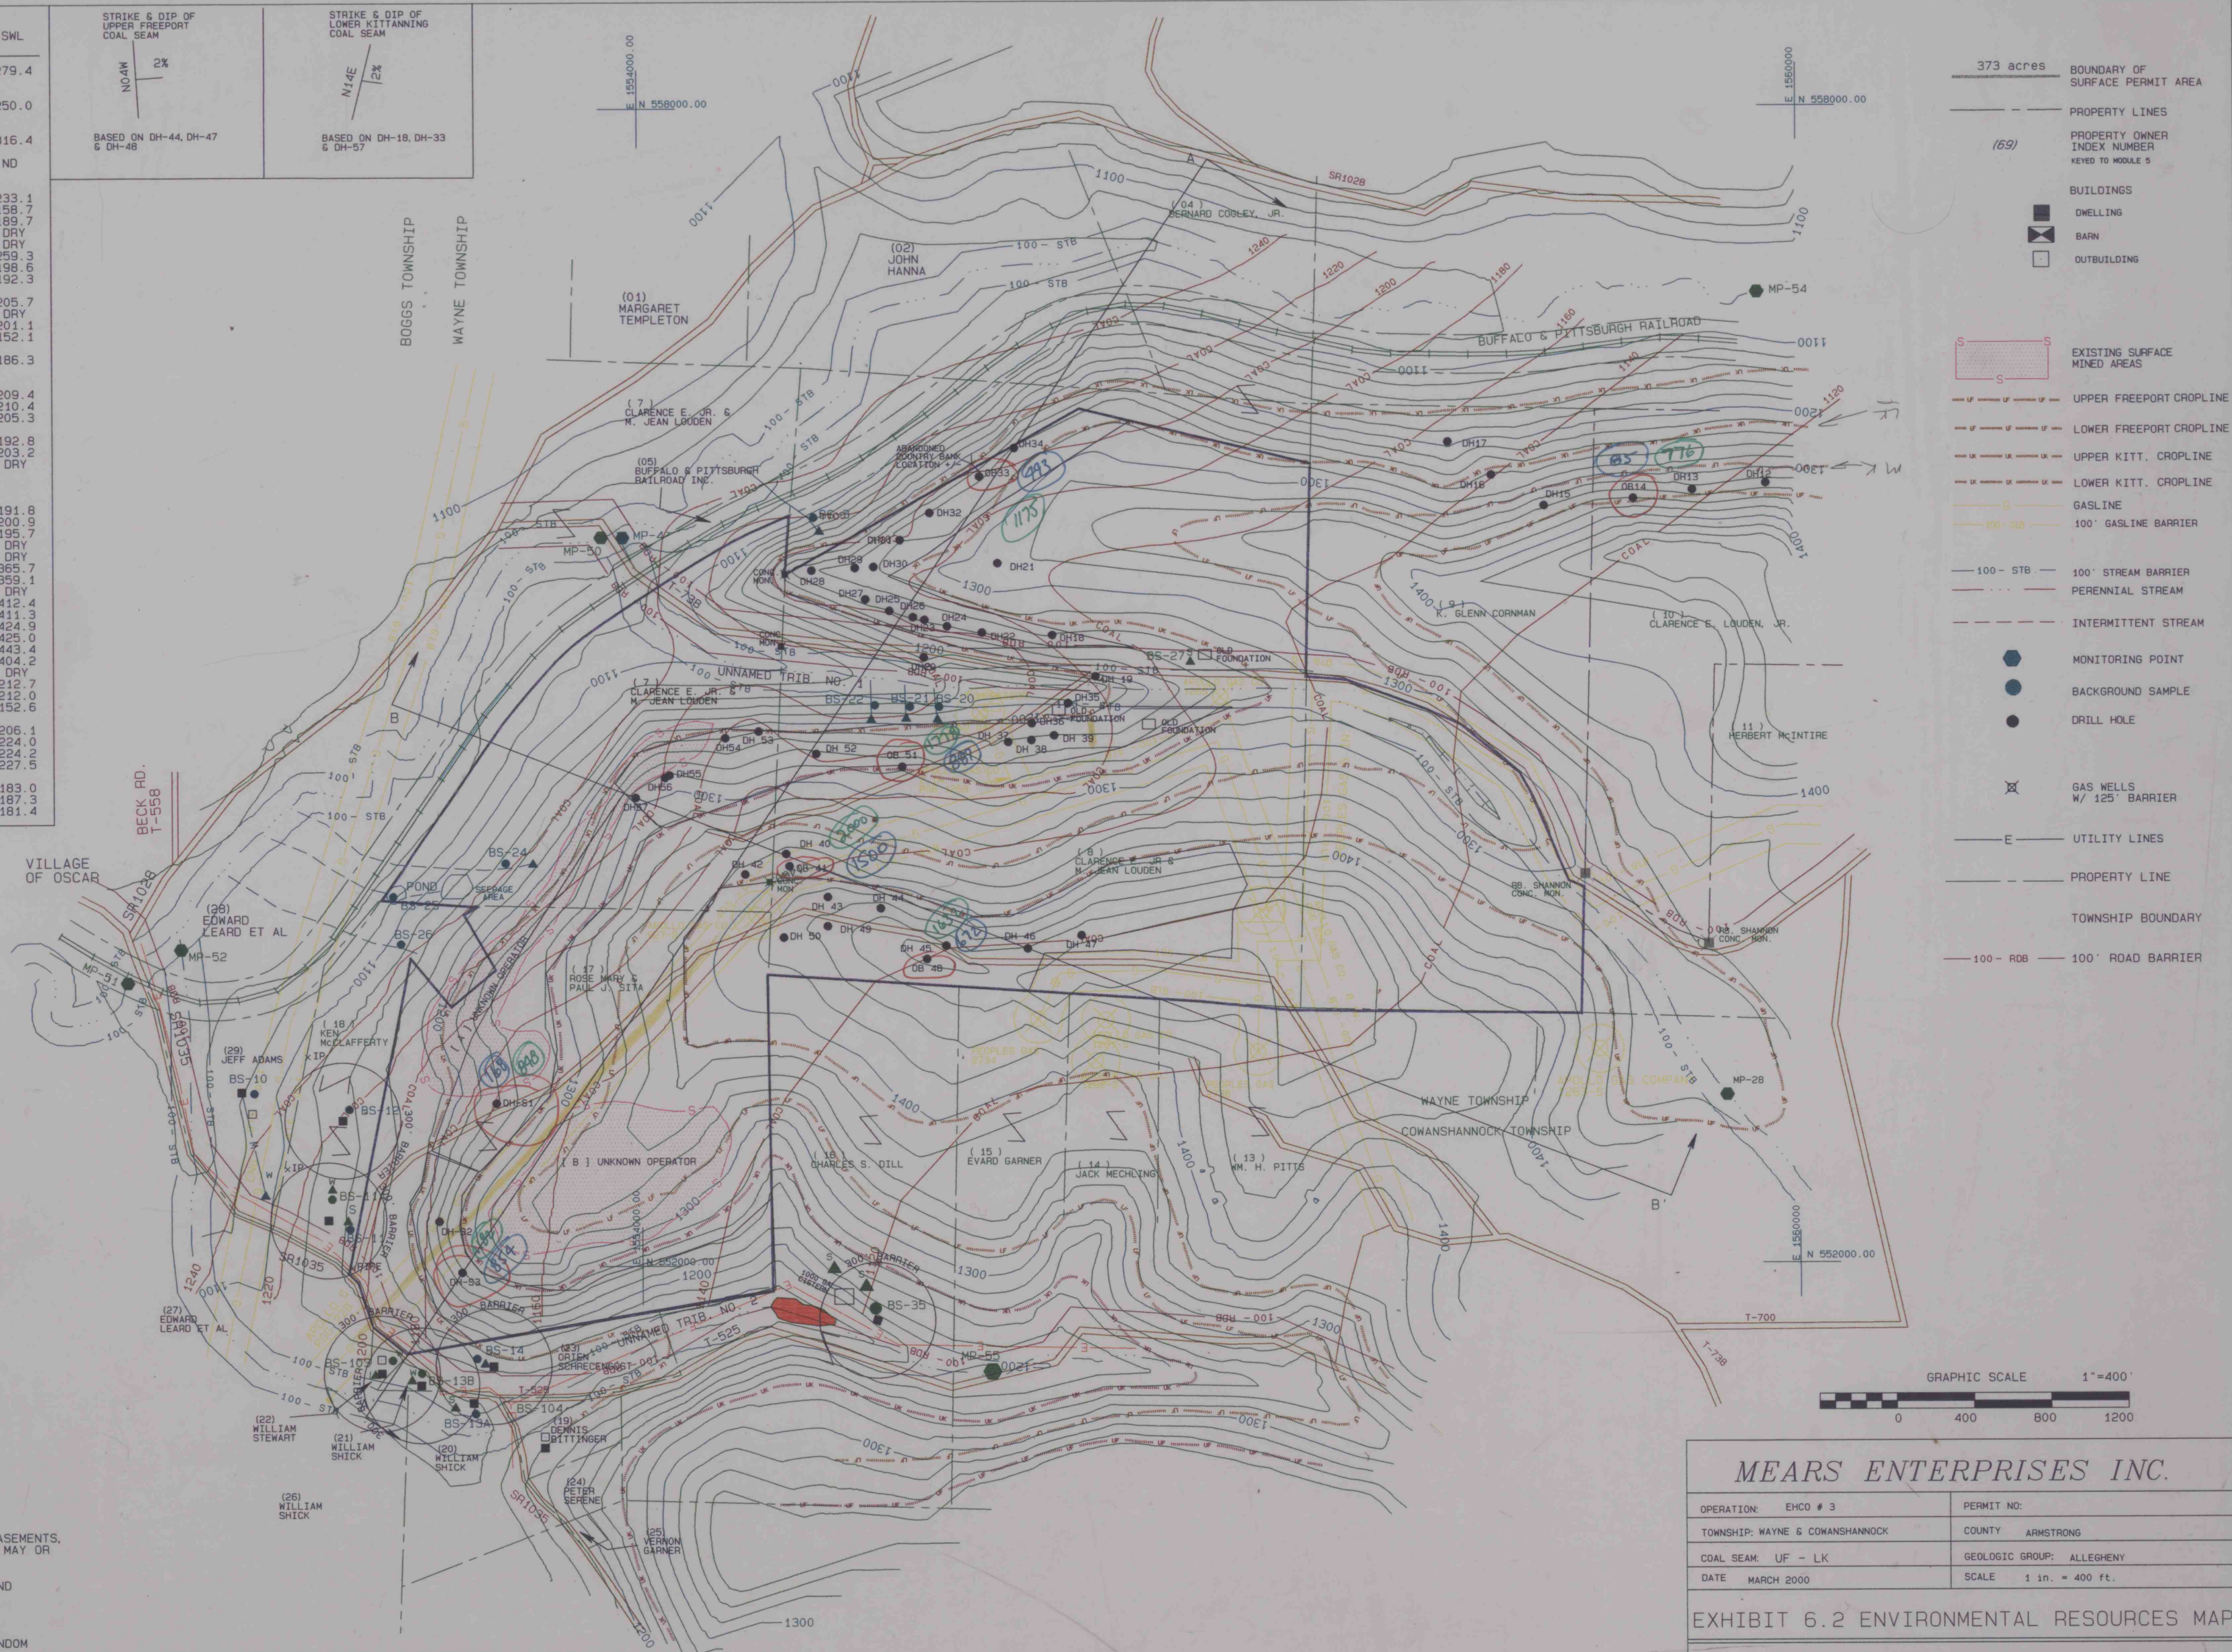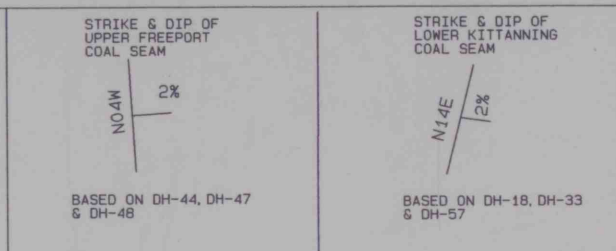

MEARS ENTERPRISES INC.

OPERATION: EHC0 # 3	PERMIT NO:
TOWNSHIP: WAYNE & COWANSHANNOCK	COUNTY: ARMSTRONG
COAL SEAM: UF - LK	GEOLOGIC GROUP: ALLEGHENY
DATE: MARCH 2000	SCALE: 1 in. = 400 ft.

EXHIBIT 6.2 ENVIRONMENTAL RESOURCES MAP

APPLEGATE SERVICES INC. MINING ENGINEERS

PO BOX 368 ELBERTON PA 15736	PH: 412-354-4772 FAX: 412-354-4773
DRAWN BY:	CHECKED BY:
PROJECT NO.	REVISIONS