


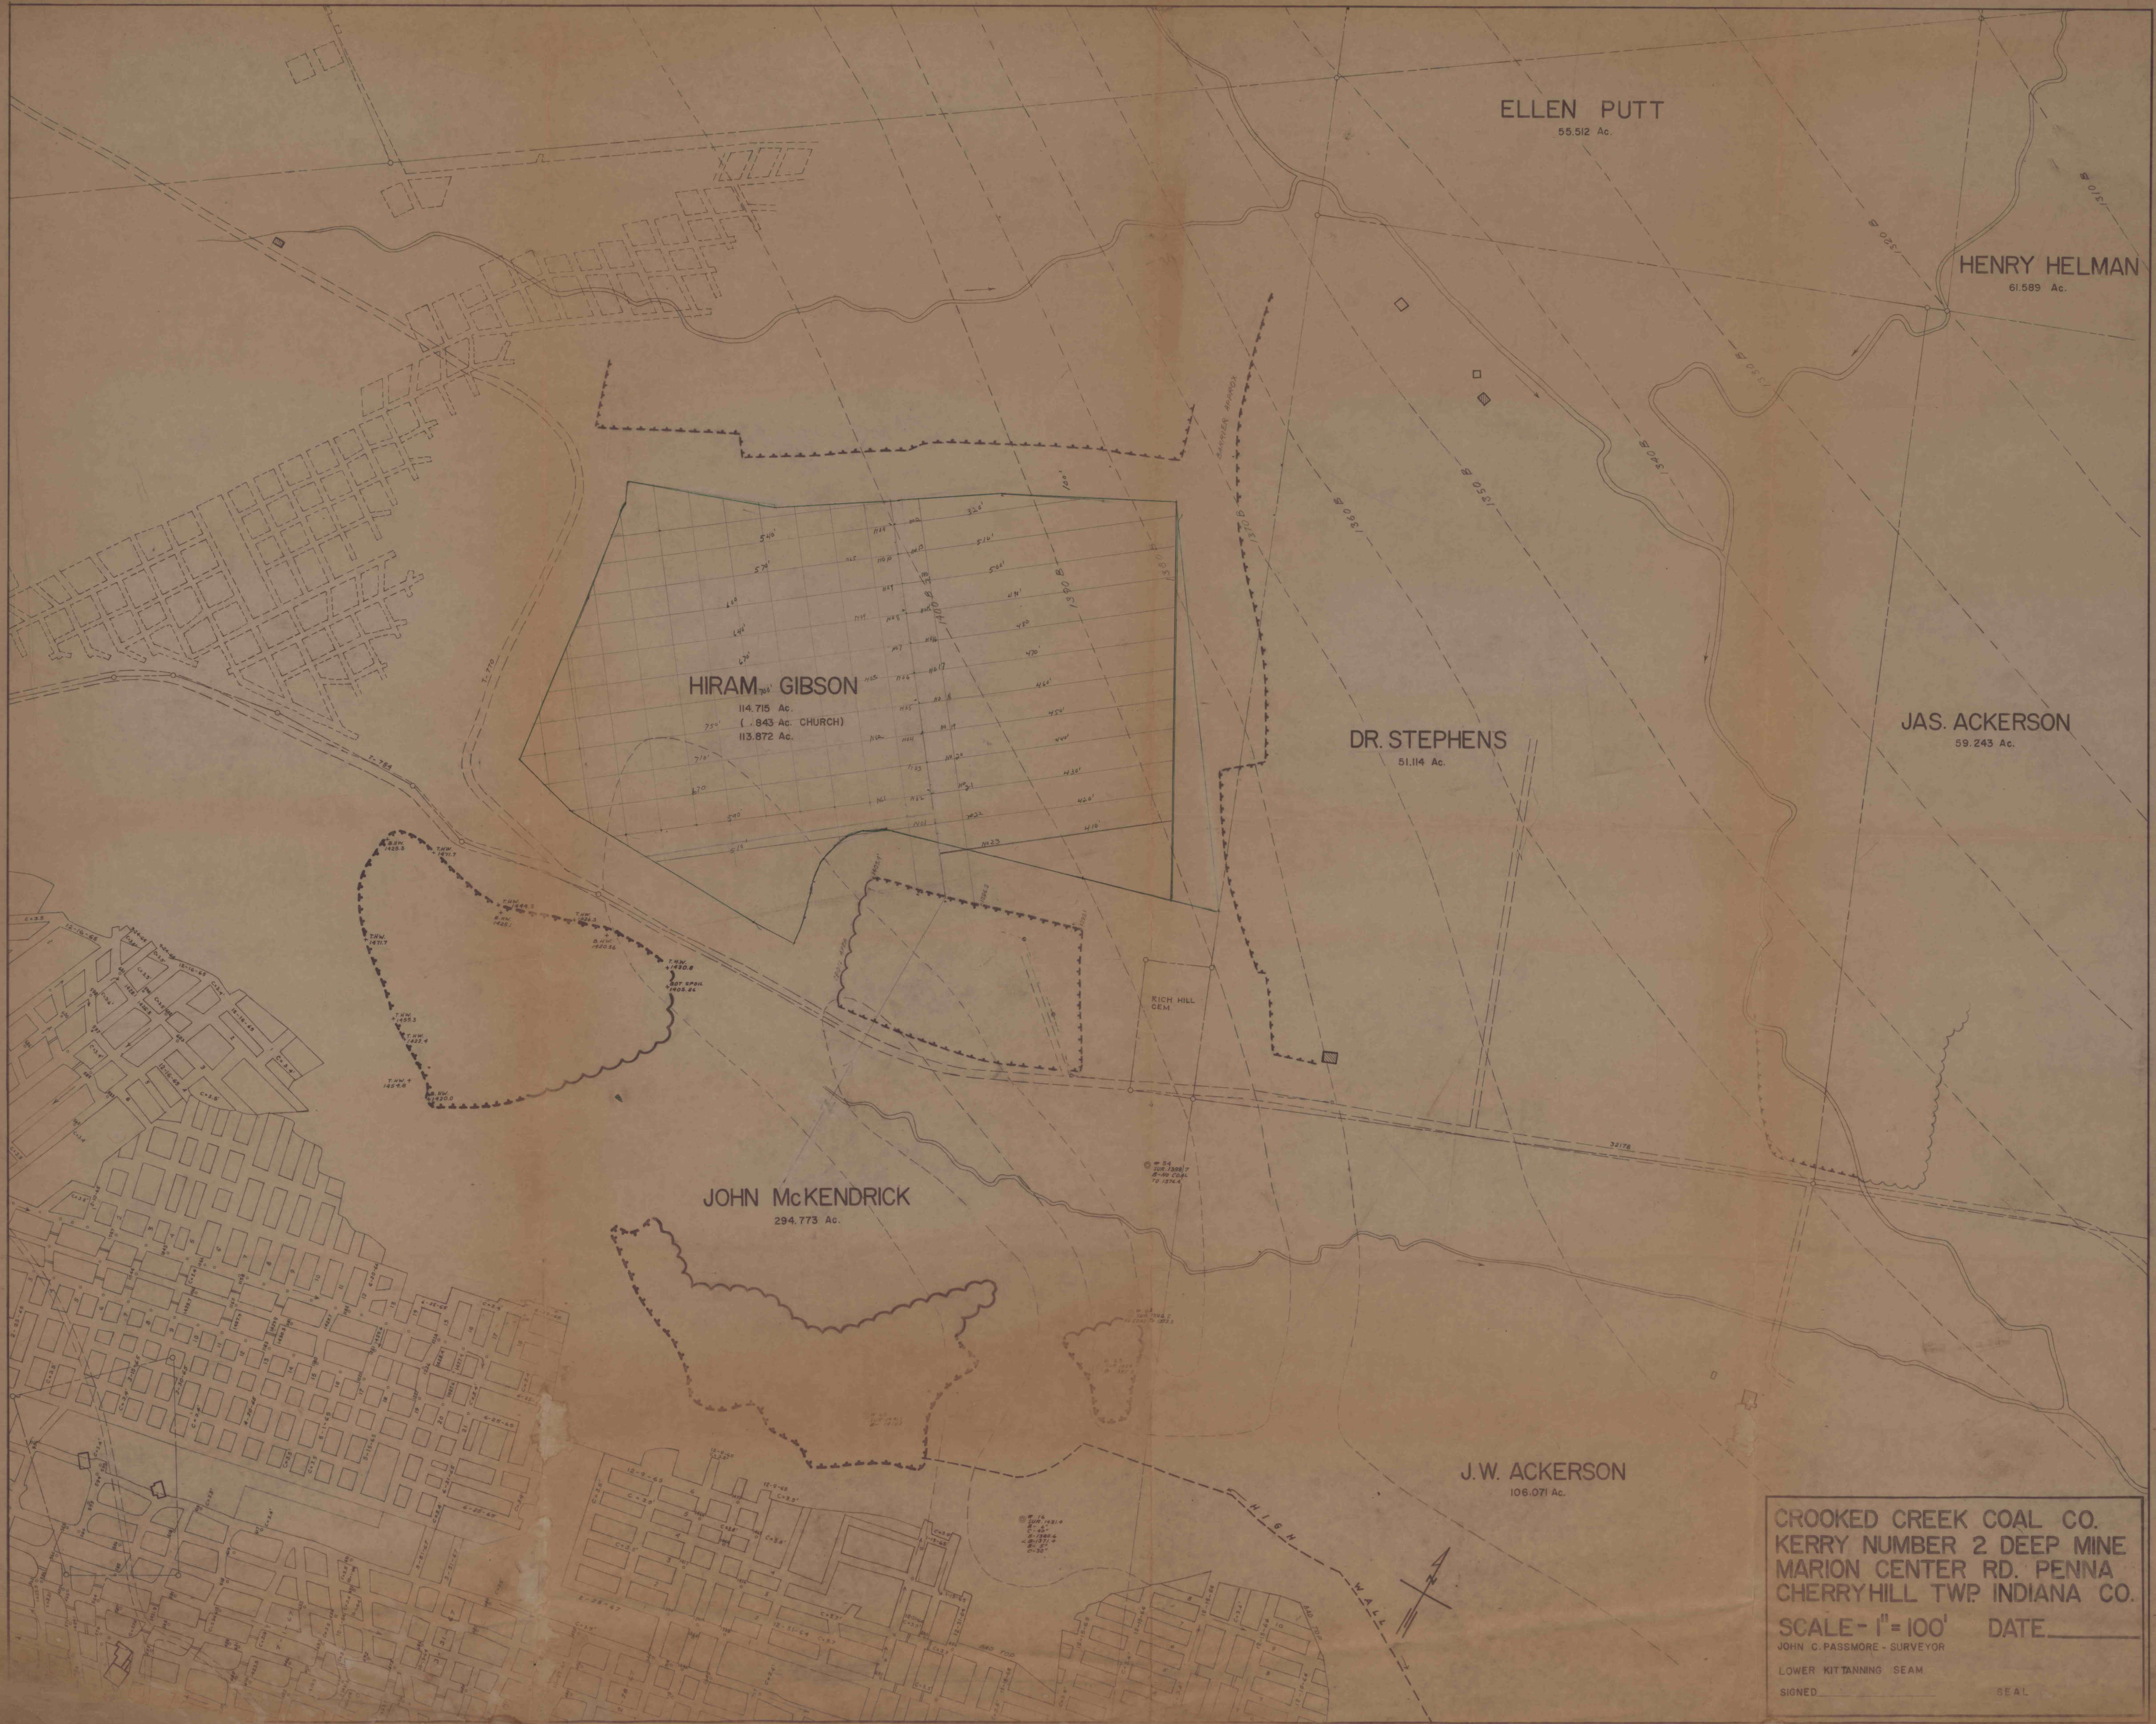

ELLEN PUTT  
55.512 Ac.

HENRY HELMAN  
61.589 Ac.

HIRAM GIBSON  
114.715 Ac.  
(.843 Ac. CHURCH)  
113.872 Ac.

DR. STEPHENS  
51.114 Ac.

JAS. ACKERSON  
59.243 Ac.

JOHN McKENDRICK  
294.773 Ac.

J.W. ACKERSON  
106.071 Ac.

CROOKED CREEK COAL CO.  
KERRY NUMBER 2 DEEP MINE  
MARION CENTER RD. PENNA  
CHERRYHILL TWP INDIANA CO.  
SCALE - 1" = 100' DATE \_\_\_\_\_  
JOHN C. PASSMORE - SURVEYOR  
LOWER KITTANNING SEAM  
SIGNED \_\_\_\_\_ SEAL \_\_\_\_\_