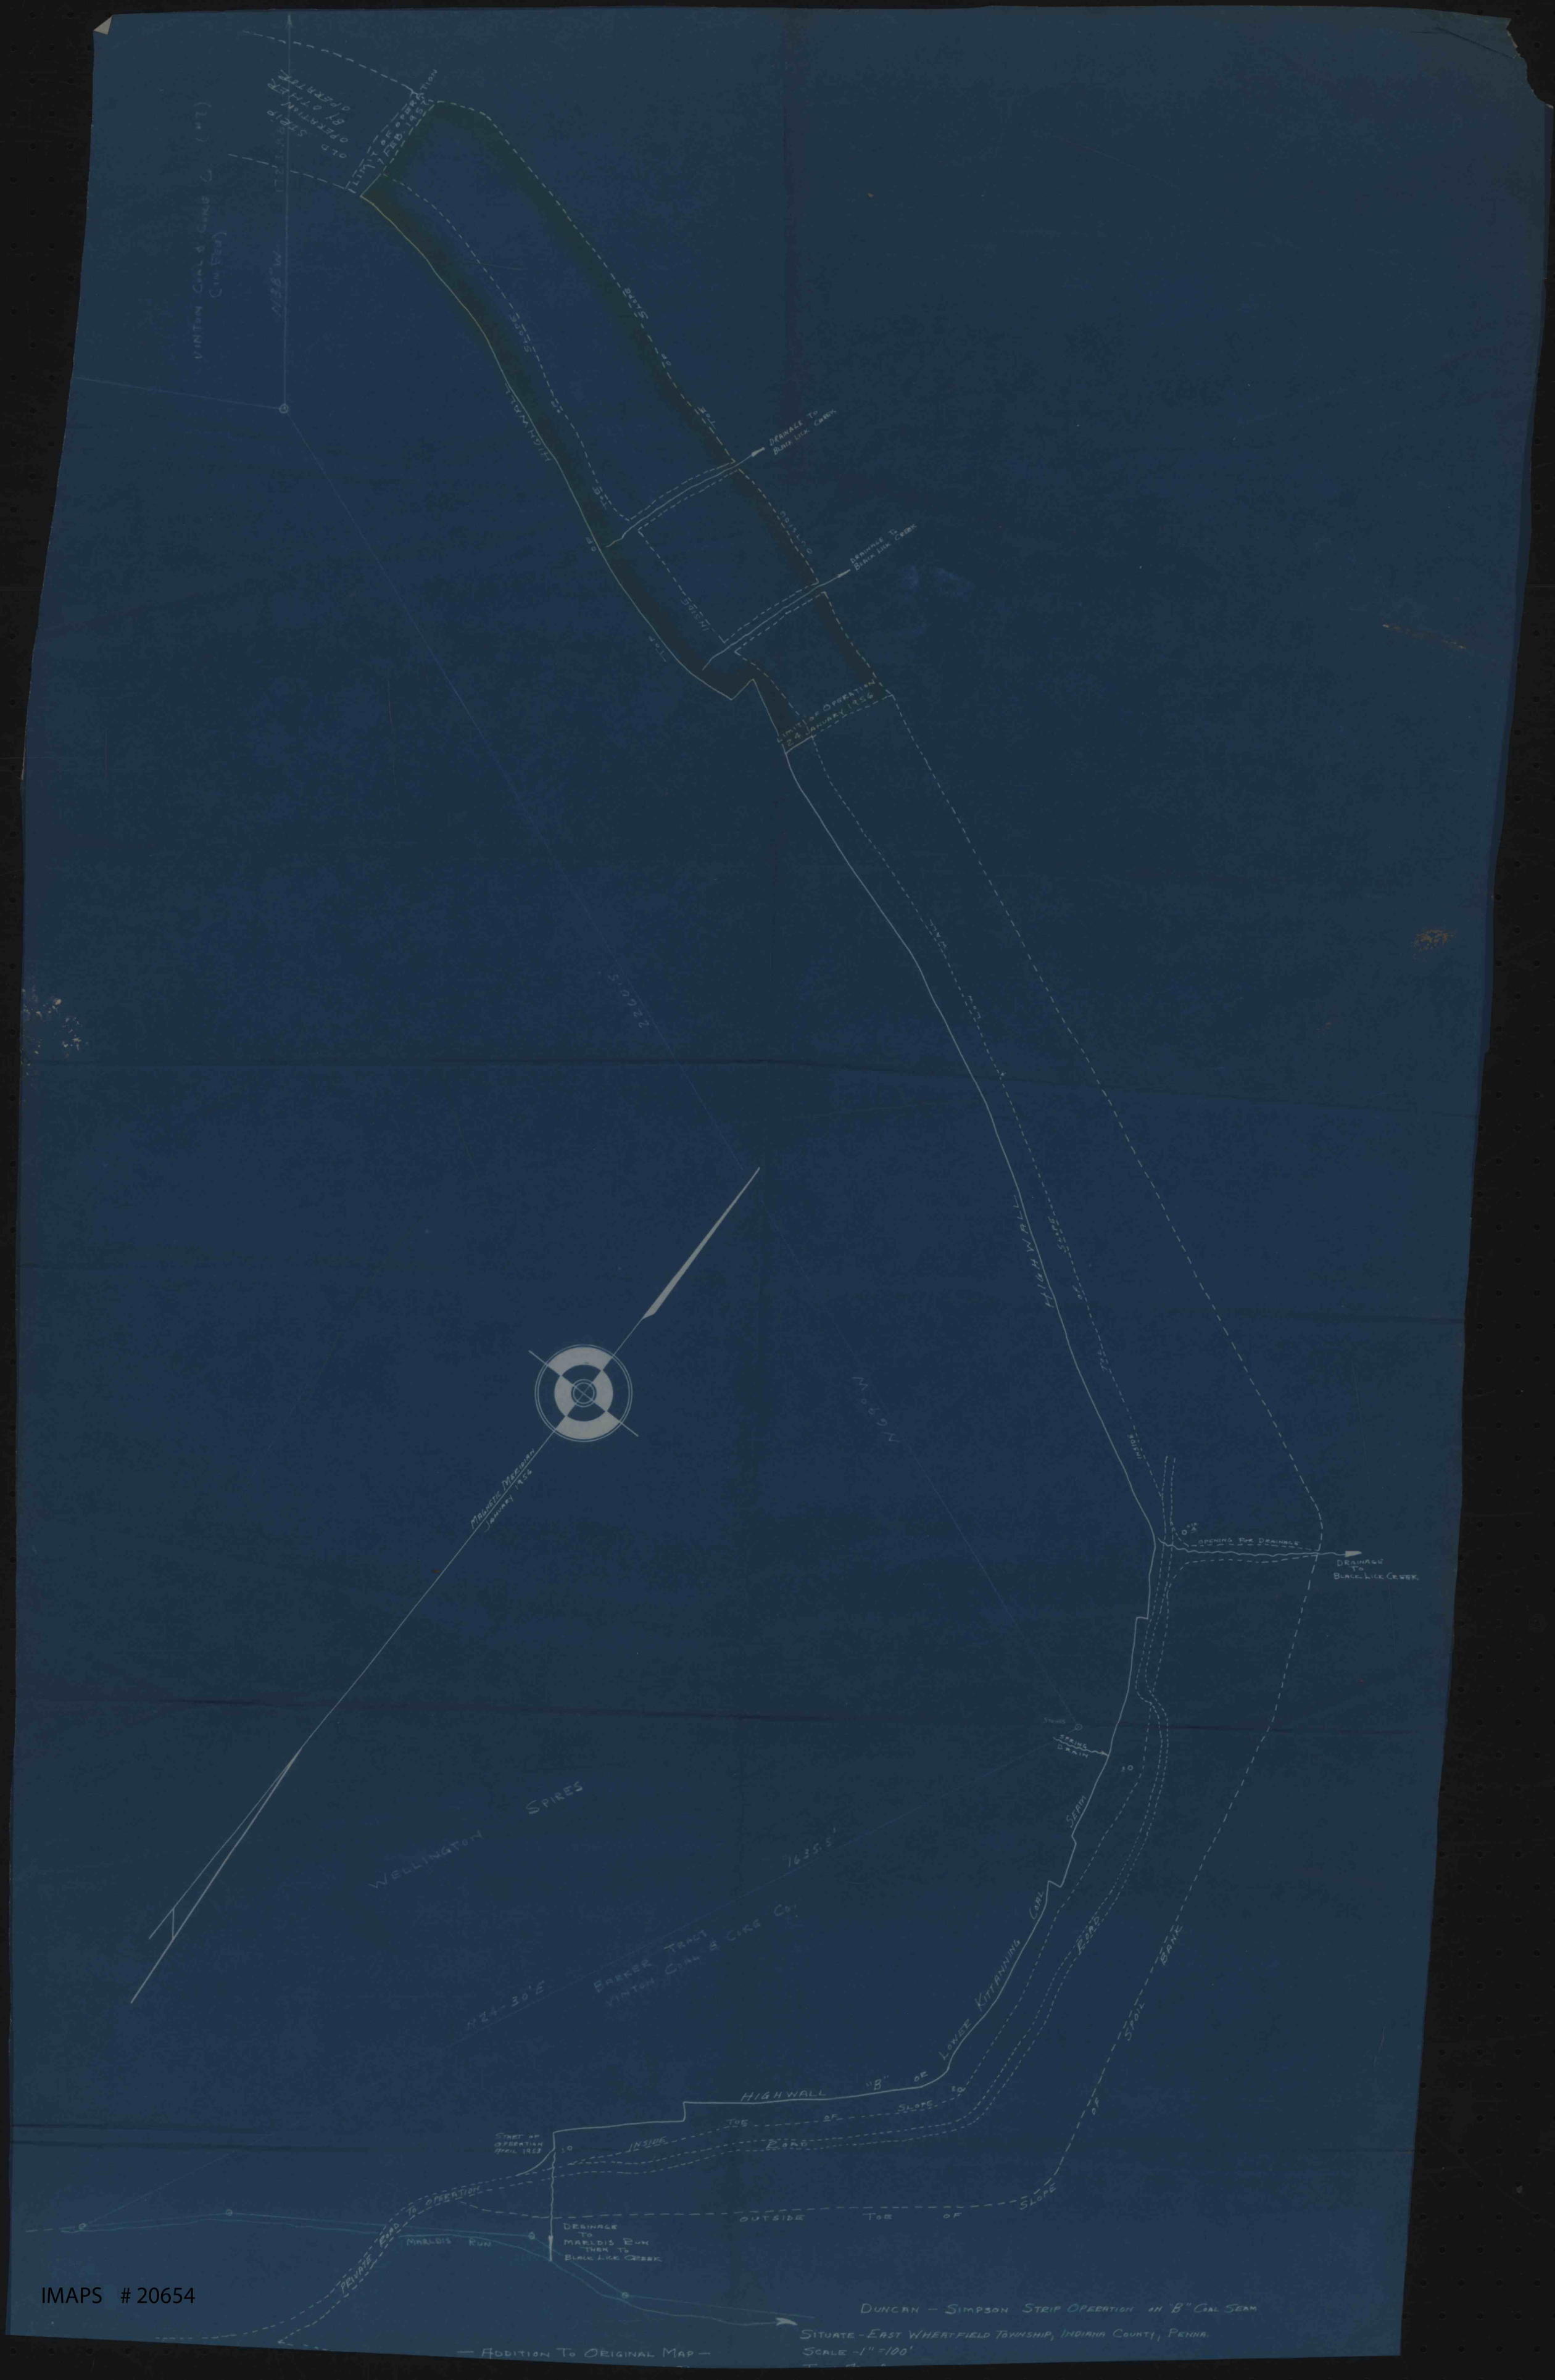
Old Strip Operation by others
Limits of Operation 7 Feb. 1957
Winton Coal & Coke Co.
N 28° W
S 22° E
Highwall
Drainage To Black Lick Creek
Limits of Operation 24 January 1956
Magnetic Meridian January 1956
Spires
Wellington
N 24° 30' E
Barber Tract Winton Coal & Coke Co.
1635.5'
Lower Kittanning Coal Seam
Highwall "B" of
Toe of Slope
Inside Road
Start of Operation April 1953
Private Road To Operation
Marldis Run
Drainage To Marldis Run Then To Black Lick Creek
Outside Toe of Slope
Spring Drain
Opening For Drainage
Drainage To Black Lick Creek
Spoil Bank
Duncan - Simpson Strip Operation on "B" Coal Seam
Situate - East Wheatfield Township, Indiana County, Penna.
Scale - 1" = 100'
— Addition To Original Map —

IMAPS # 20654