


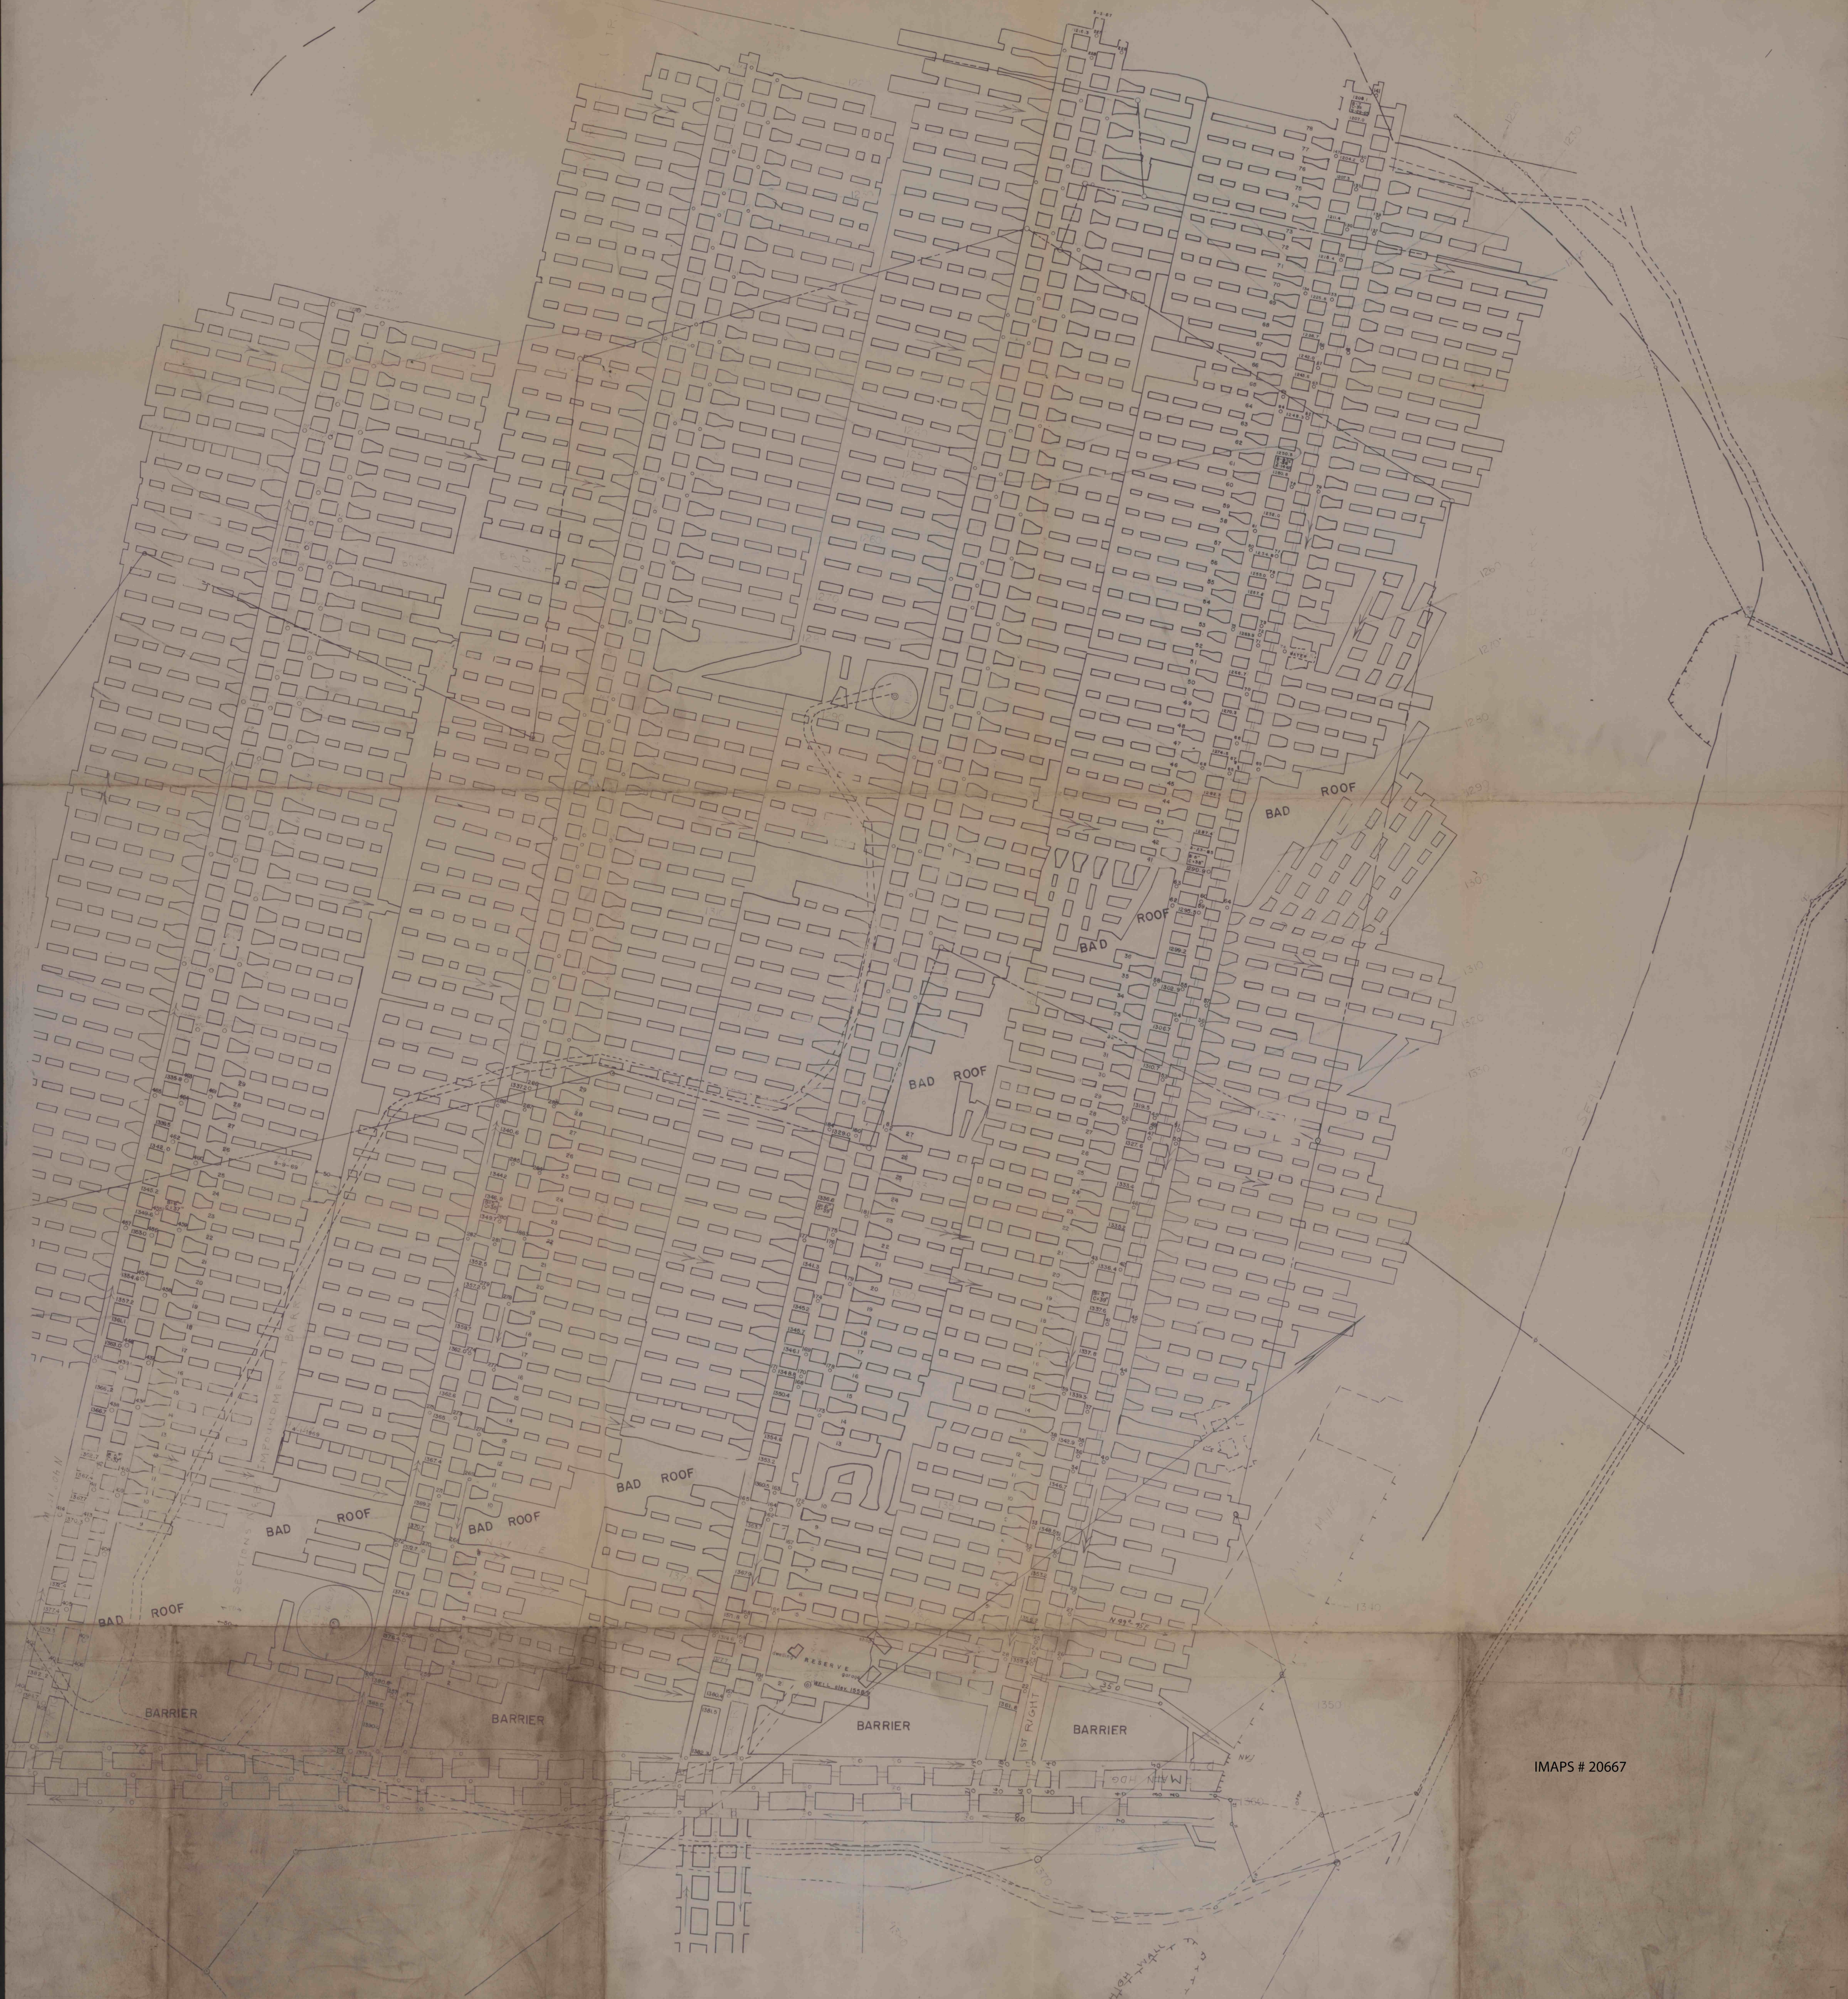

IMAPS # 20667