


N 34,000

N 33,000

N 32,000

N 31,000

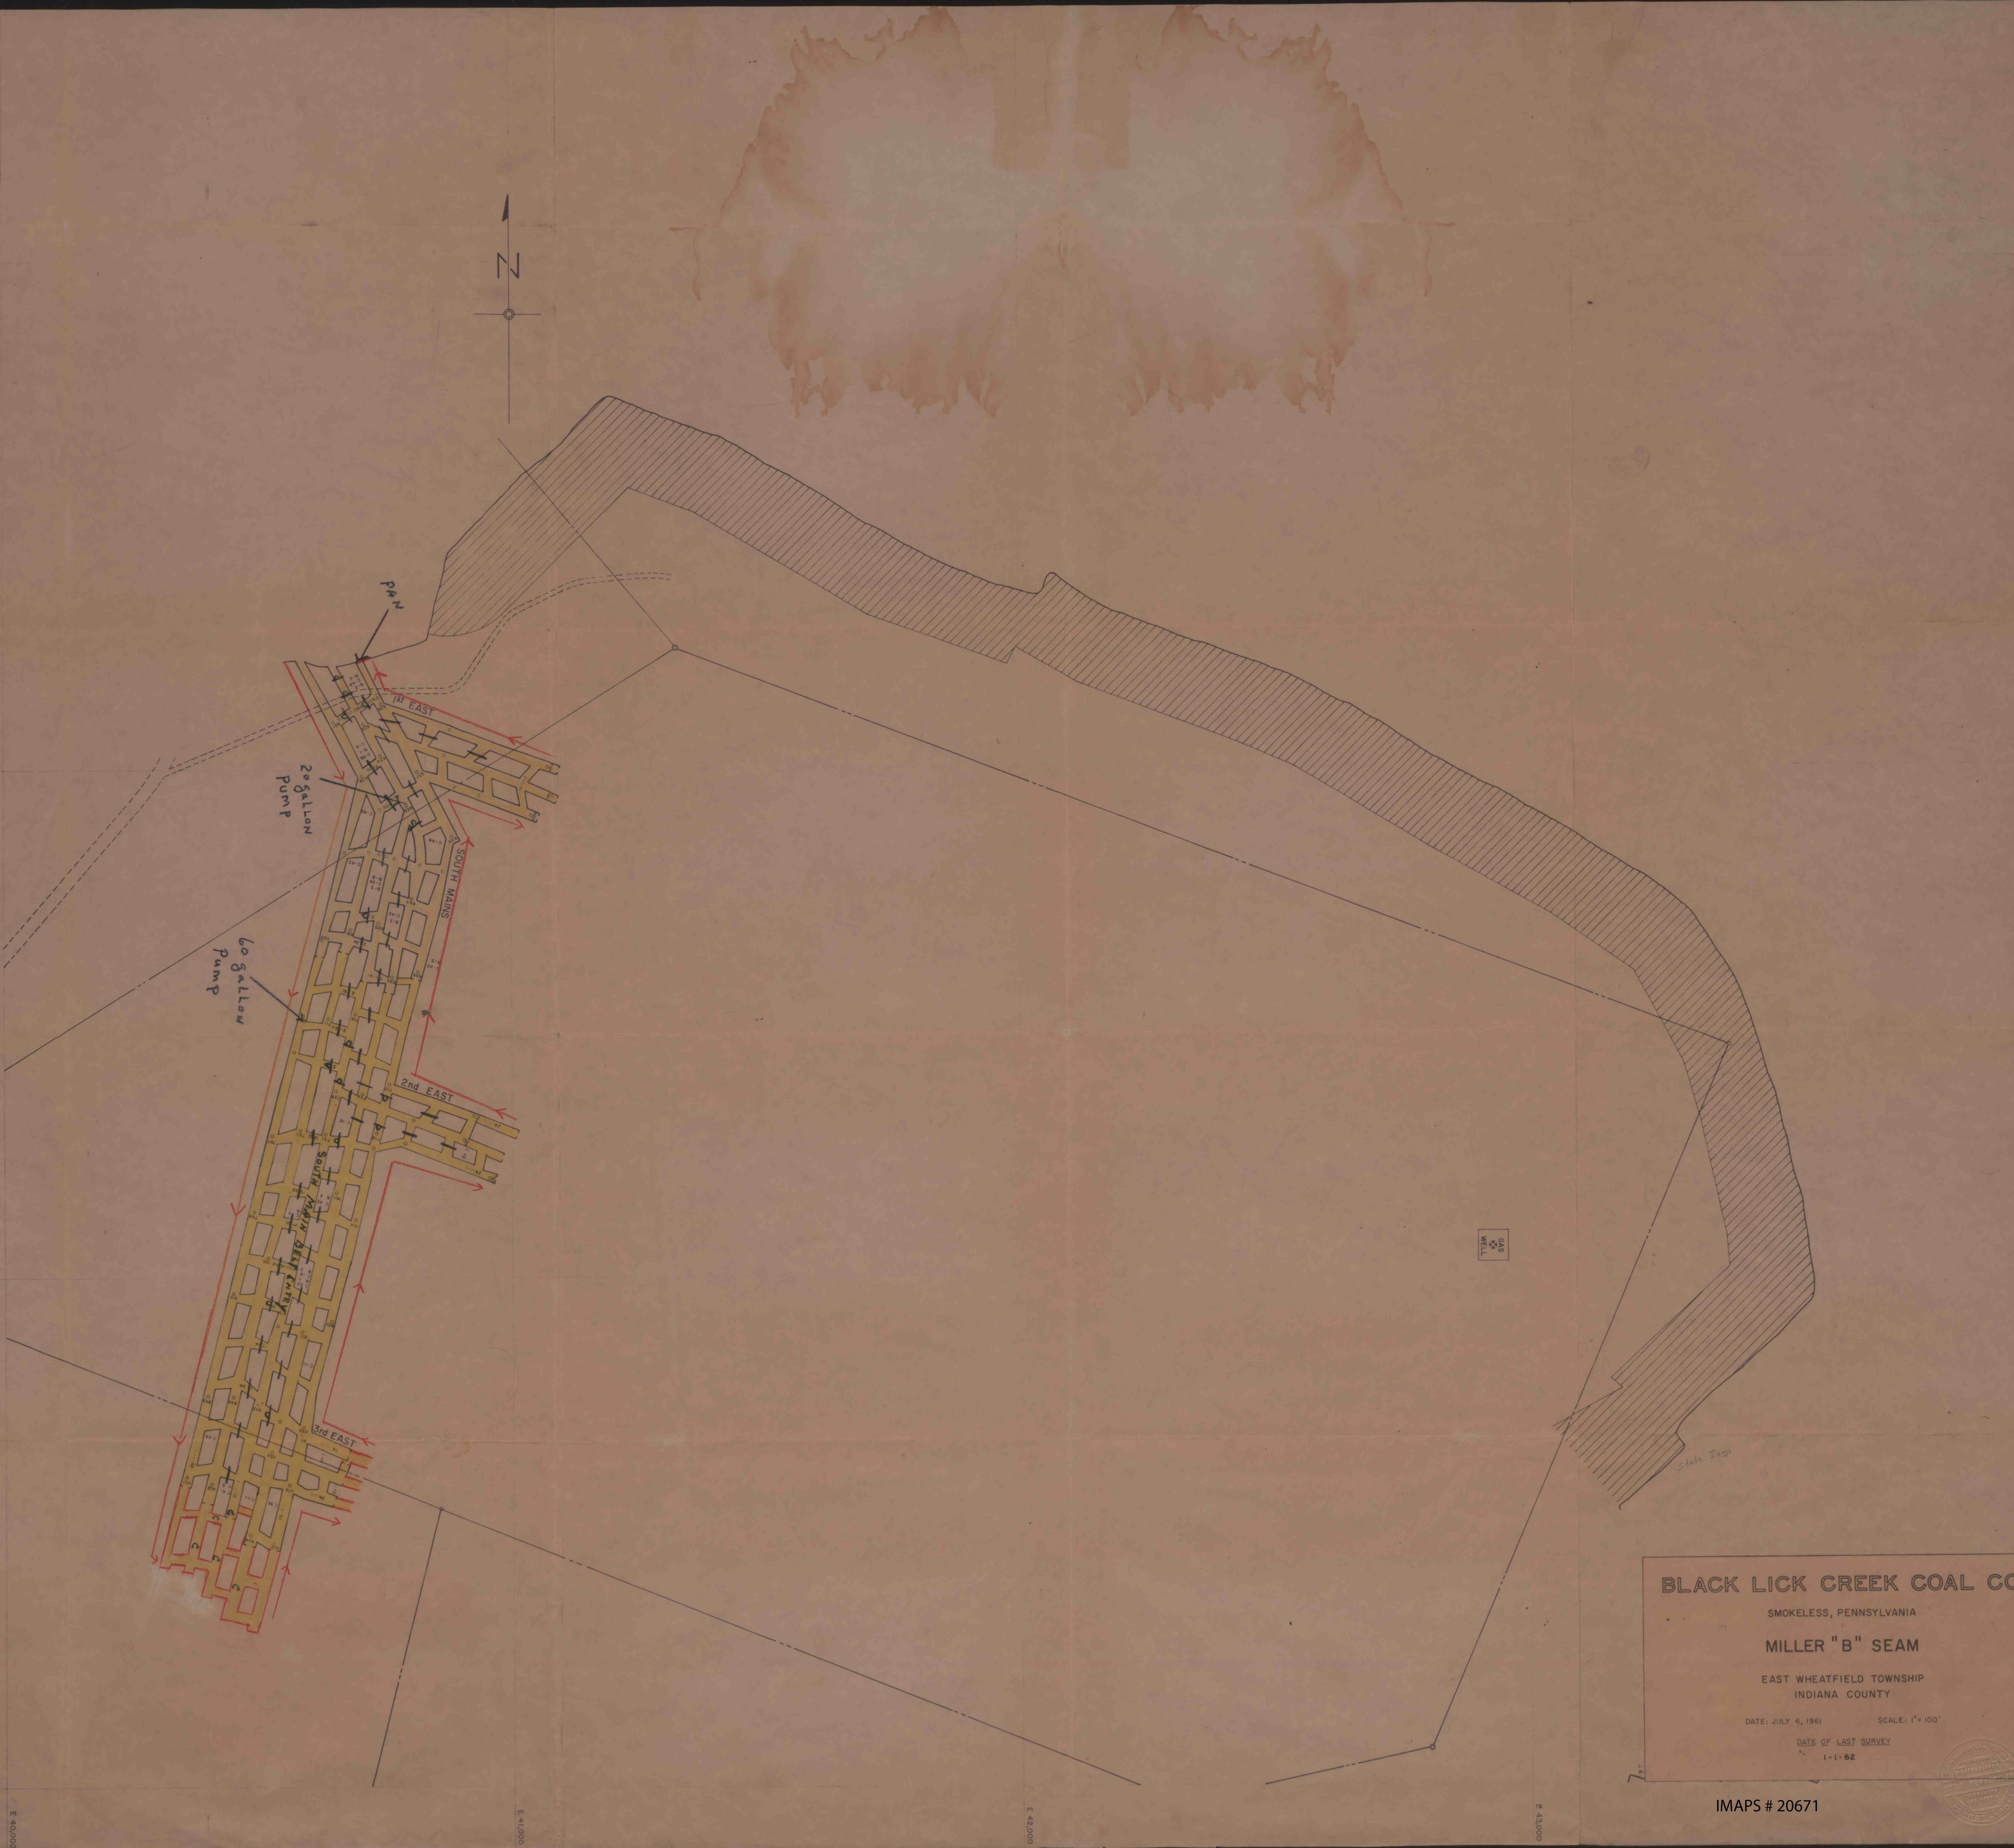

BLACK LICK CREEK COAL CO
SMOKELESS, PENNSYLVANIA
MILLER "B" SEAM
EAST WHEATFIELD TOWNSHIP
INDIANA COUNTY
DATE: JULY 6, 1961 SCALE: 1" = 100'
DATE OF LAST SURVEY
1-1-62

IMAPS # 20671

