
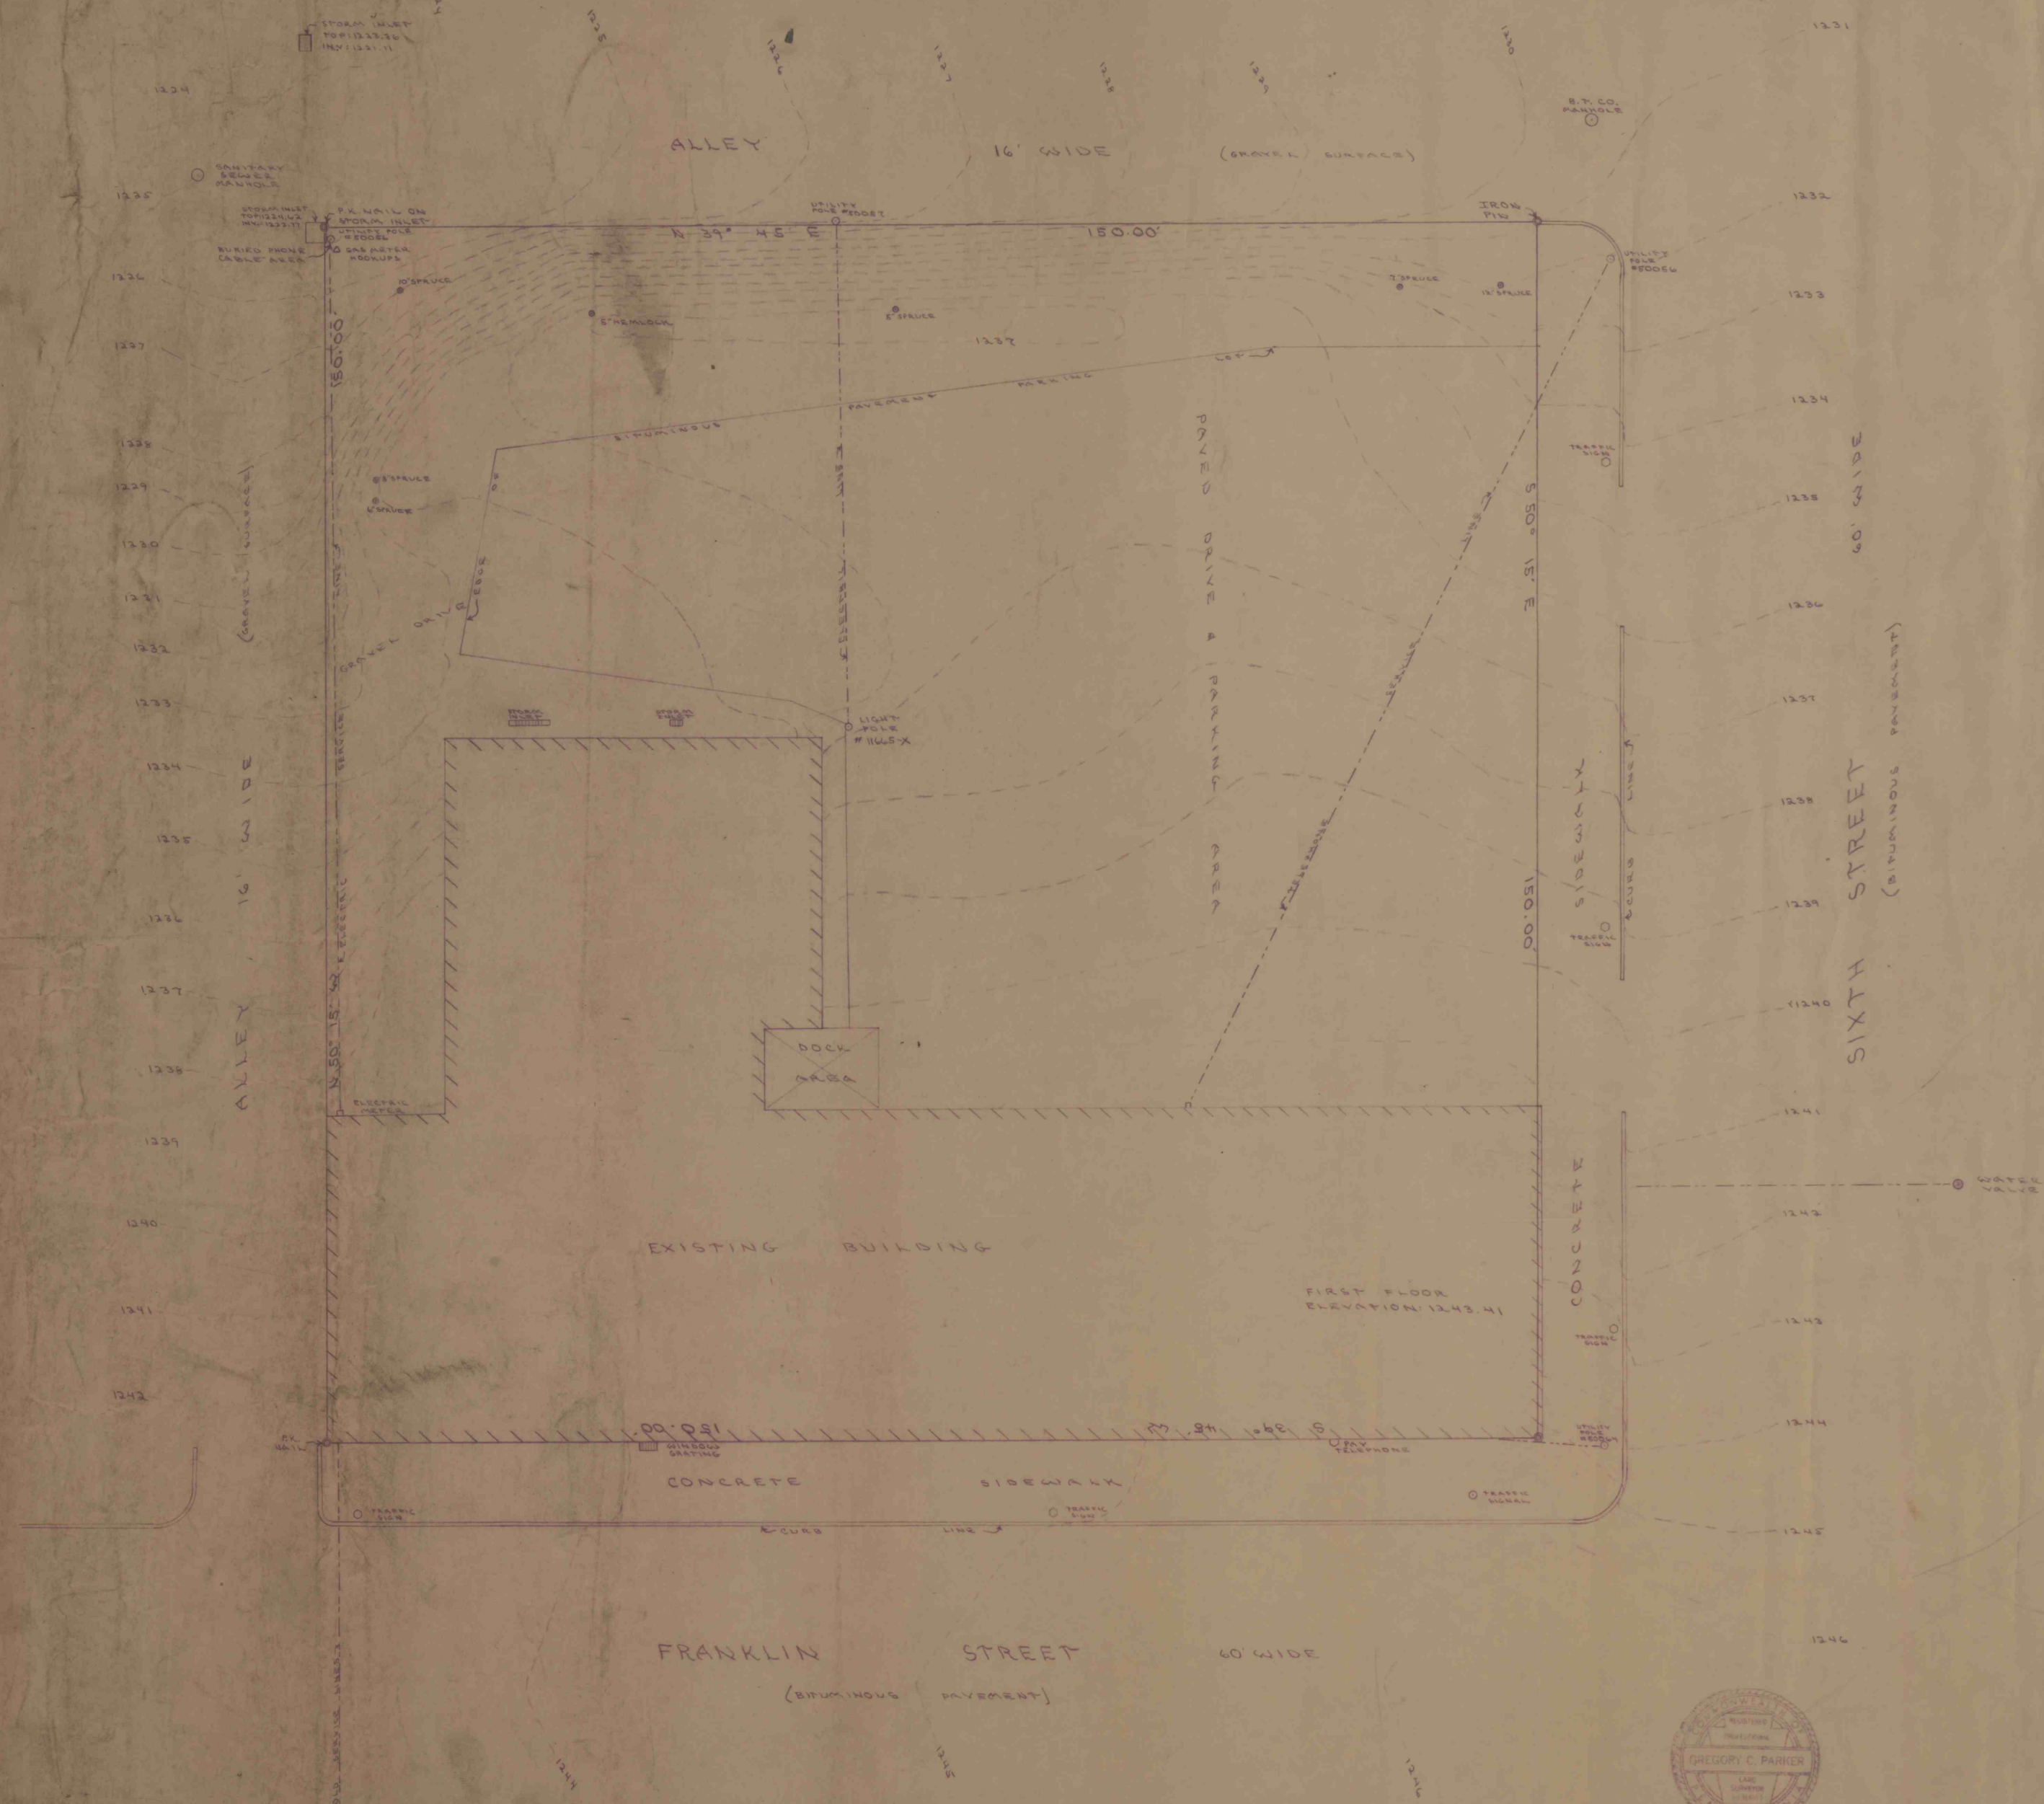


Handwritten notes: *1/15 Survey done*
4/8/66
2004

NIP LEVINSON REALTY CO.

NIP AL SCENGO

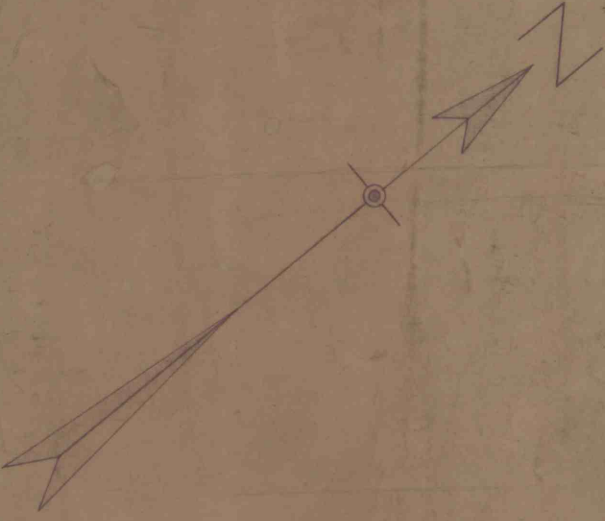

NOTE: ELEVATIONS BASED ON ASSUMED DATUM

UNI-MART INC.	
RUSSELLVILLE COAL CO. TRACT	
CLYMER BOROUGH INDIANA COUNTY	
R. B. SHANNON & ASSOCIATES, INDIANA, PA.	
DRAWN BY G. E. P.	DATE SEP. 12, 1966
SCALE 1"=10'	DRAWING NO. 6327

IMAPS # 20696