


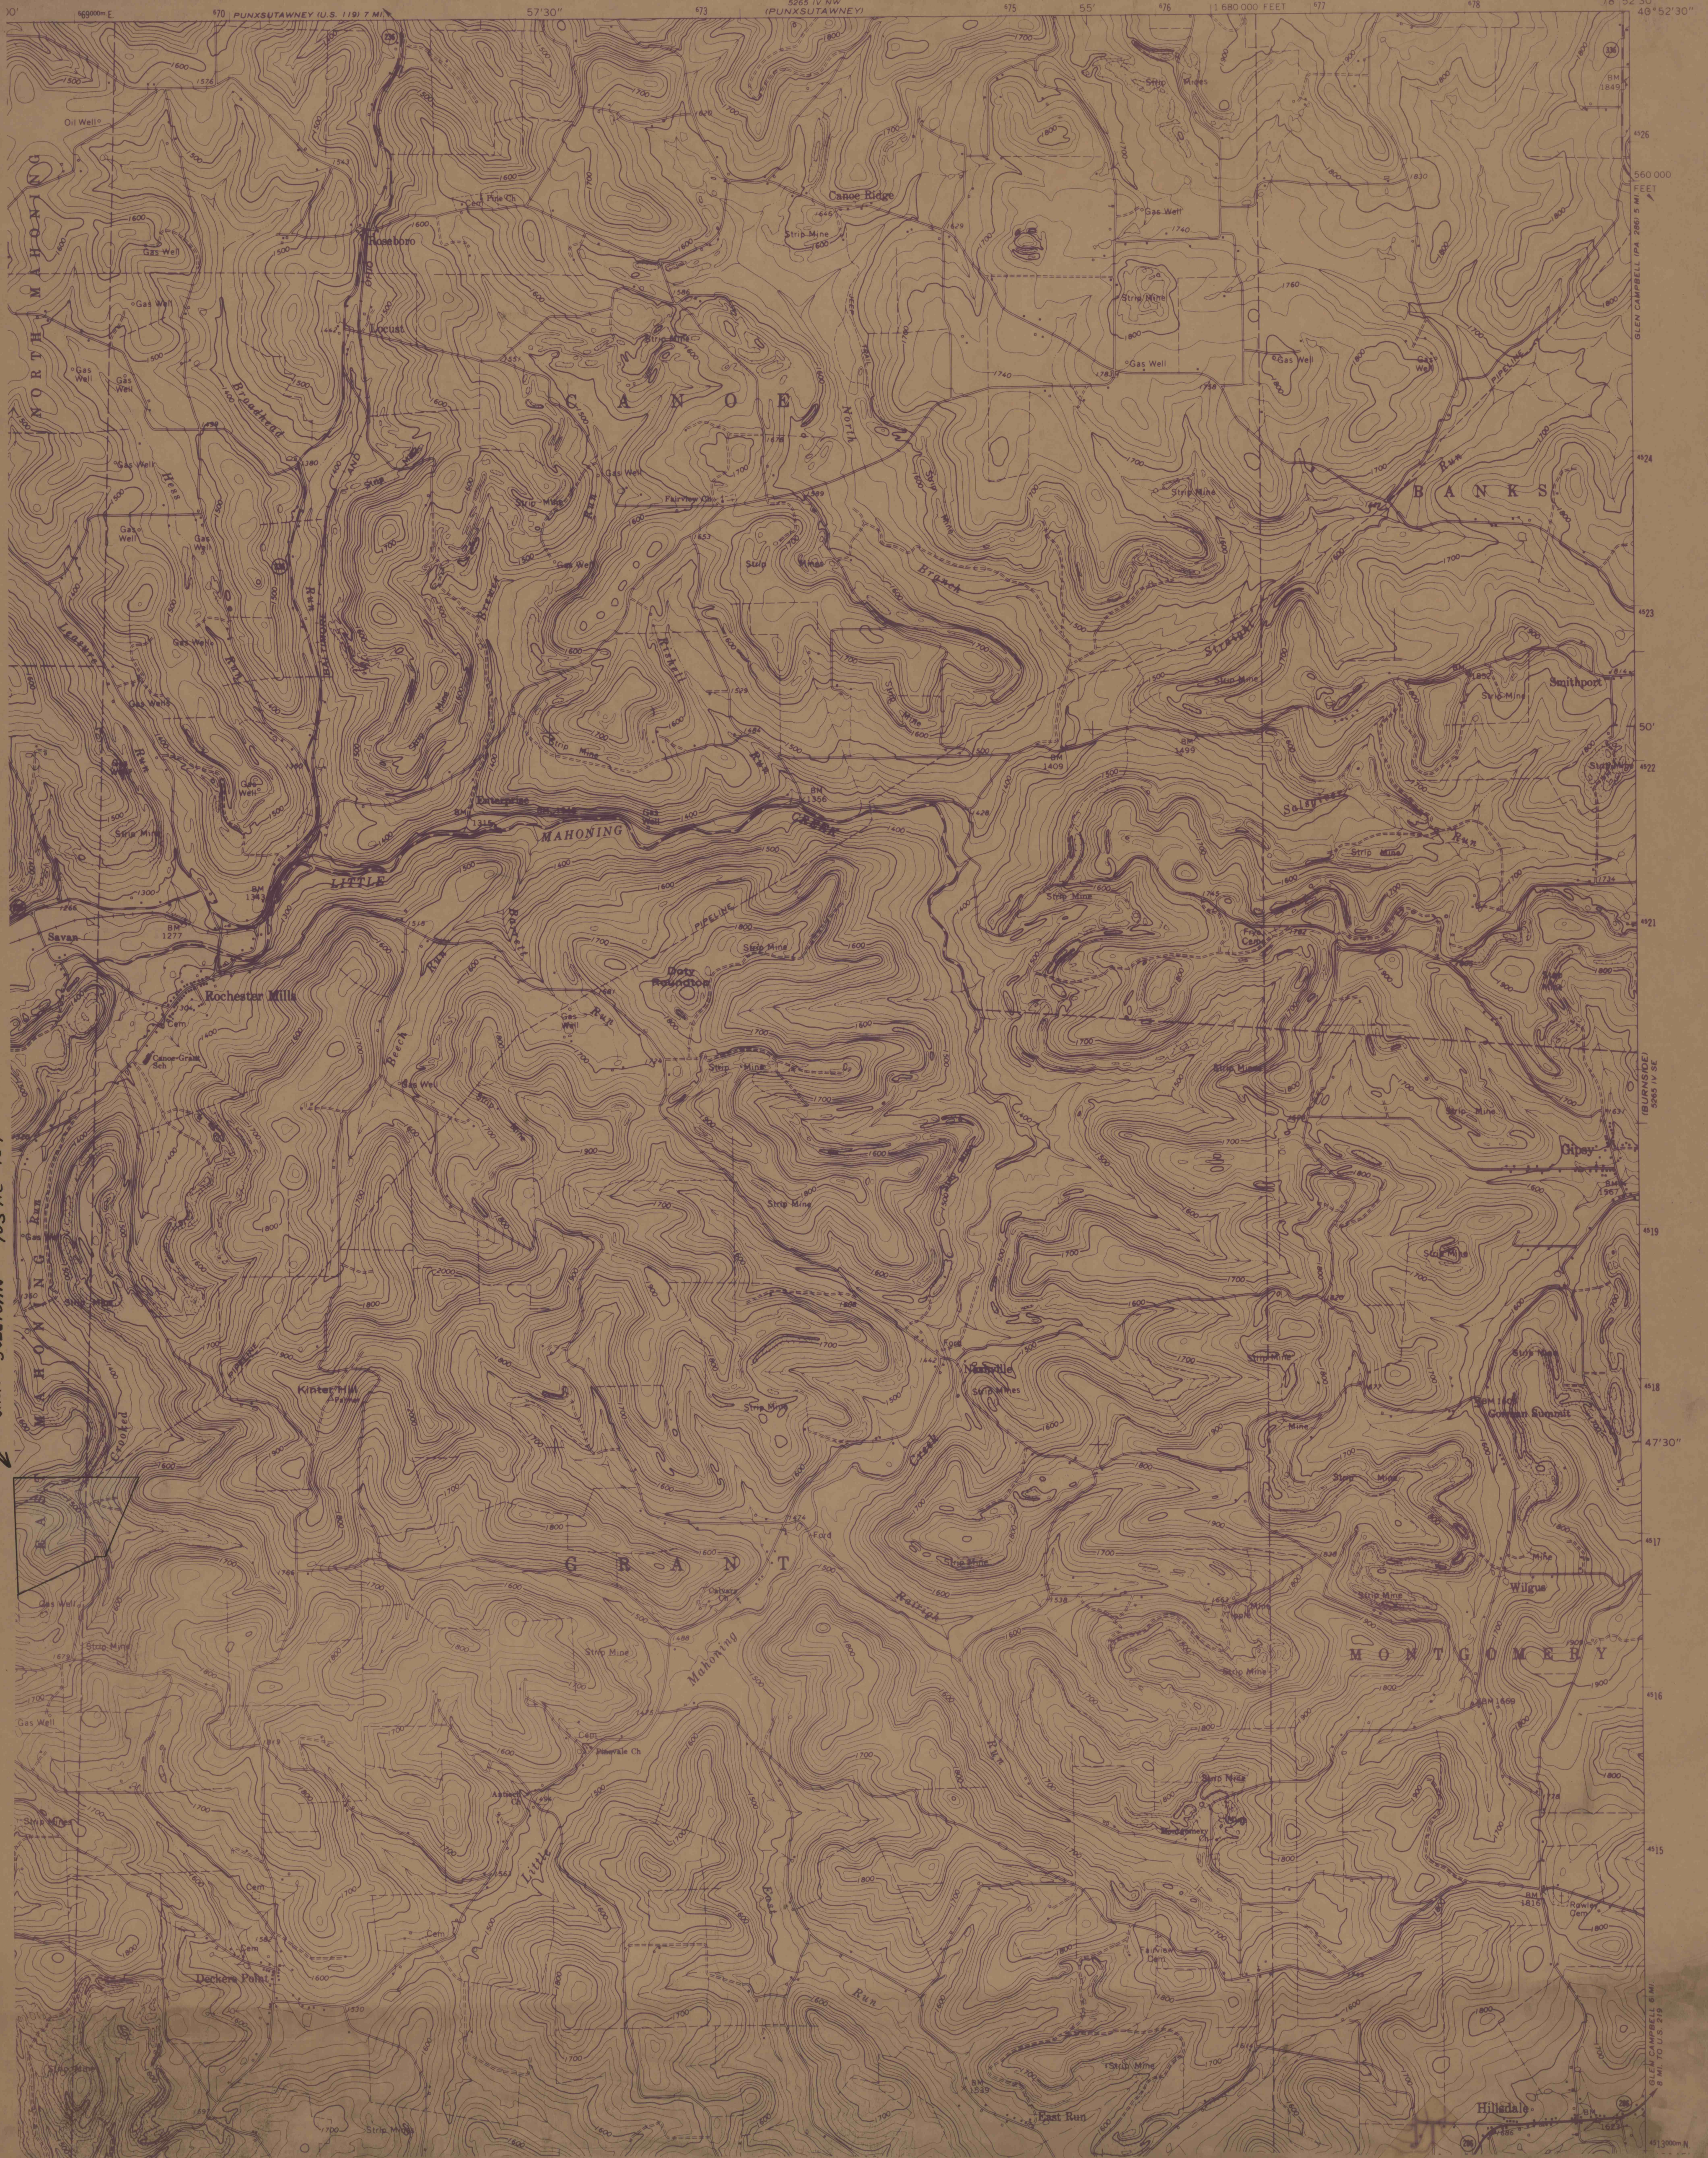

JACK SULLIVAN 103 AC 15 P

IMAPS#20709