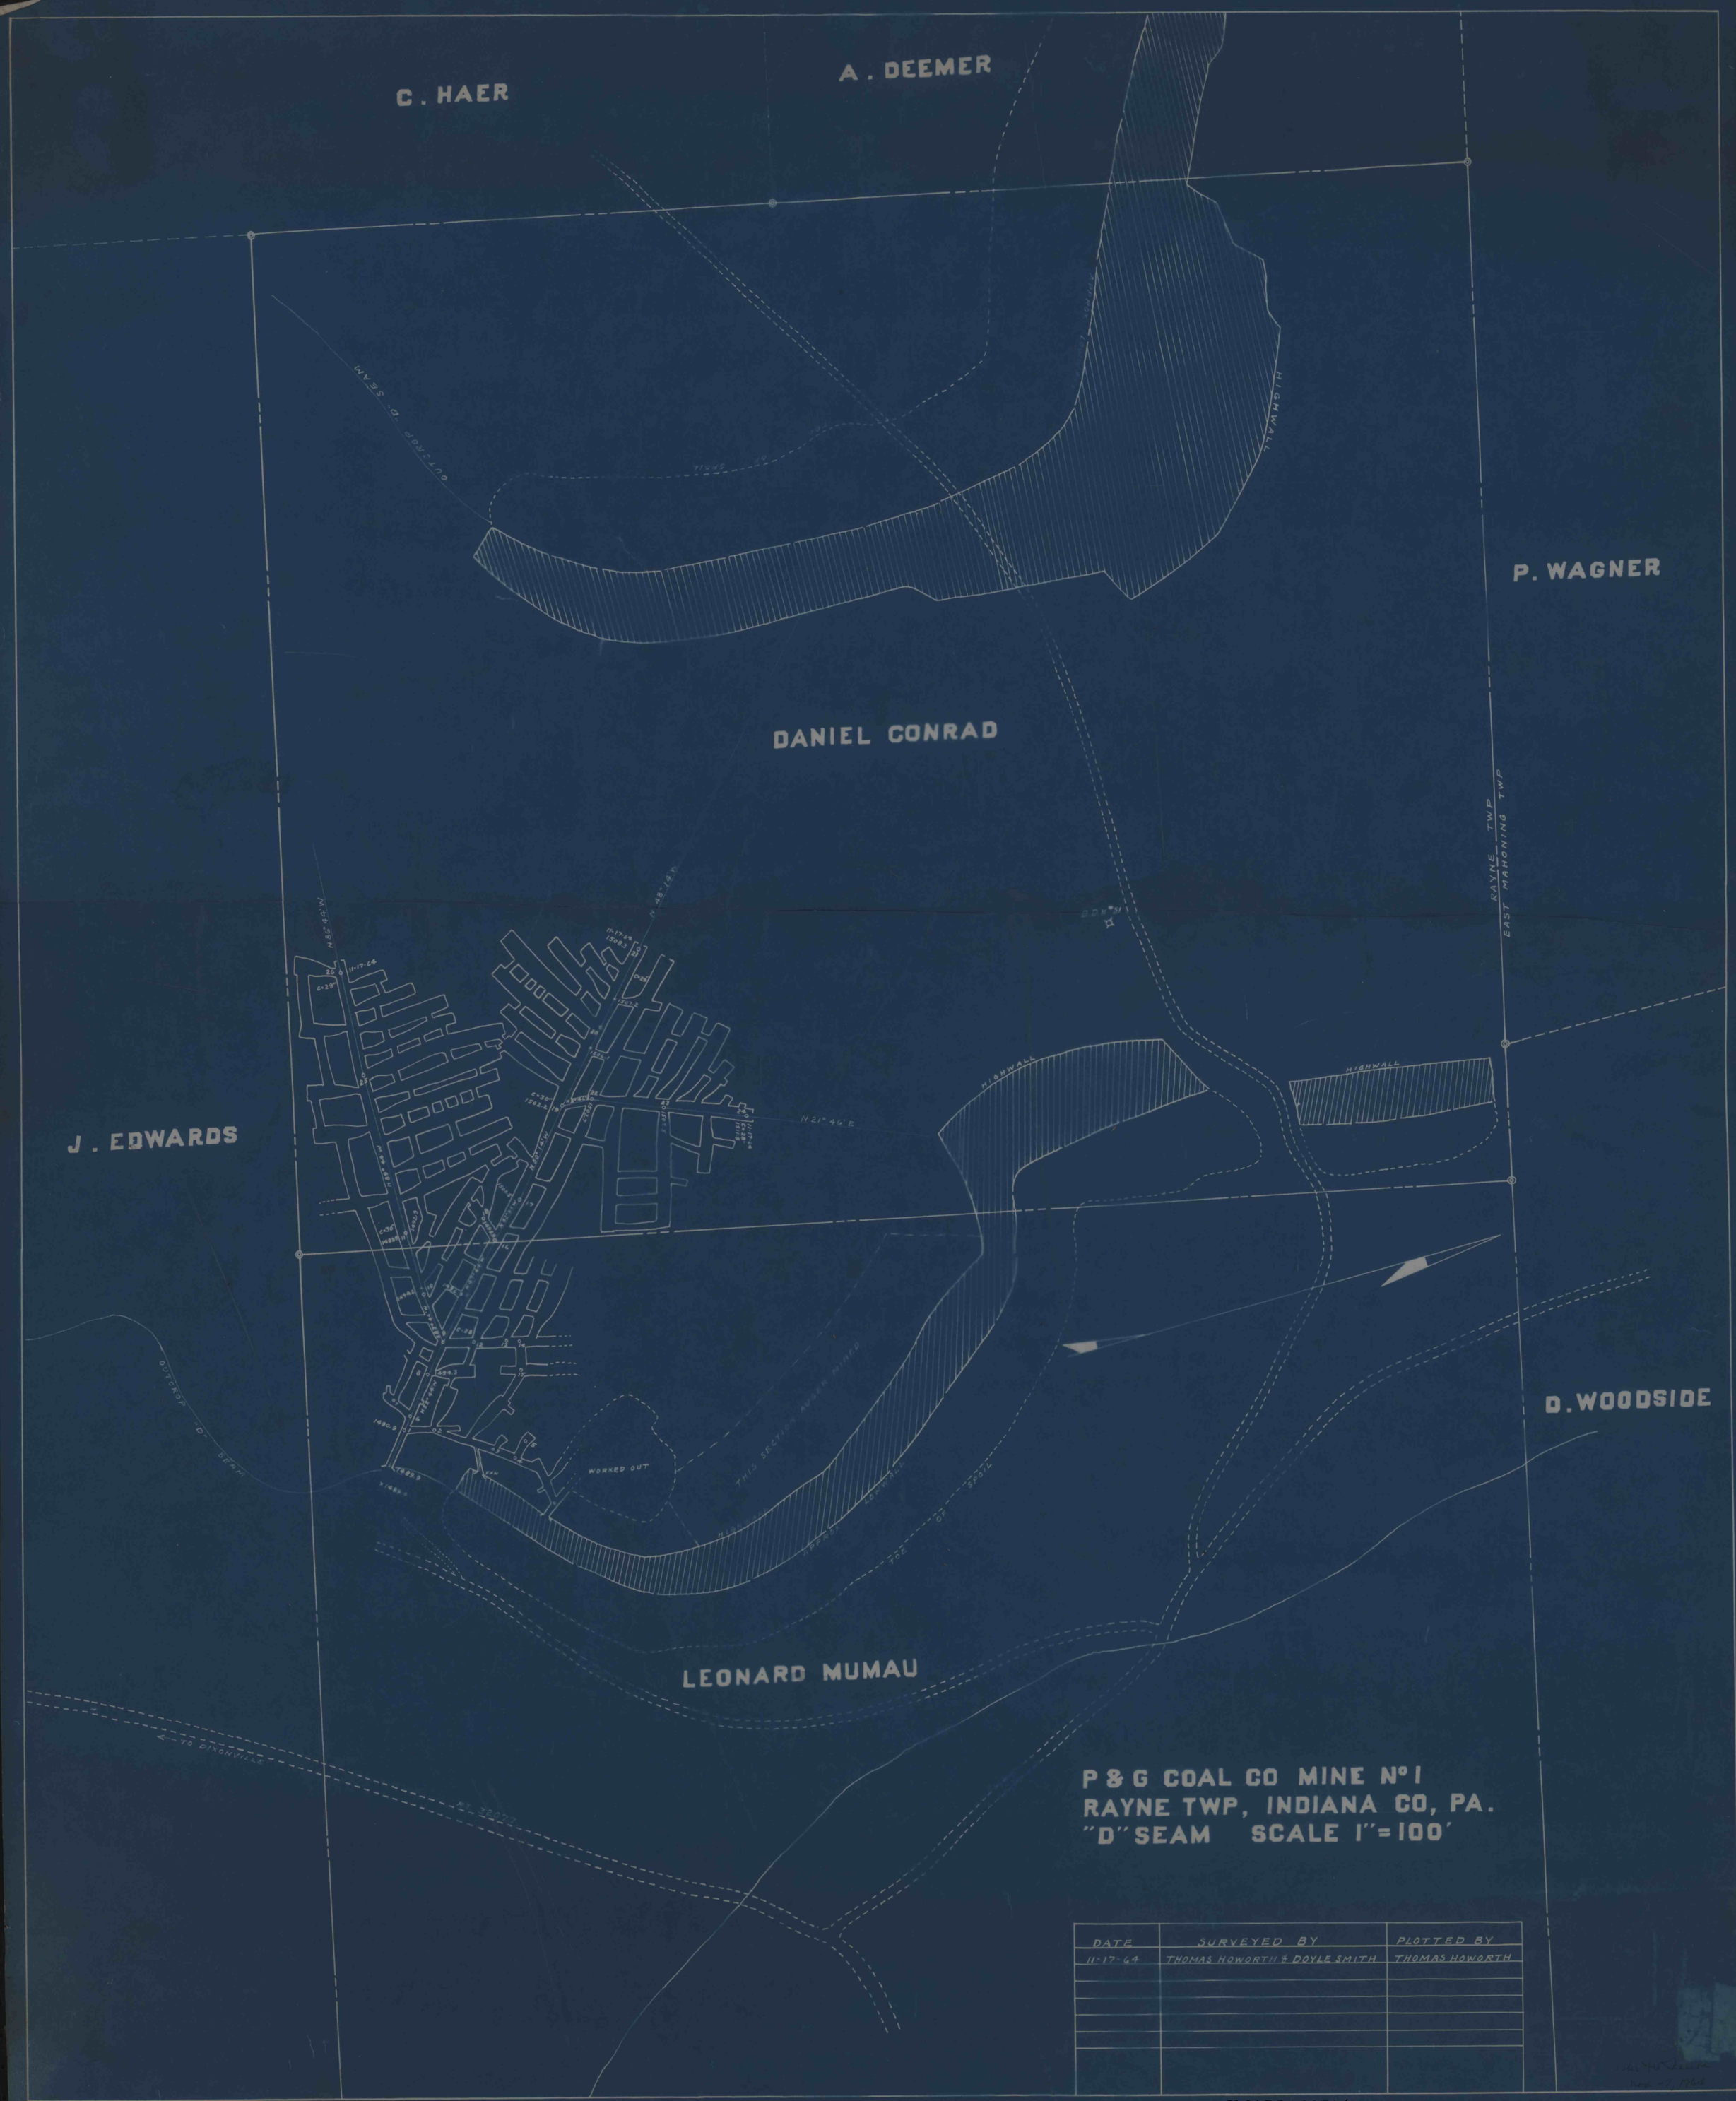
C. HAER
A. DEEMER
P. WAGNER
DANIEL CONRAD
J. EDWARDS
D. WOODSIDE
LEONARD MUMAU
HIGHWALL
OUTCROP "D" SEAM
RAYNE TWP
EAST MAHONING TWP
N 21° 46' E
N 85° 44' W
N 48° 14' W
WORKED OUT
TO DIXONVILLE
P & G COAL CO MINE Nº 1
RAYNE TWP, INDIANA CO, PA.
"D" SEAM SCALE 1" = 100'
DATE
SURVEYED BY
PLOTTED BY
11-17-64
THOMAS HOWORTH & DOYLE SMITH
THOMAS HOWORTH

IMAPS# 20714