


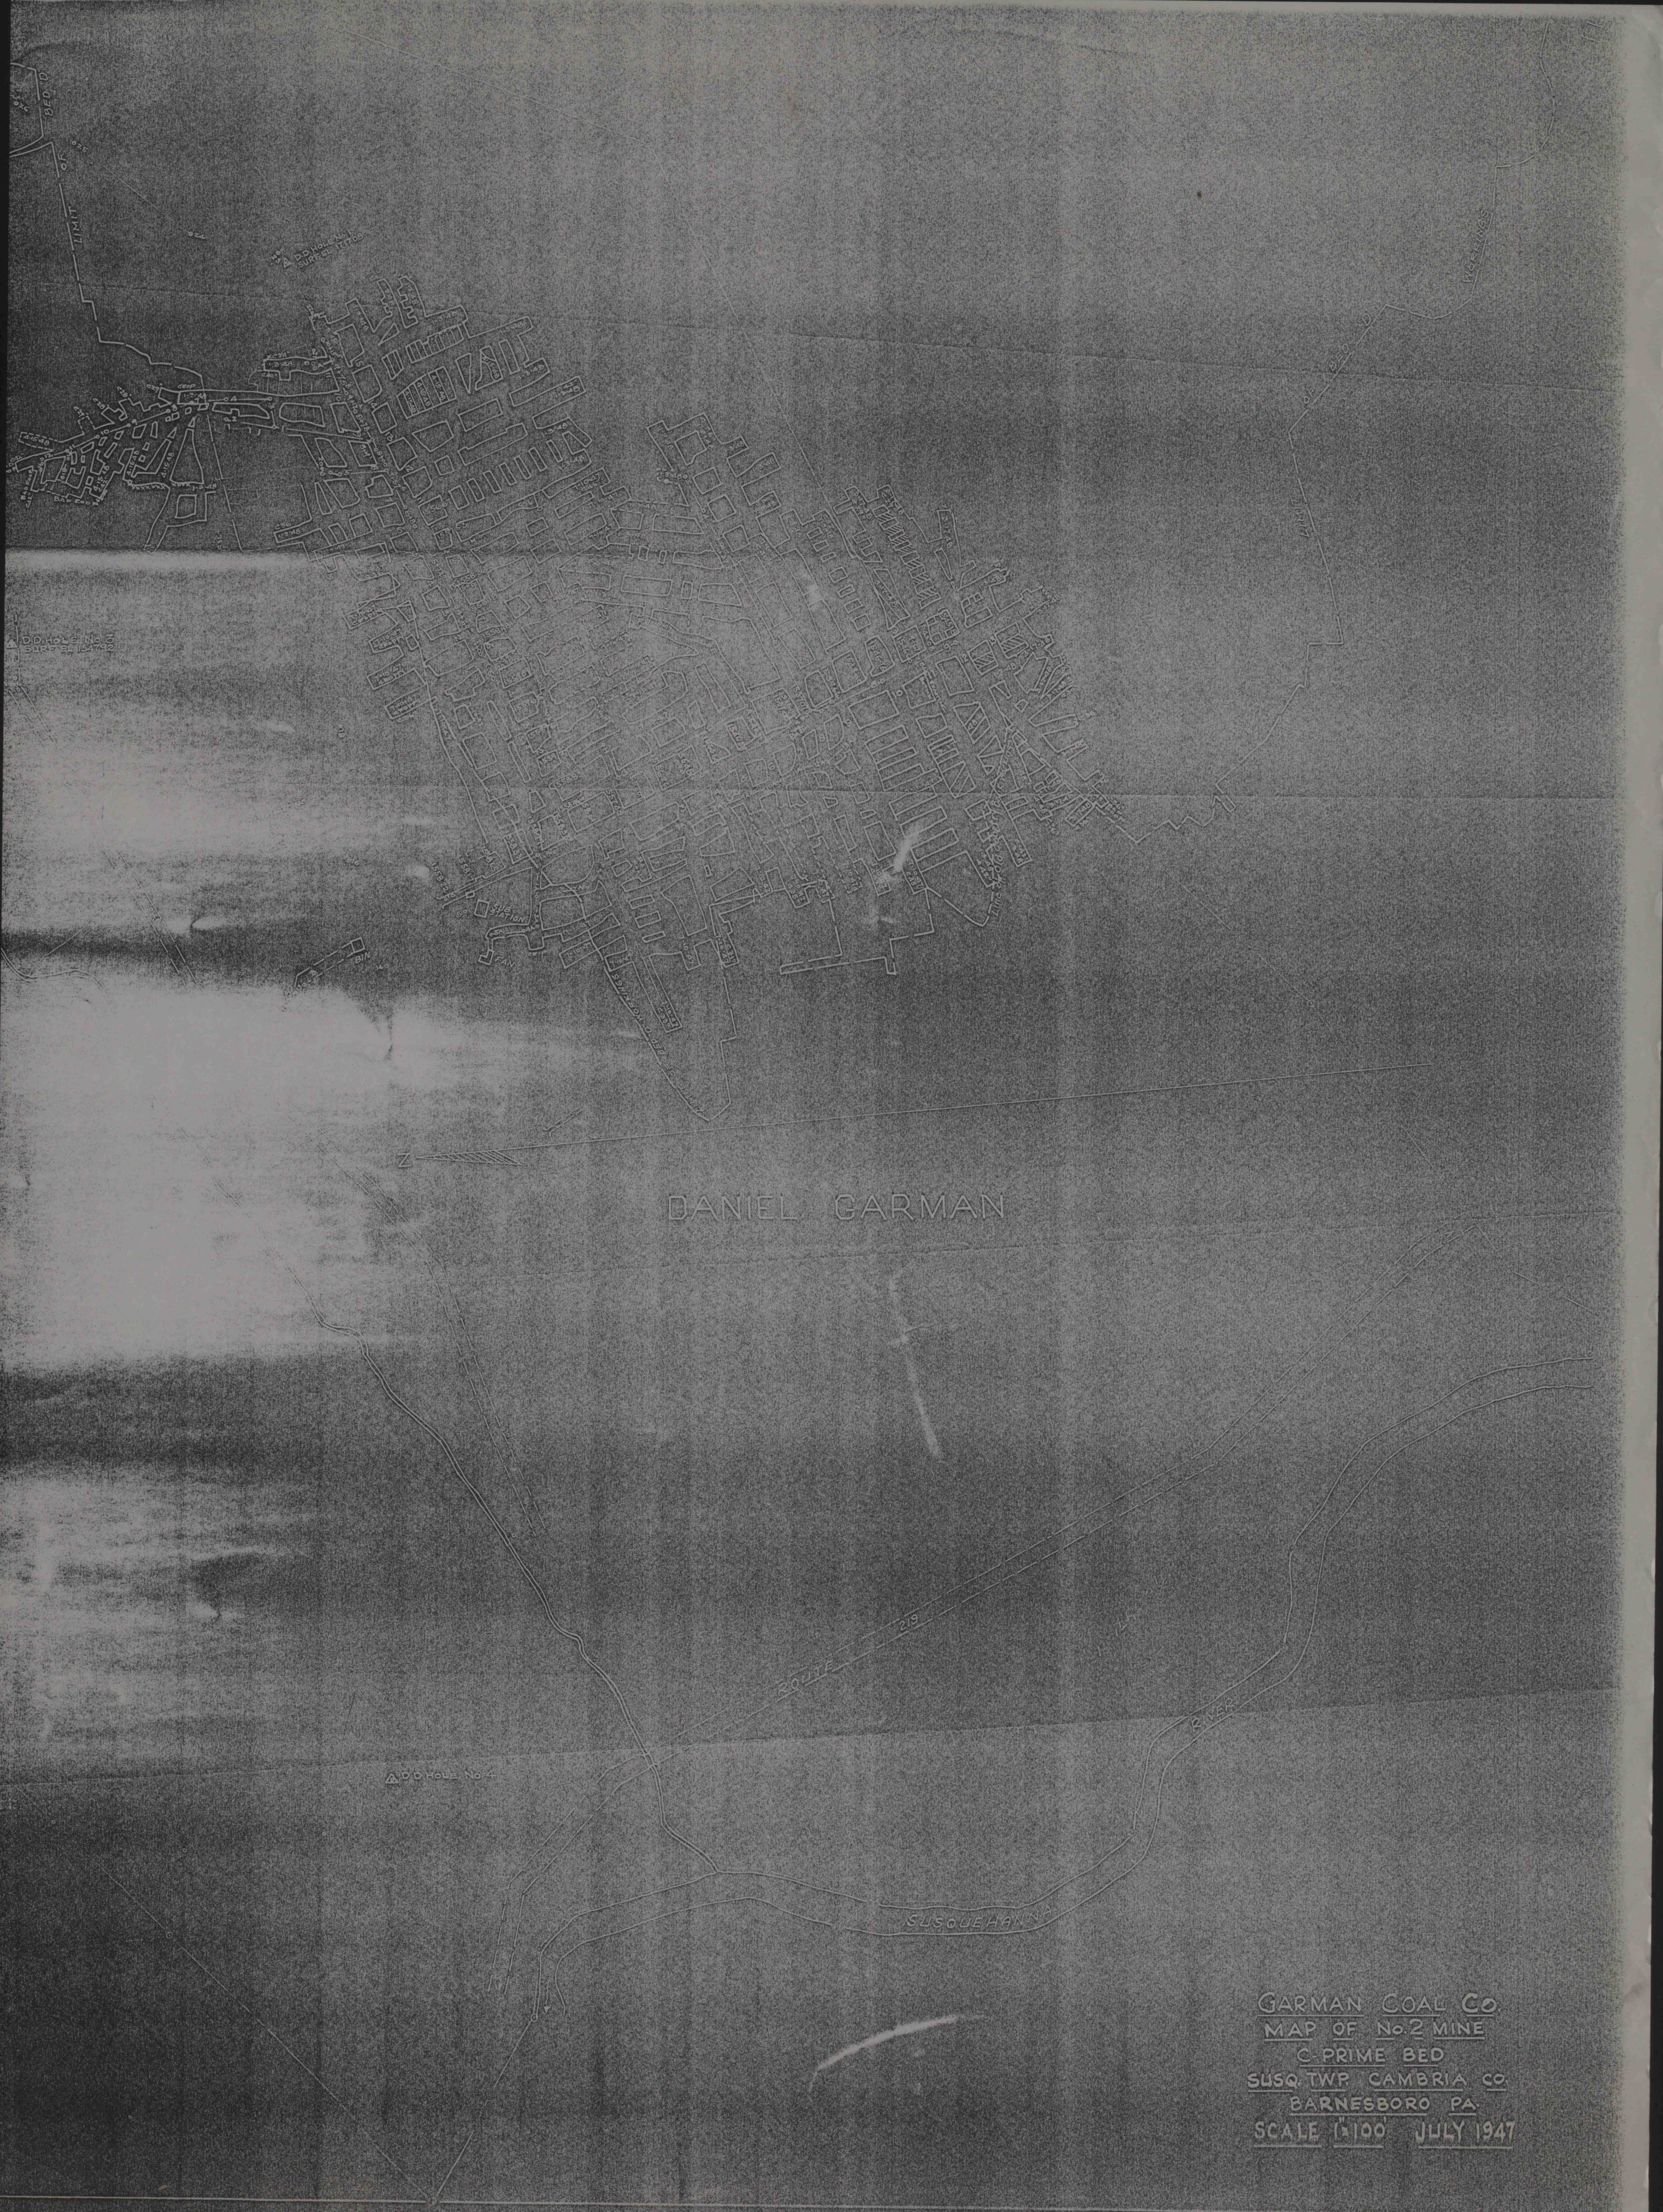

GARMAN COAL CO
MAP OF No. 2 MINE
C-PRIME BED
SUSQ. TWP. CAMBRIA CO.
BARNESBORO PA.
SCALE 1"=100' JULY 1947