


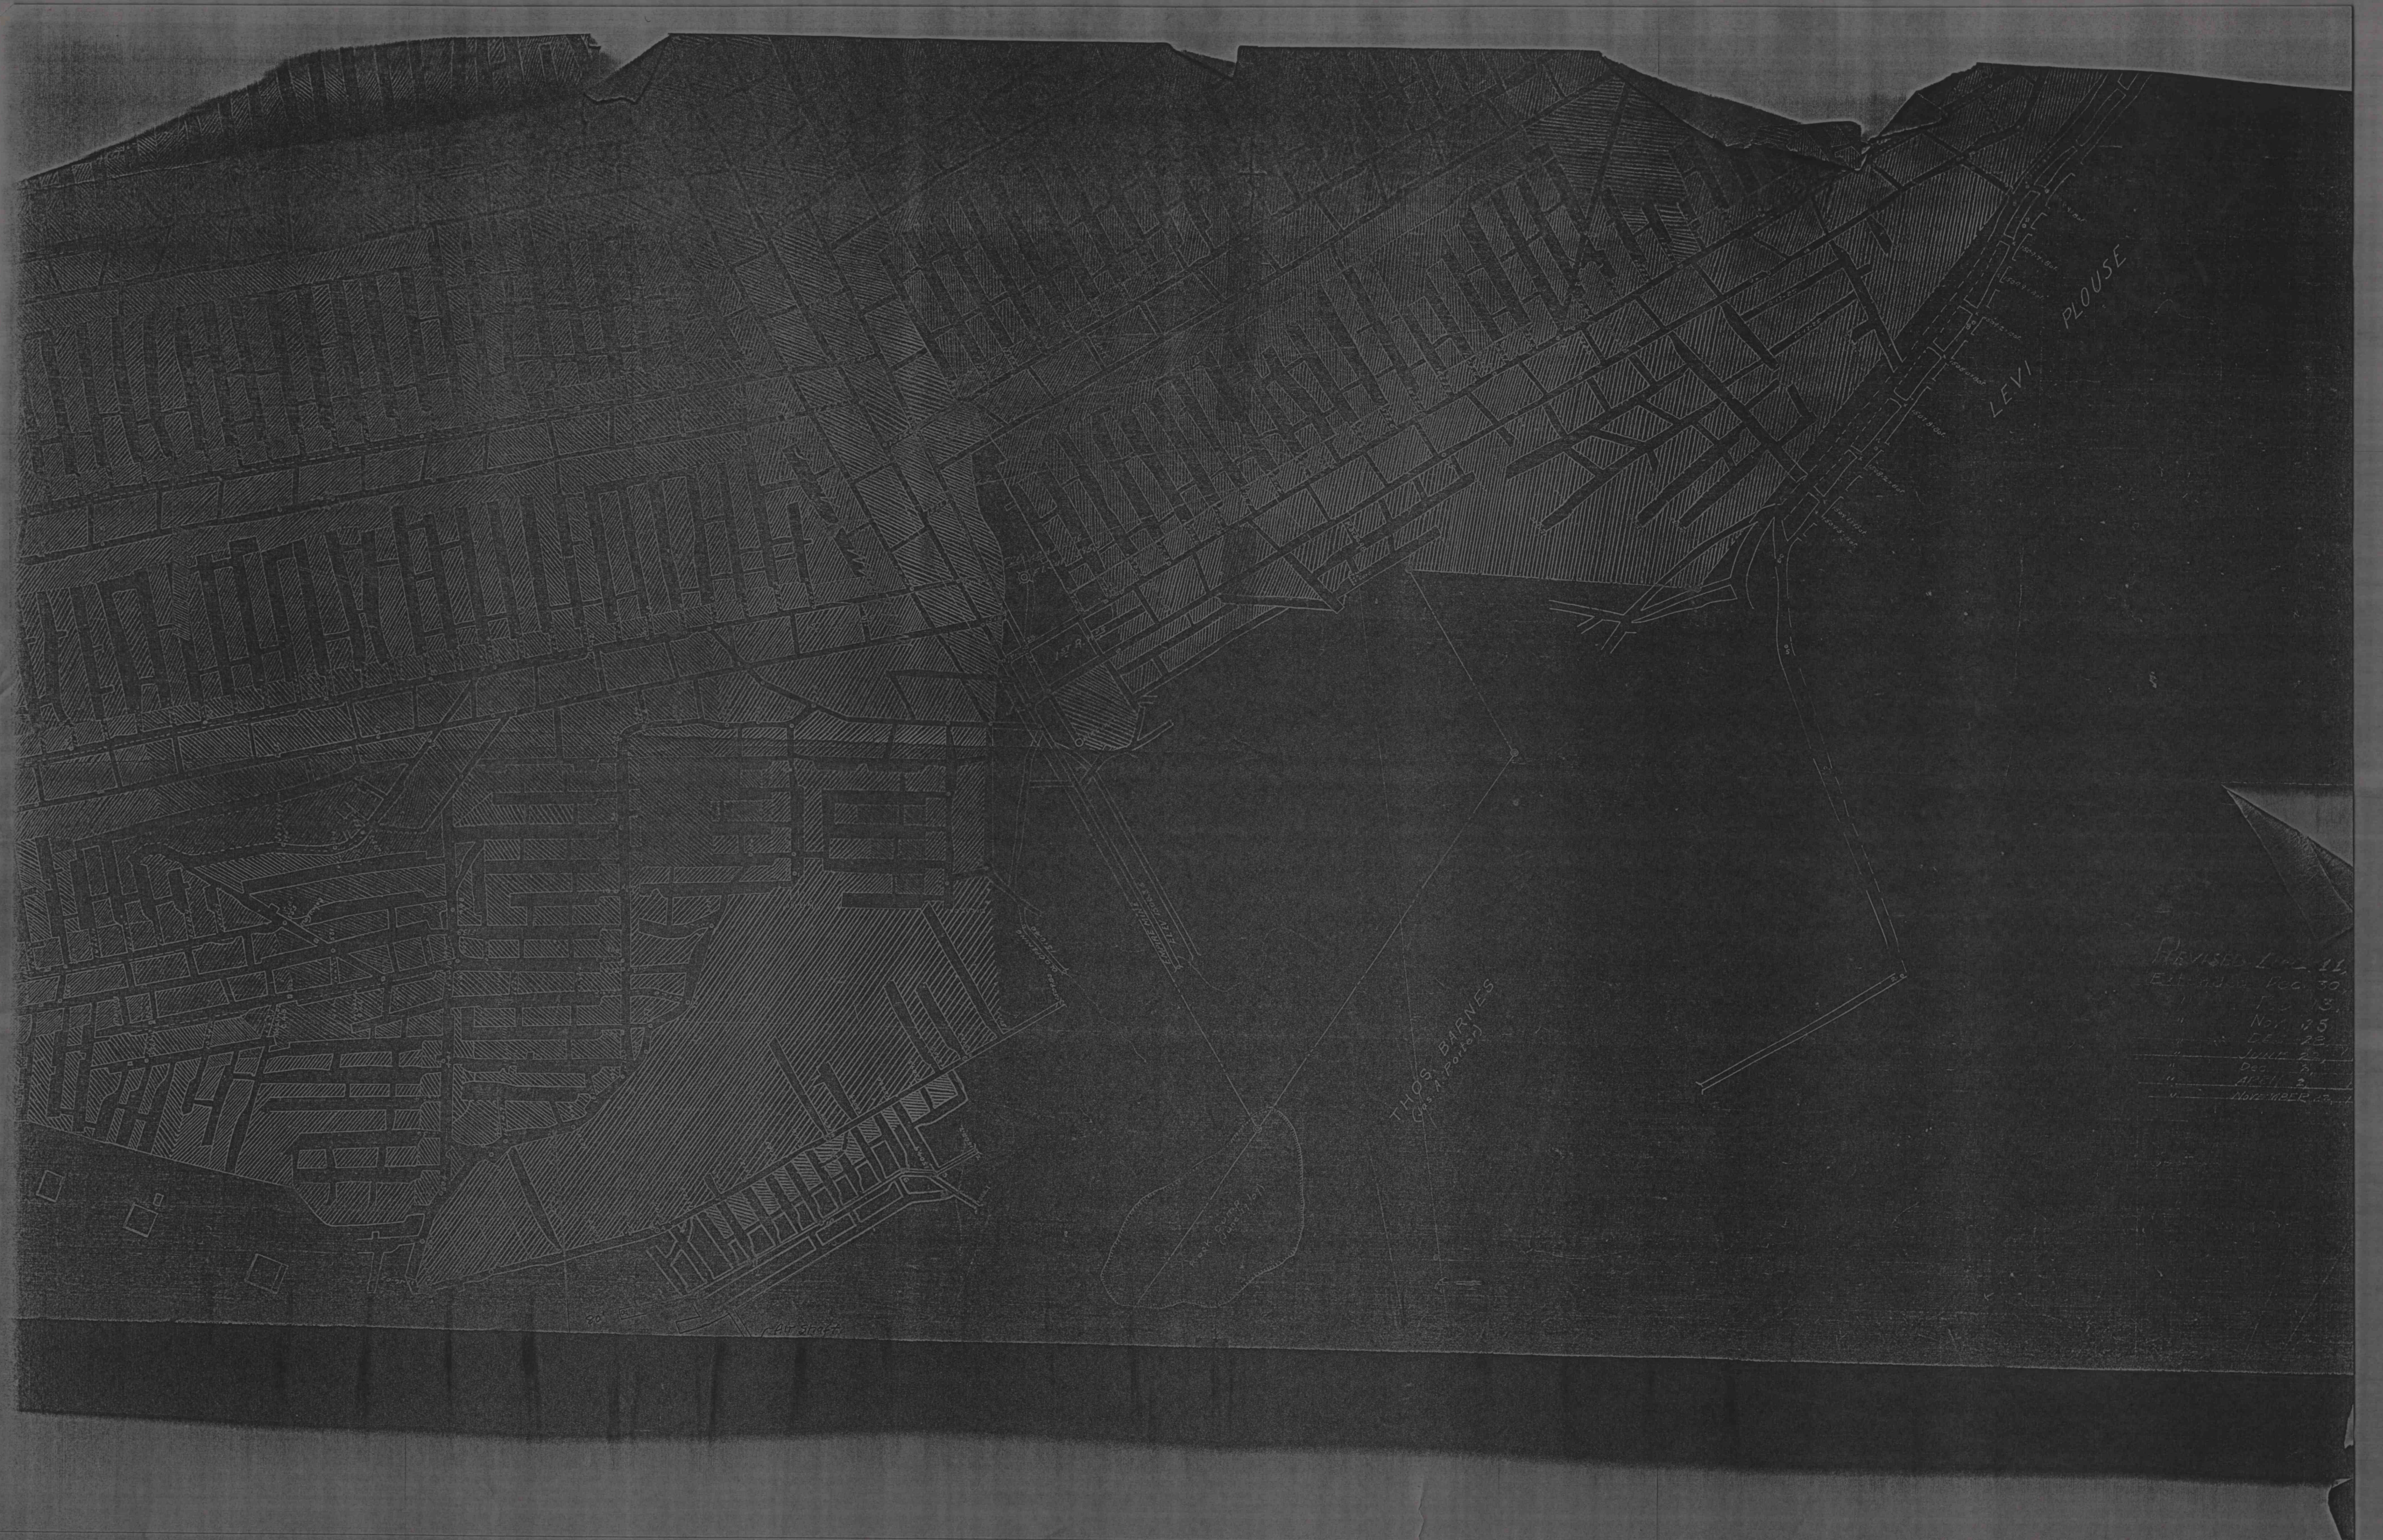

Revised Jan. 11  
