


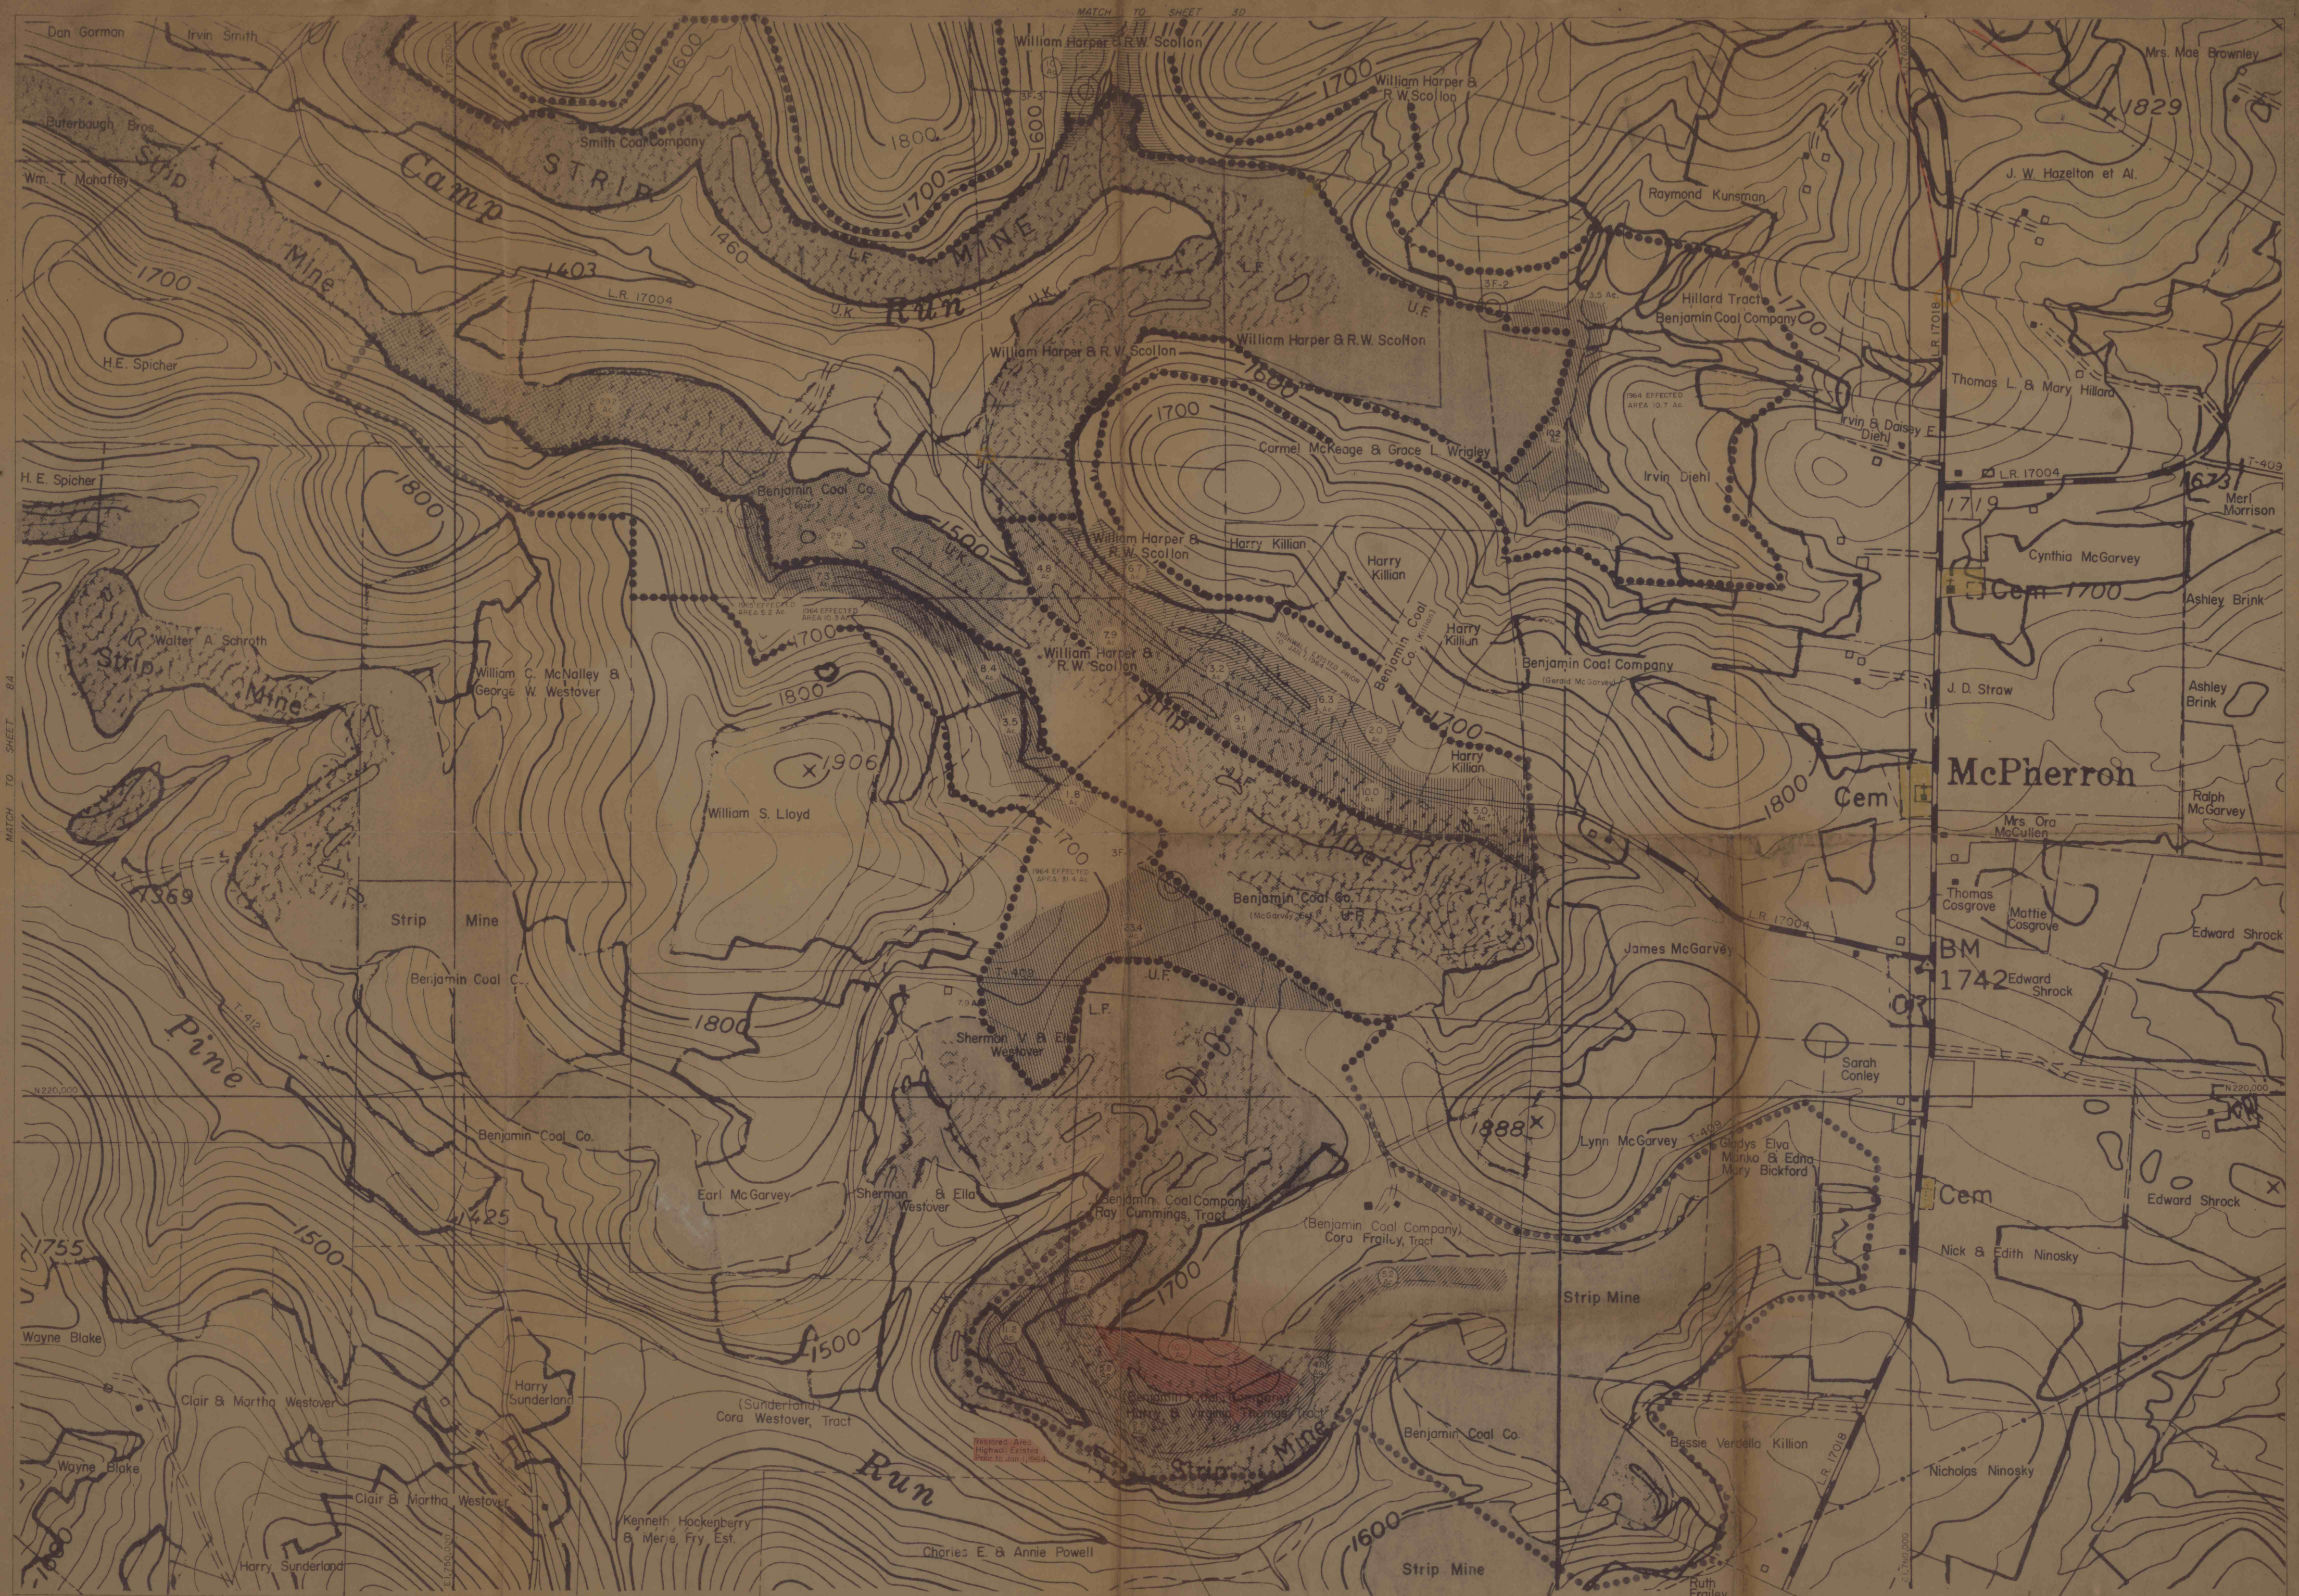

This map prepared by L. Robert Kimball, Consulting Engineers, Ebensburg, Pennsylvania, from enlargements of U.S.G.S. quadrangles & maps by others.



U.K. = Upper Kittanning Vein
L.F. = Lower Freeport Vein
U.F. = Upper Freeport Vein
Drill Hole or Existing Highway

1965 Proposed Effective Area
Previous Effective Area
Proposed Permitted Area

1964 Effective Area
Approximate Highway
Approximate Location of
Approximate Coal Outcrop

Proposed Permitted Area
Used in 1965
Backfilled Under Provisions
of the Law
Built Under Provisions
of New Law



REVISIONS: OCT 26, 1965
REVISED: DEC 1, 1965

JAN 1964
MAY 15, 1964
JUNE 23, 1964
OCT 16, 1964
JAN 20, 1965
MARCH 12, 1965
MAY 13, 1965
AUG 19, 1965
OCT 1, 1965

Chest Township
Scale: 1" = 400'

BENJAMIN COAL COMPANY
Area #3
Clearfield County, Pennsylvania
November, 1963
Sheet 3F

MAPS#20751