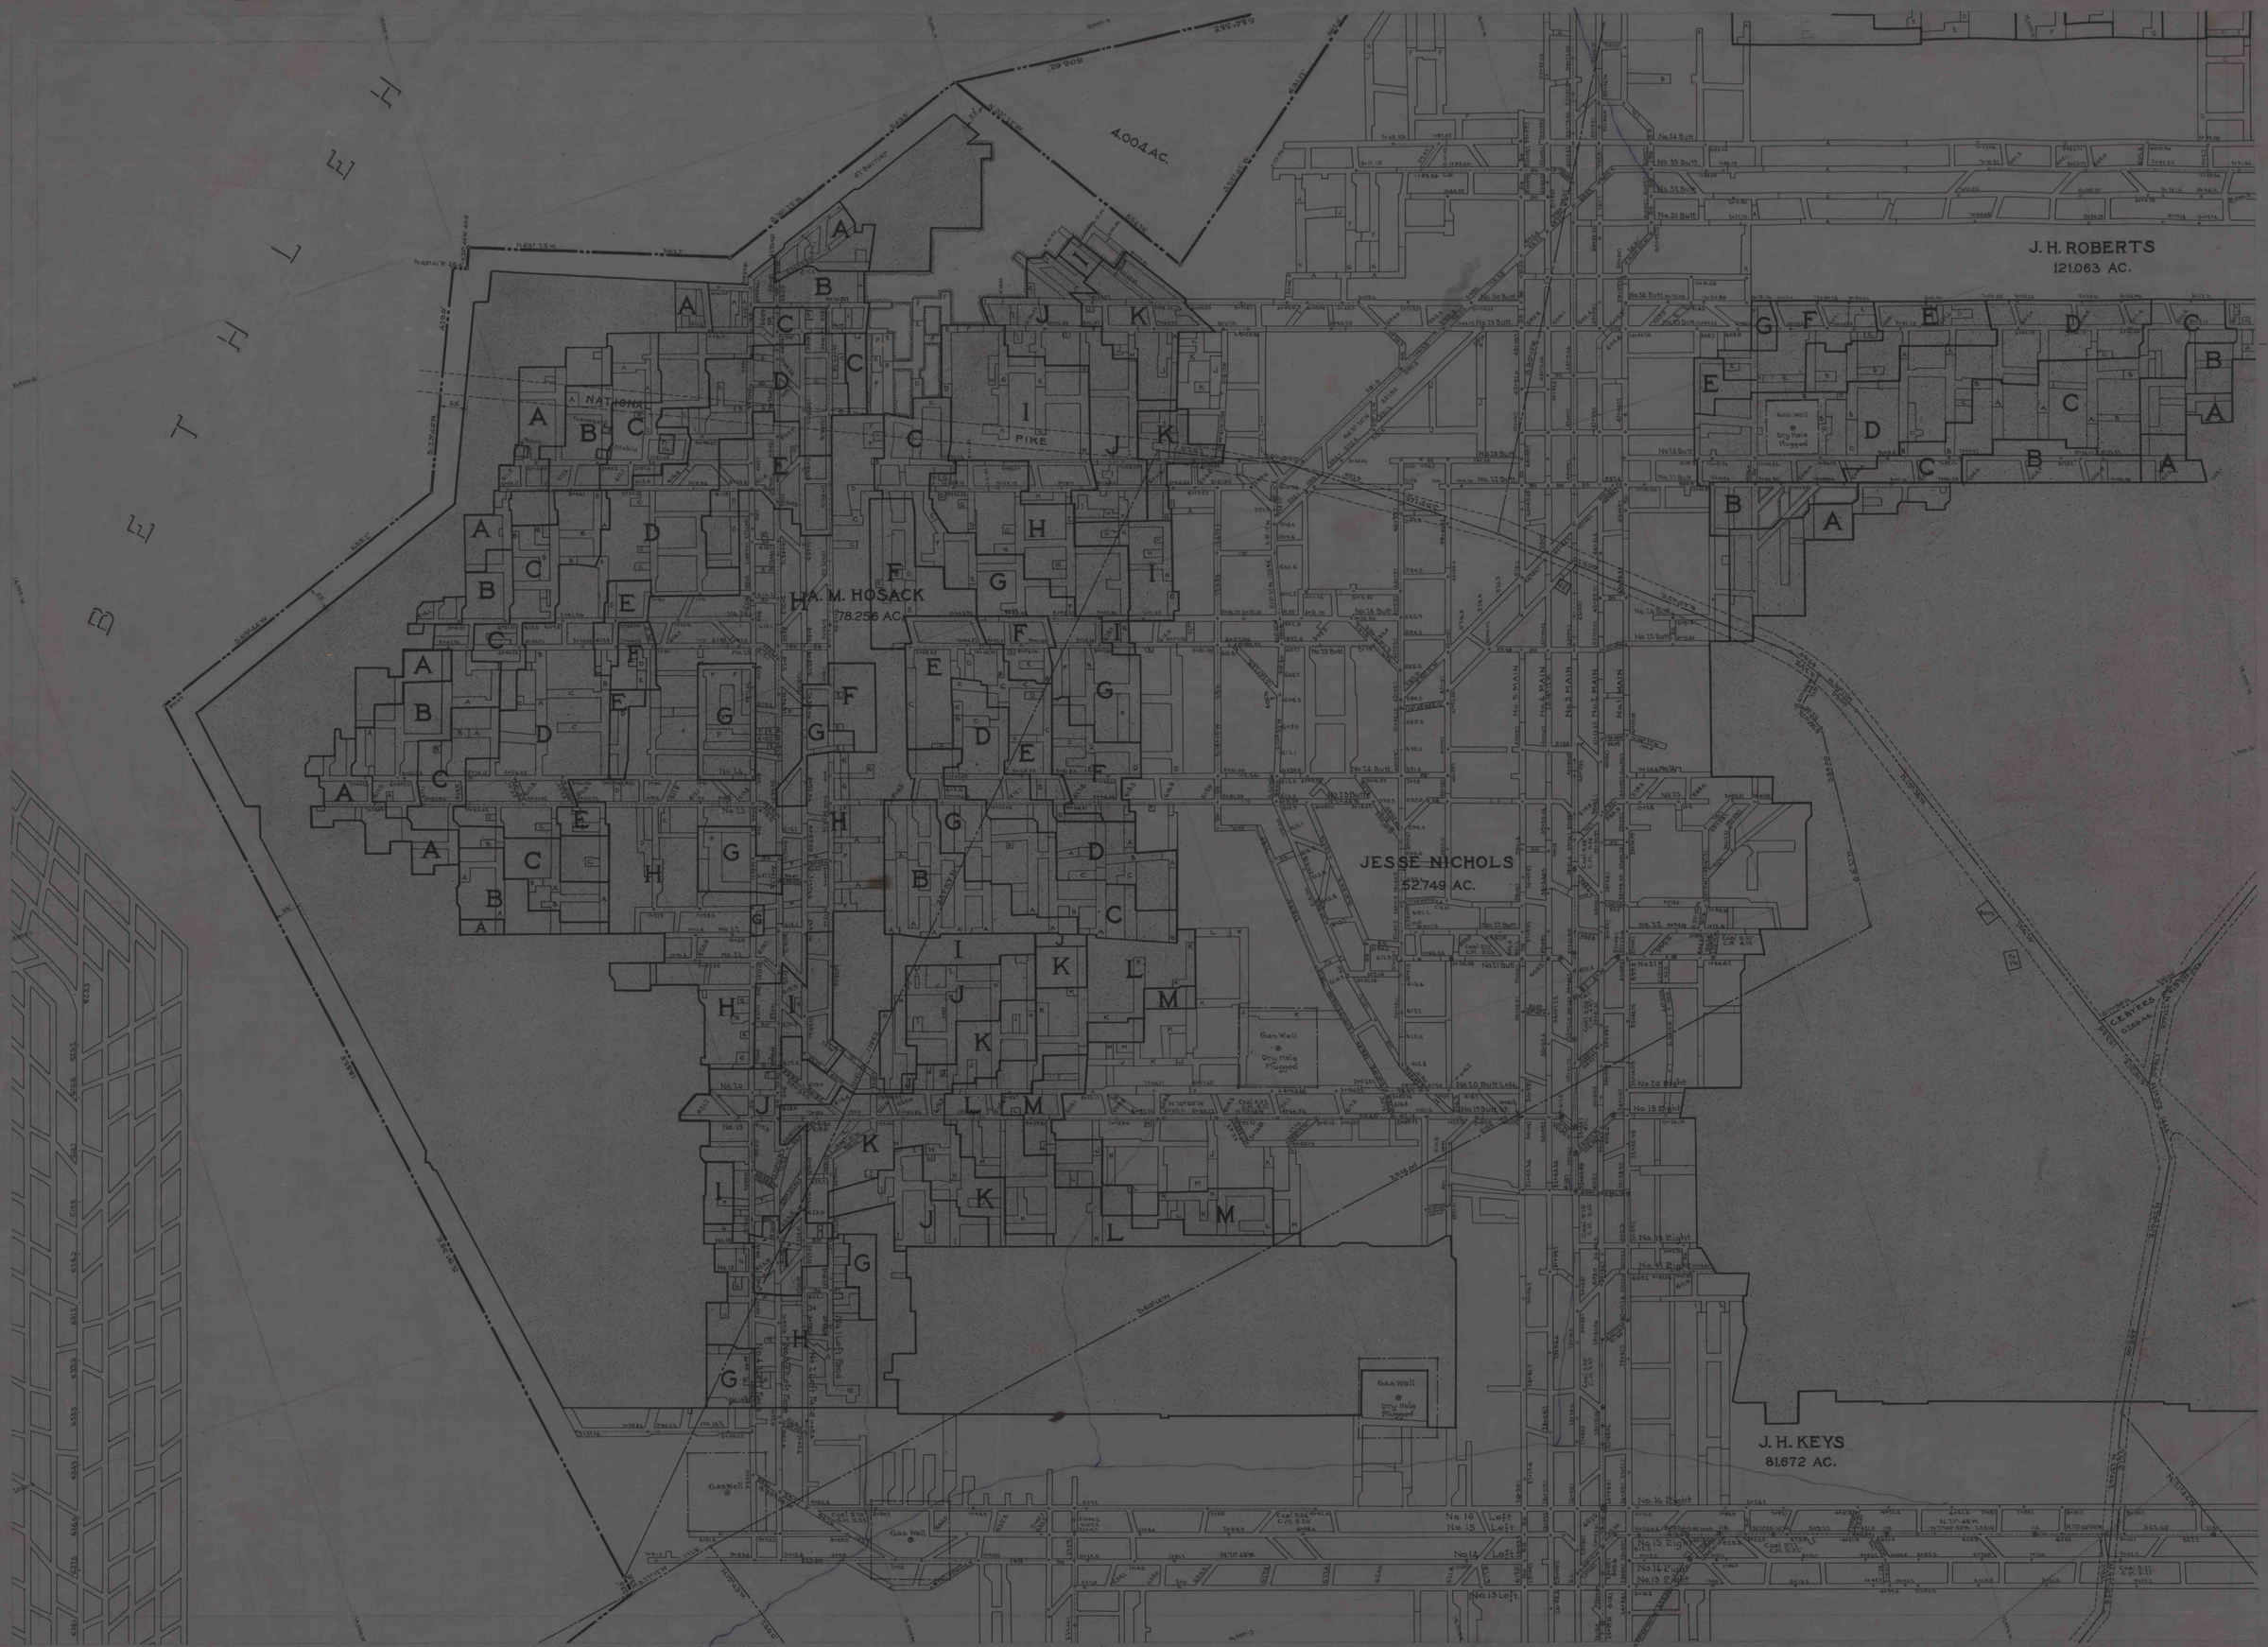

ONTARIO MINE
SCALE 1"=100'
SHEET No. 5.