FIT TO SHEET No. 9.

ONTARIO MINE
SCALE 1" = 100'

SHEET No. 6.

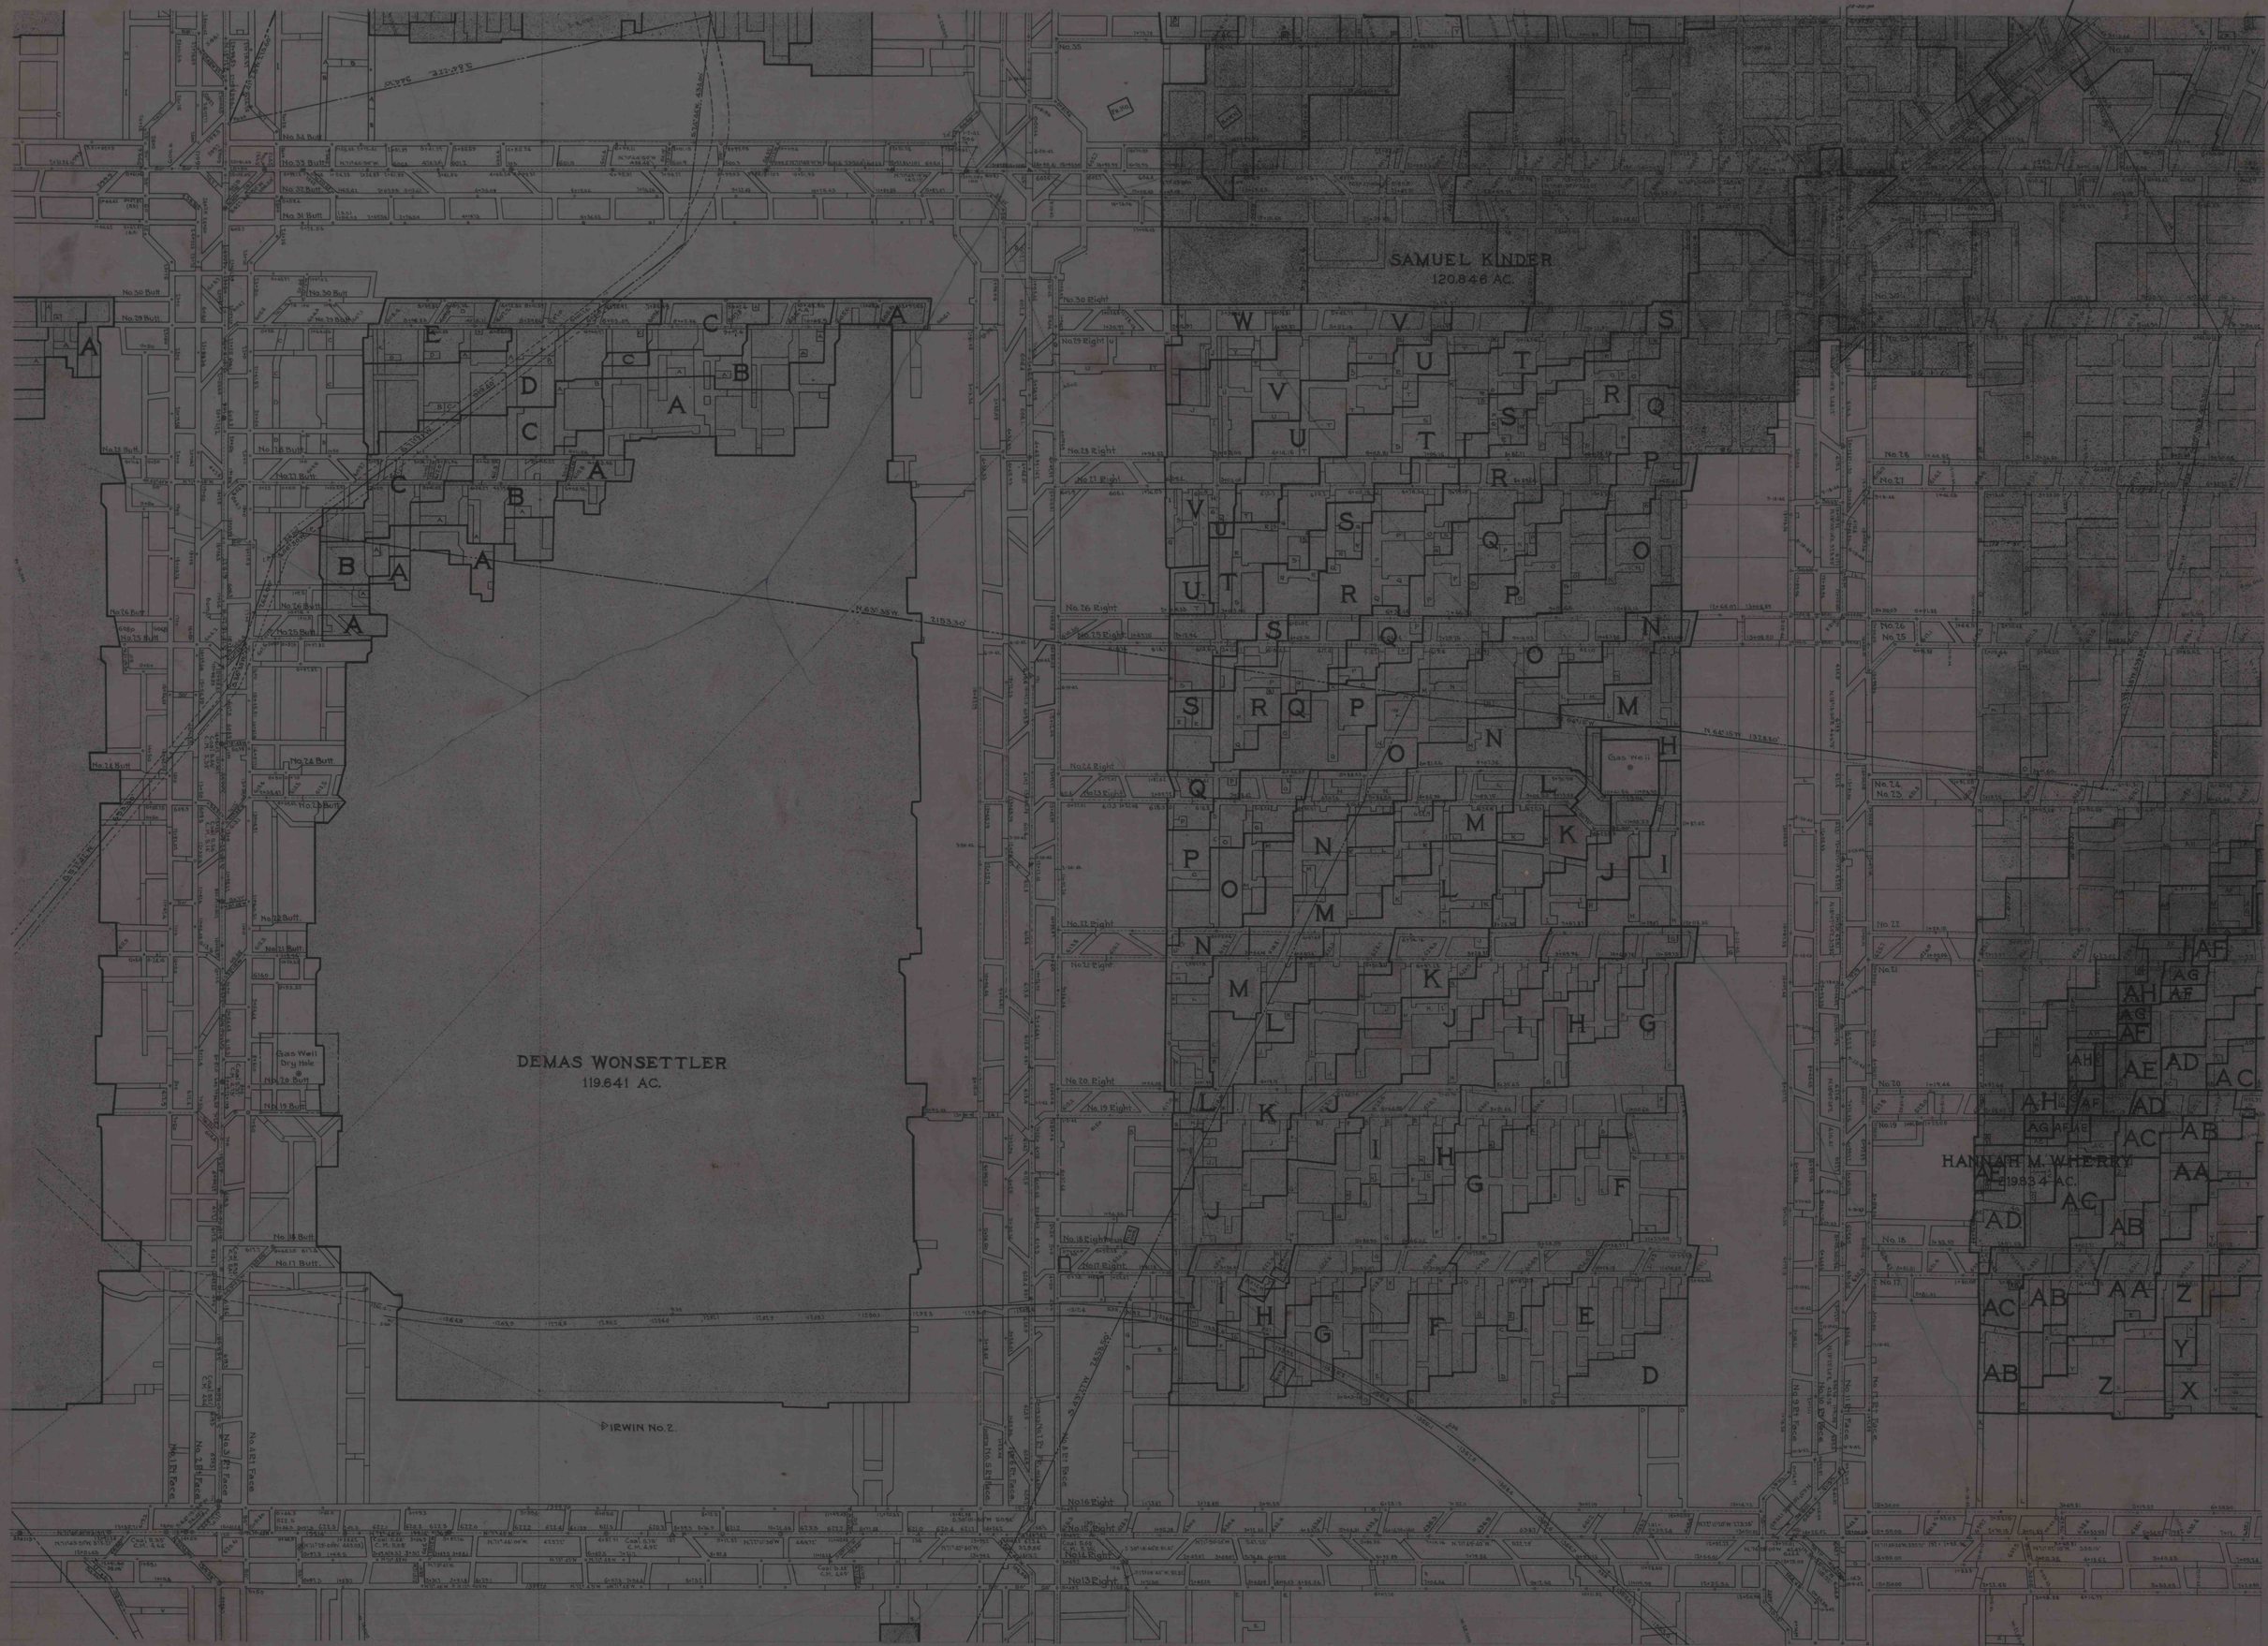
SAMUEL KINDER
120.846 AC.
DEMAS WONSETTLER
119.641 AC.
HANNAH M. WHERRY
119.834 AC.
P. IRWIN No. 2.
Gas Well
Dry Hole
Gas well
N.63°35'W
2153.30'
N.64°15'W 1323.30'
S.43°17'W 2655.50'
No. 34 Butt
No. 33 Butt
No. 32 Butt
No. 31 Butt
No. 30 Butt
No. 29 Butt
No. 28 Butt
No. 26 Butt
No. 25 Butt
No. 24 Butt
No. 22 Butt
No. 11 Butt
No. 20 Butt
No. 19 Butt
No. 18 Butt
No. 11 Butt
No. 30 Right
No. 29 Right
No. 28 Right
No. 11 Right
No. 26 Right
No. 25 Right
No. 24 Right
No. 13 Right
No. 12 Right
No. 11 Right
No. 20 Right
No. 19 Right
No. 18 Right
No. 17 Right
No. 16 Right
No. 15 Right
No. 14 Right
No. 13 Right
No. 1 R Face
No. 2 R Face
No. 3 R Face
No. 4 R Face
No. 5 R Face
No. 6 R Face
No. 7 R Face
No. 8 R Face
No. 9 R Face
No. 10 R Face
No. 11 R Face
No. 12 R Face
No. 13 R Face
No. 14 R Face
No. 15 R Face
No. 16 R Face
No. 17 R Face
No. 18 R Face
No. 19 R Face
No. 20 R Face
No. 21 R Face
No. 22 R Face
No. 23 R Face
No. 24 R Face
No. 25 R Face
No. 26 R Face
No. 28 R Face
No. 29 R Face
No. 30 R Face
No. 35
No. 21
No. 22
No. 23
No. 24
No. 25
No. 26
No. 28
No. 29
No. 30
No. 20
No. 19
No. 18
No. 17
No. 16
No. 15
No. 14
No. 13
No. 12
No. 11
No. 10
No. 9
No. 8
No. 7
No. 6
No. 5
No. 4
No. 3
No. 2
No. 1
Coal 5.00
C.N. 4.65
Coal 5.30
C.N. 4.85
Coal 5.00
C.N. 4.65
Coal 5.00
C.N. 4.65
Coal 5.00
C.N. 4.65