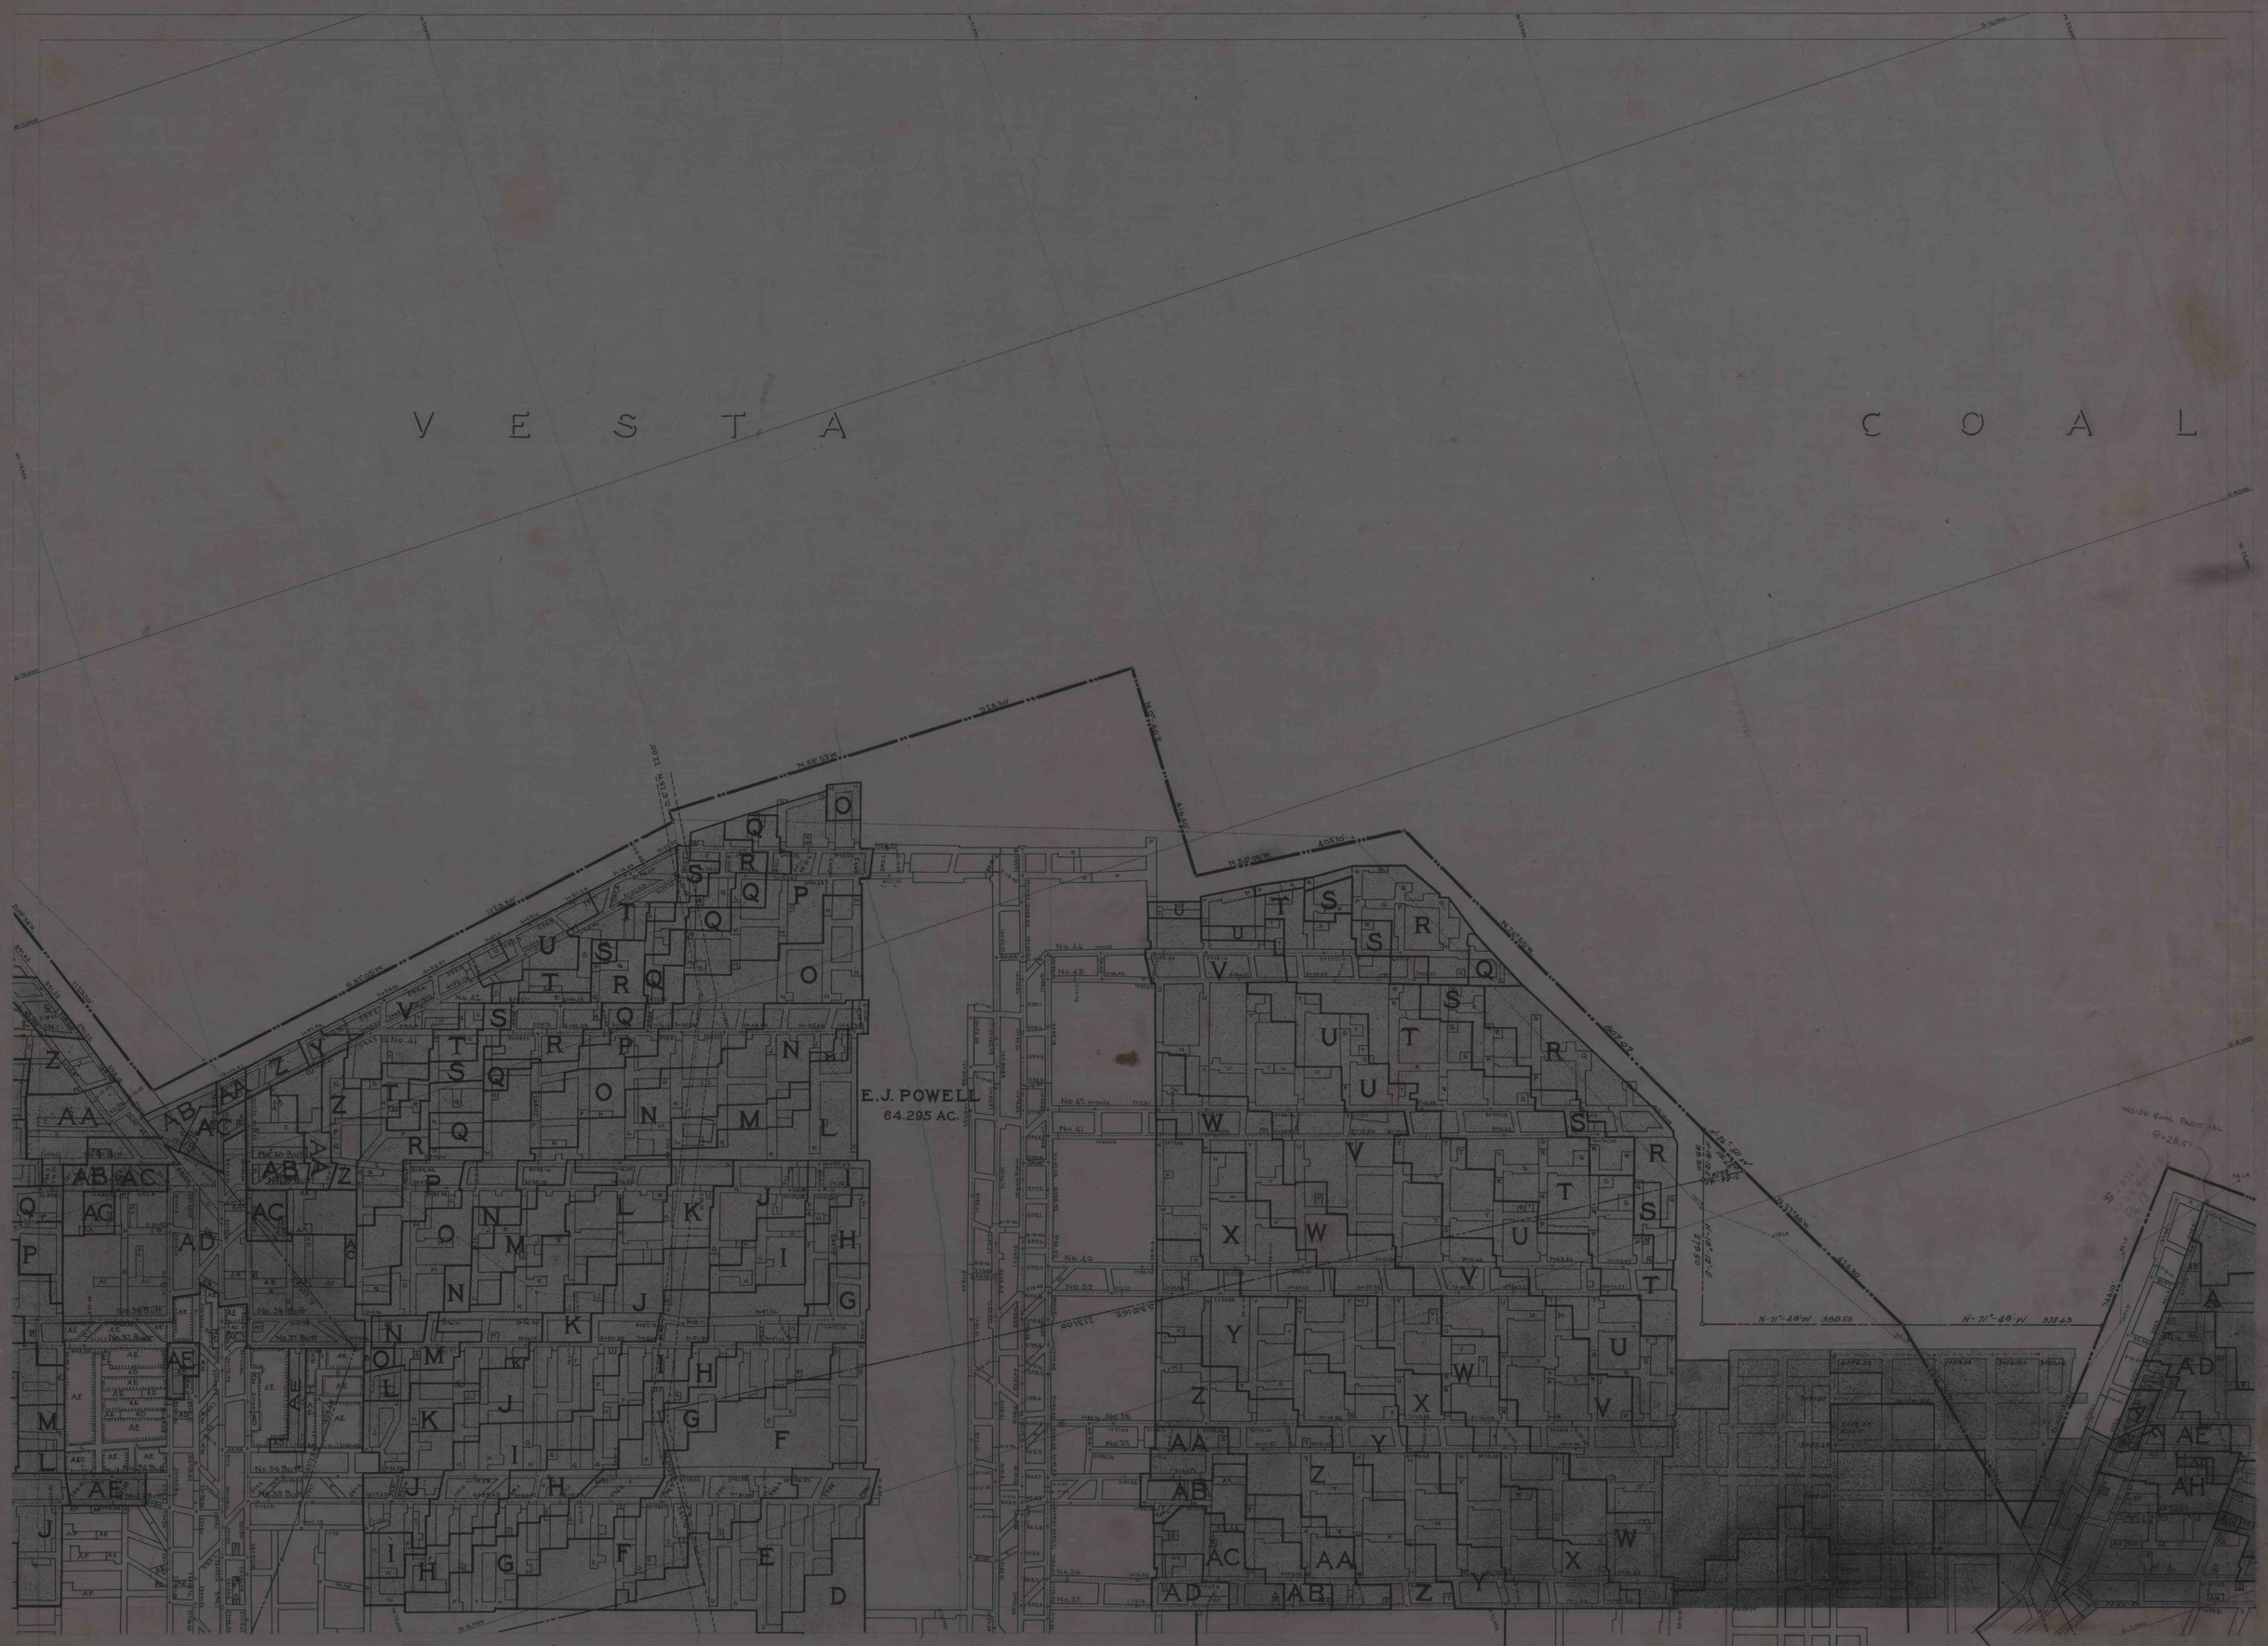
VESTA COAL
E.J. POWELL
64.295 AC.
FIT TO SHEET No. 8.
FIT TO SHEET No. 10.
FIT TO SHEET No. 6.
ONTARIO MINE
SCALE 1"=100'
SHEET No. 9.