


C O M P A N Y

FIT TO SHEET No. 9

W. K. WONSETTLER
50.196 AC.

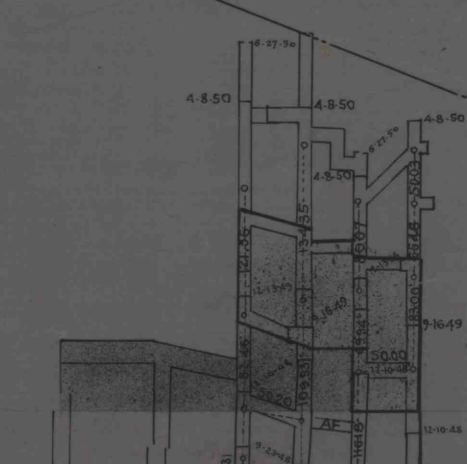

FIT TO SHEET No. 7