


FIT TO SHEET No. 2.

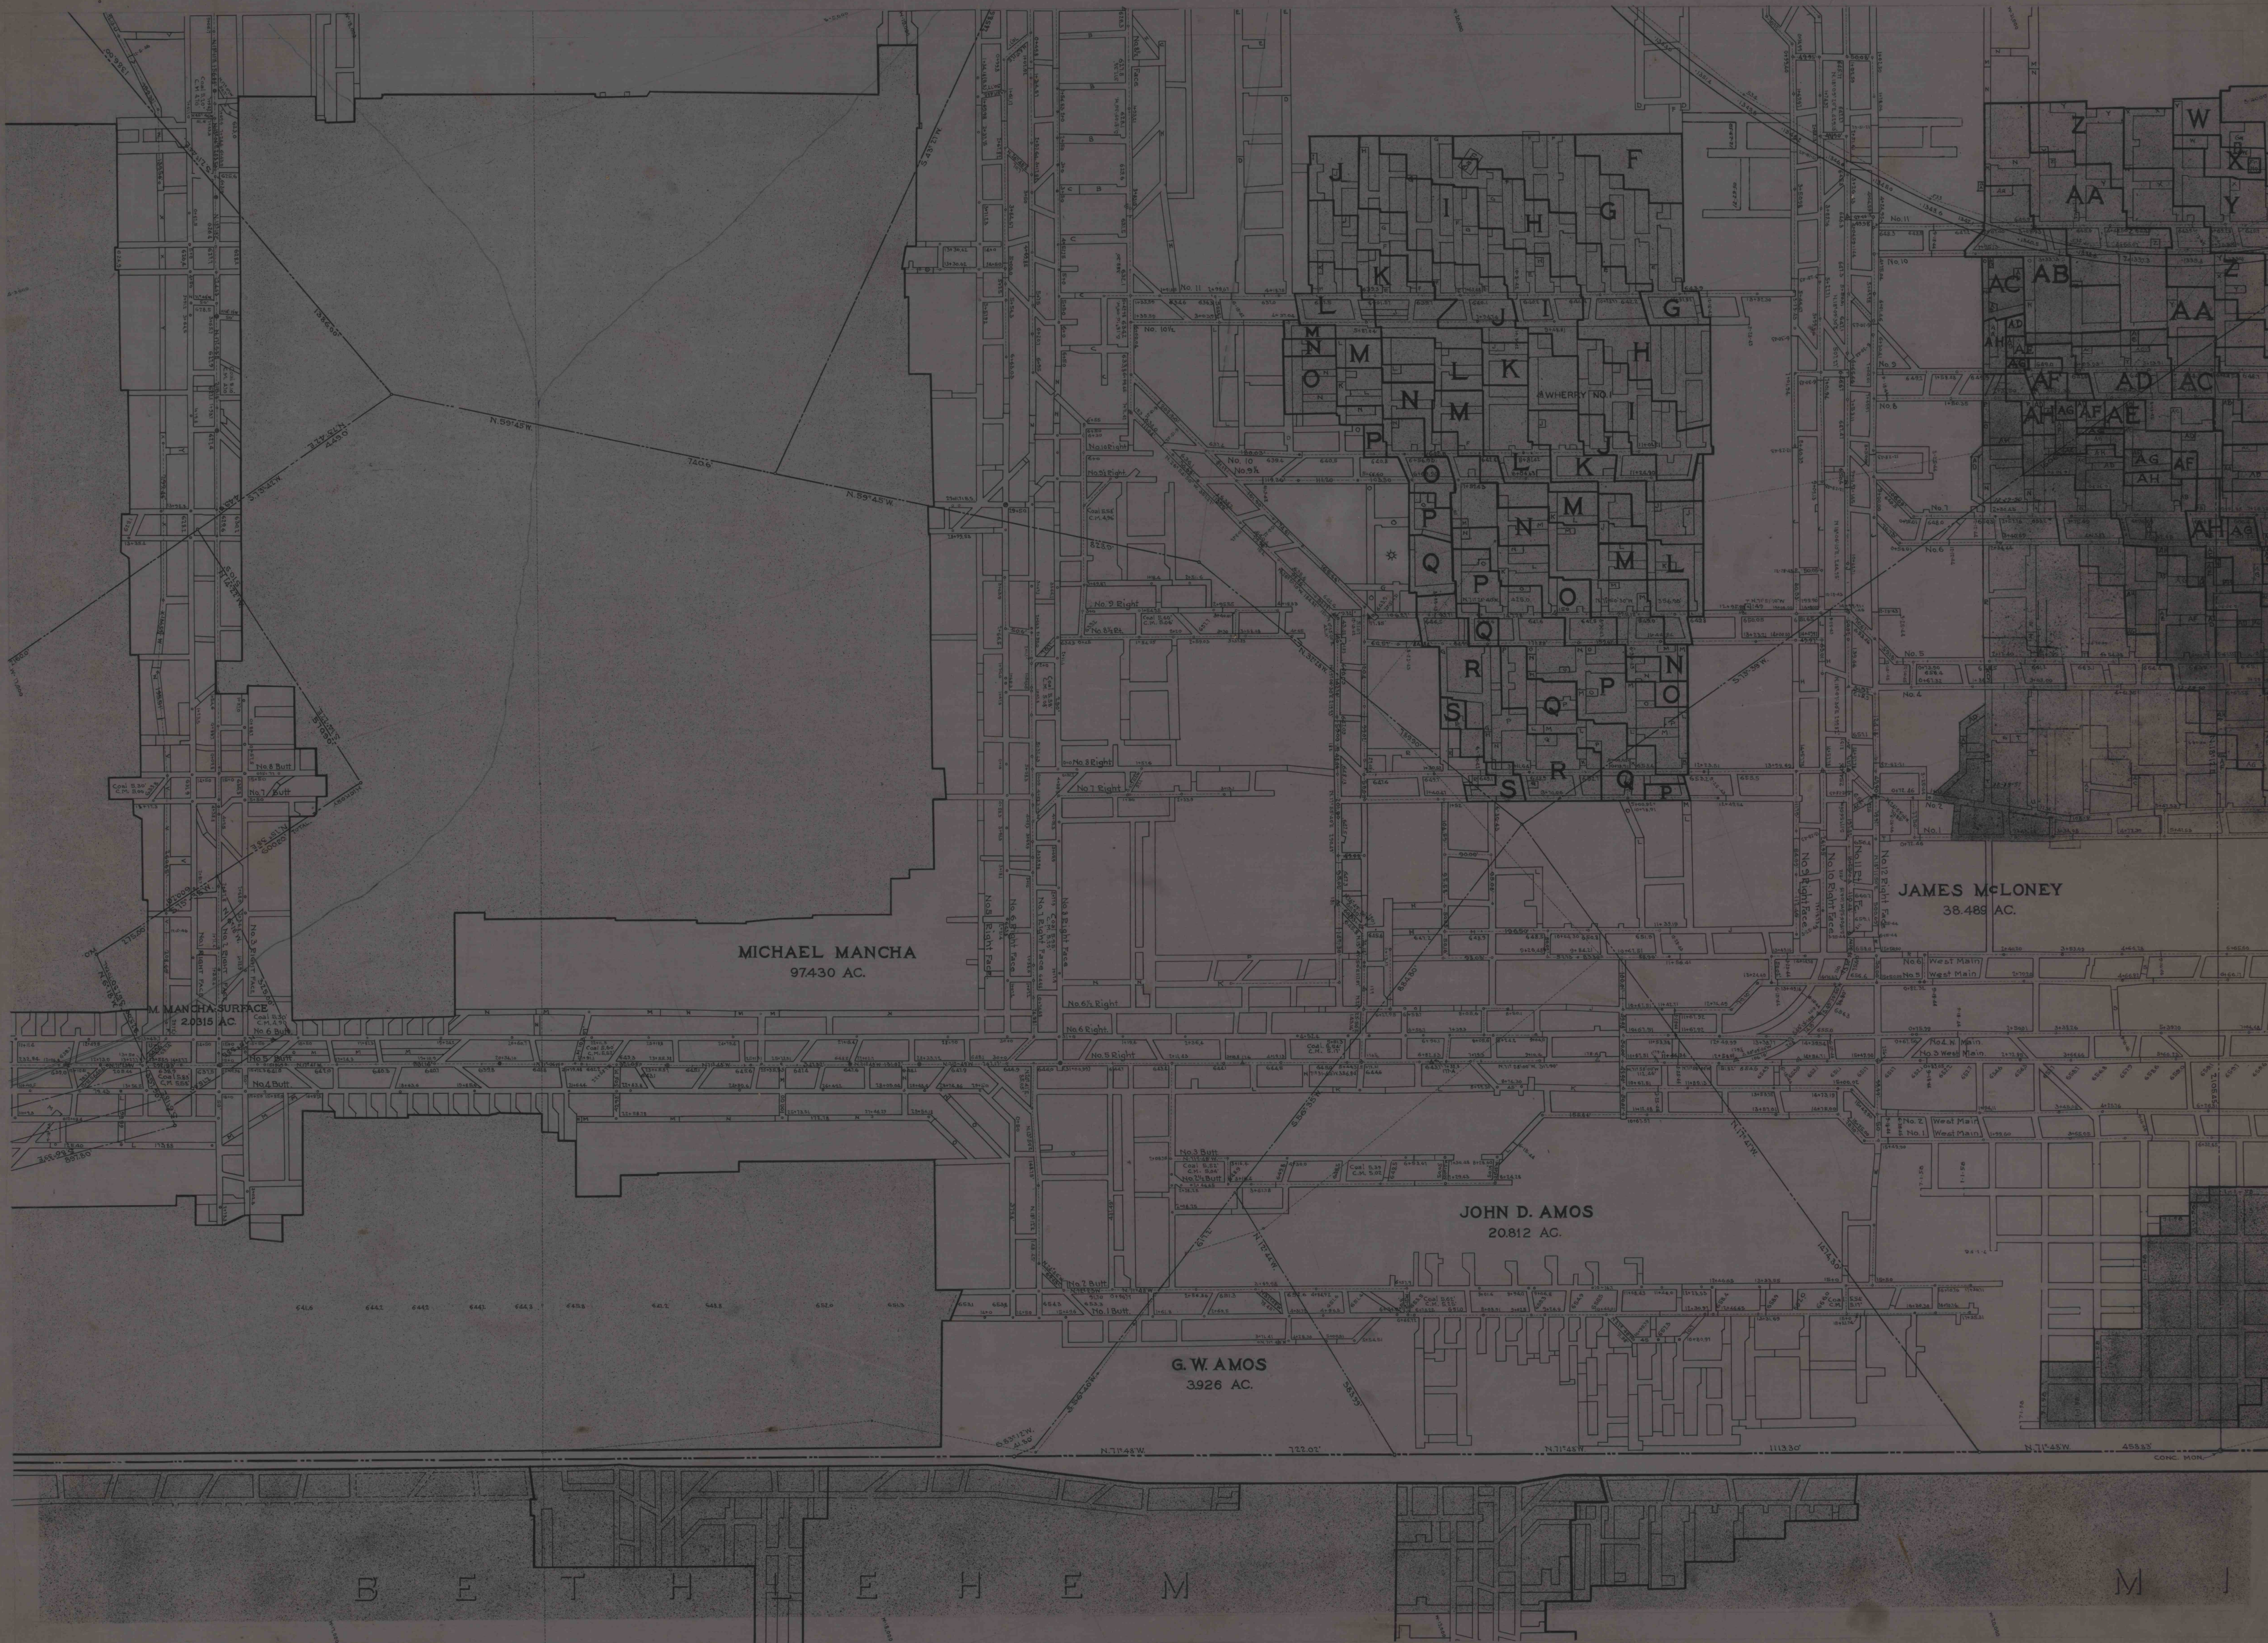

FIT TO SHEET No. 4.