Plan of

Ontario Mine

Ontario Gas Coal Co.

NORTH BETHLEHEM TWP.

WASH. CO. PA.

SCALE 1" = 400'

JAN. 1, 1927

ENGINEERS OFFICE

Jan. 1, 1934	Sept. 25, 1943	SEPT. 25, 1947
Dec. 4, 1934	Dec. 28, 1943	SEPT. 13, 1948
Dec. 24, 1934	Mar. 23, 1944	DEC. 10, 1948
Dec. 29, 1934	June 15, 1944	MAR. 22, 1949
Dec. 22, 1938	Sept. 18, 1944	JUNE 23, 1949
Dec. 22, 1939	Dec. 12, 1944	SEPT. 16, 1949
Dec. 22, 1940	Mar. 13, 1945	DEC. 13, 1949
Nov. 1, 1941	June 20, 1945	APRIL 2, 1950
Jan. 1, 1942	Dec. 14, 1945	
Mar. 20, 1942	Mar. 13, 1946	
June 10, 1942	June 28, 1946	
Oct. 3, 1942	Sept. 11, 1946	
Dec. 30, 1942	Sep. 6, 1946	
Mar. 23, 1943	Mar. 15, 1947	
June 30, 1943	June 16, 1947	
	June 26, 1948	

Brown - Denotes Coal Mined
Dotted Boundary Line - Denotes Coal Area
Green " " " Surface

Property List		
1	Jacob Myers	128.50
2	Wm. C. Wise	14.697
3	Samuel Kinder	120.846
4	T.M. Ross	114.799
5	E.J. Powell	64.895
6	J.H. Roberts	121.063
7	John D. Amos	20.812
8	Hannah M. Wherry	219.834
9	Demas Wonsettler	119.644
10	Michael Mancha	97.430
11	Jas. H. Keys	81.672
12	Jesse Nichols	52.749
13	A.W. Mosack	78.256
14	Jas. Mc Loney	38.489
15	Thos. H. Dague	38.068
16	Geo. W. Amos	3.926
17	Chas. E. Byers	0.269
	Total	1205.195
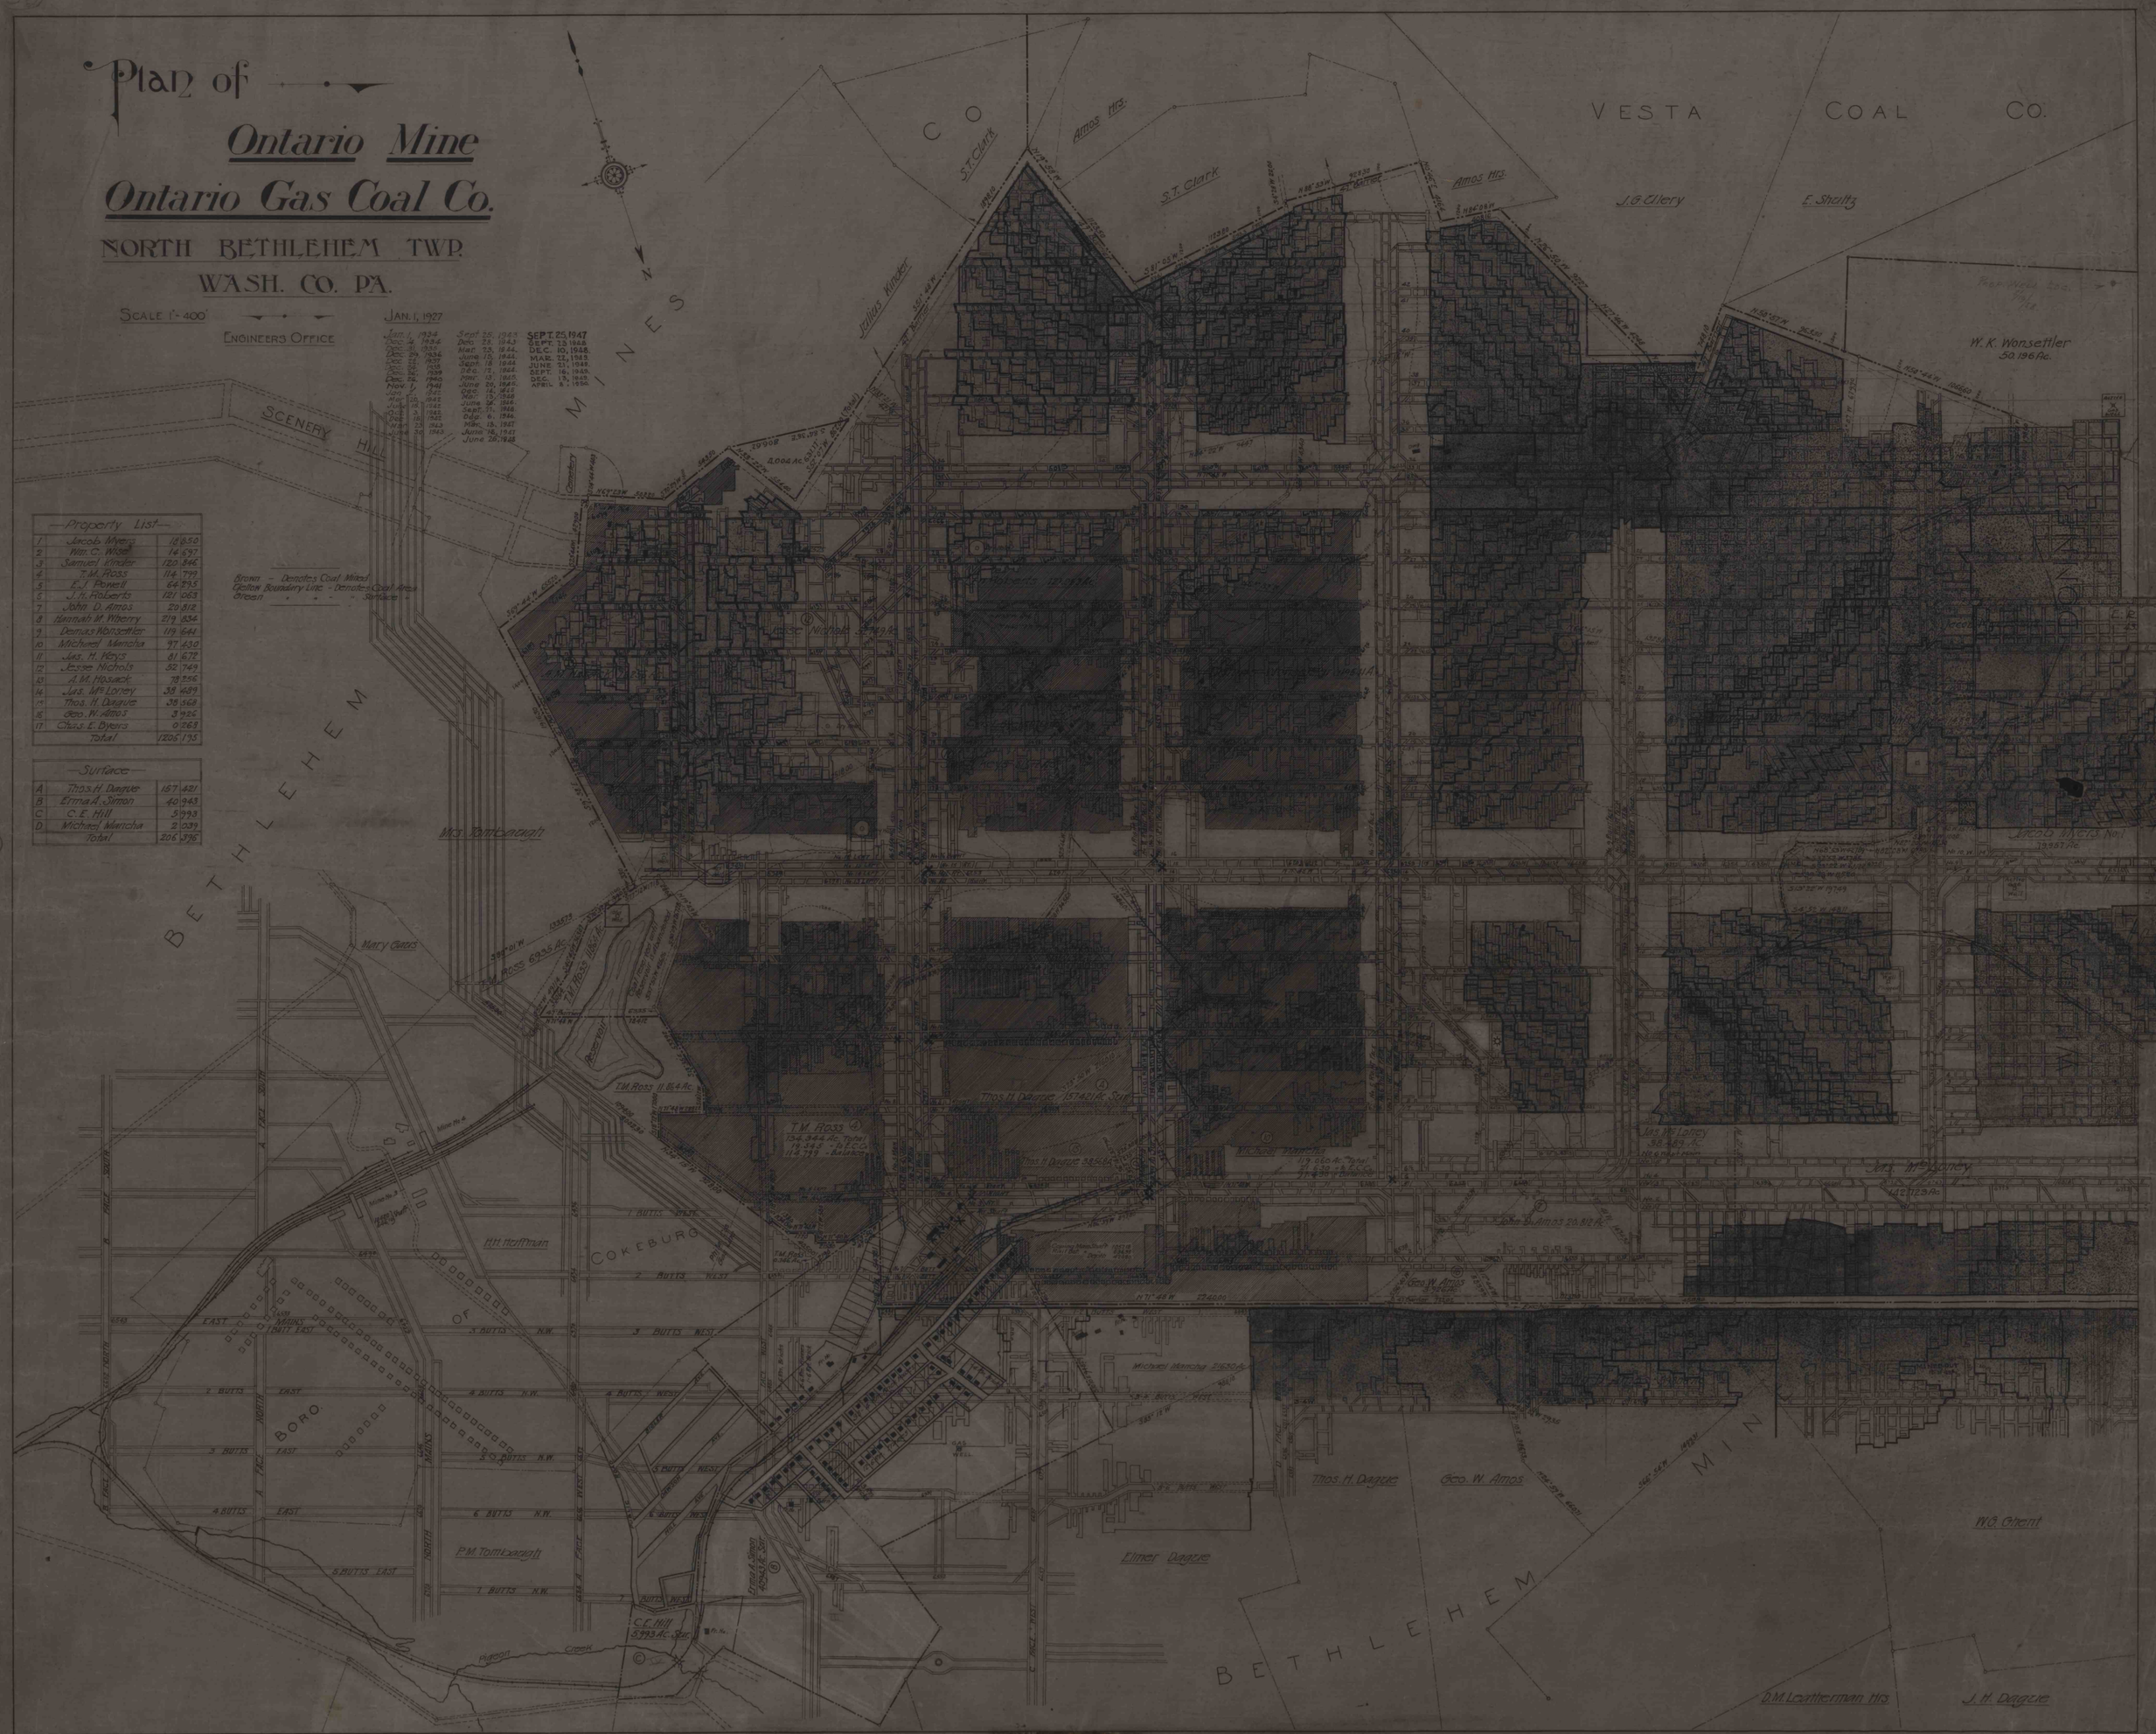
Surface		
A	Thos. H. Dague	157.421
B	Emma A. Simon	40.943
C	C.E. Hill	5.993
D	Michael Mancha	2.039
	Total	206.396