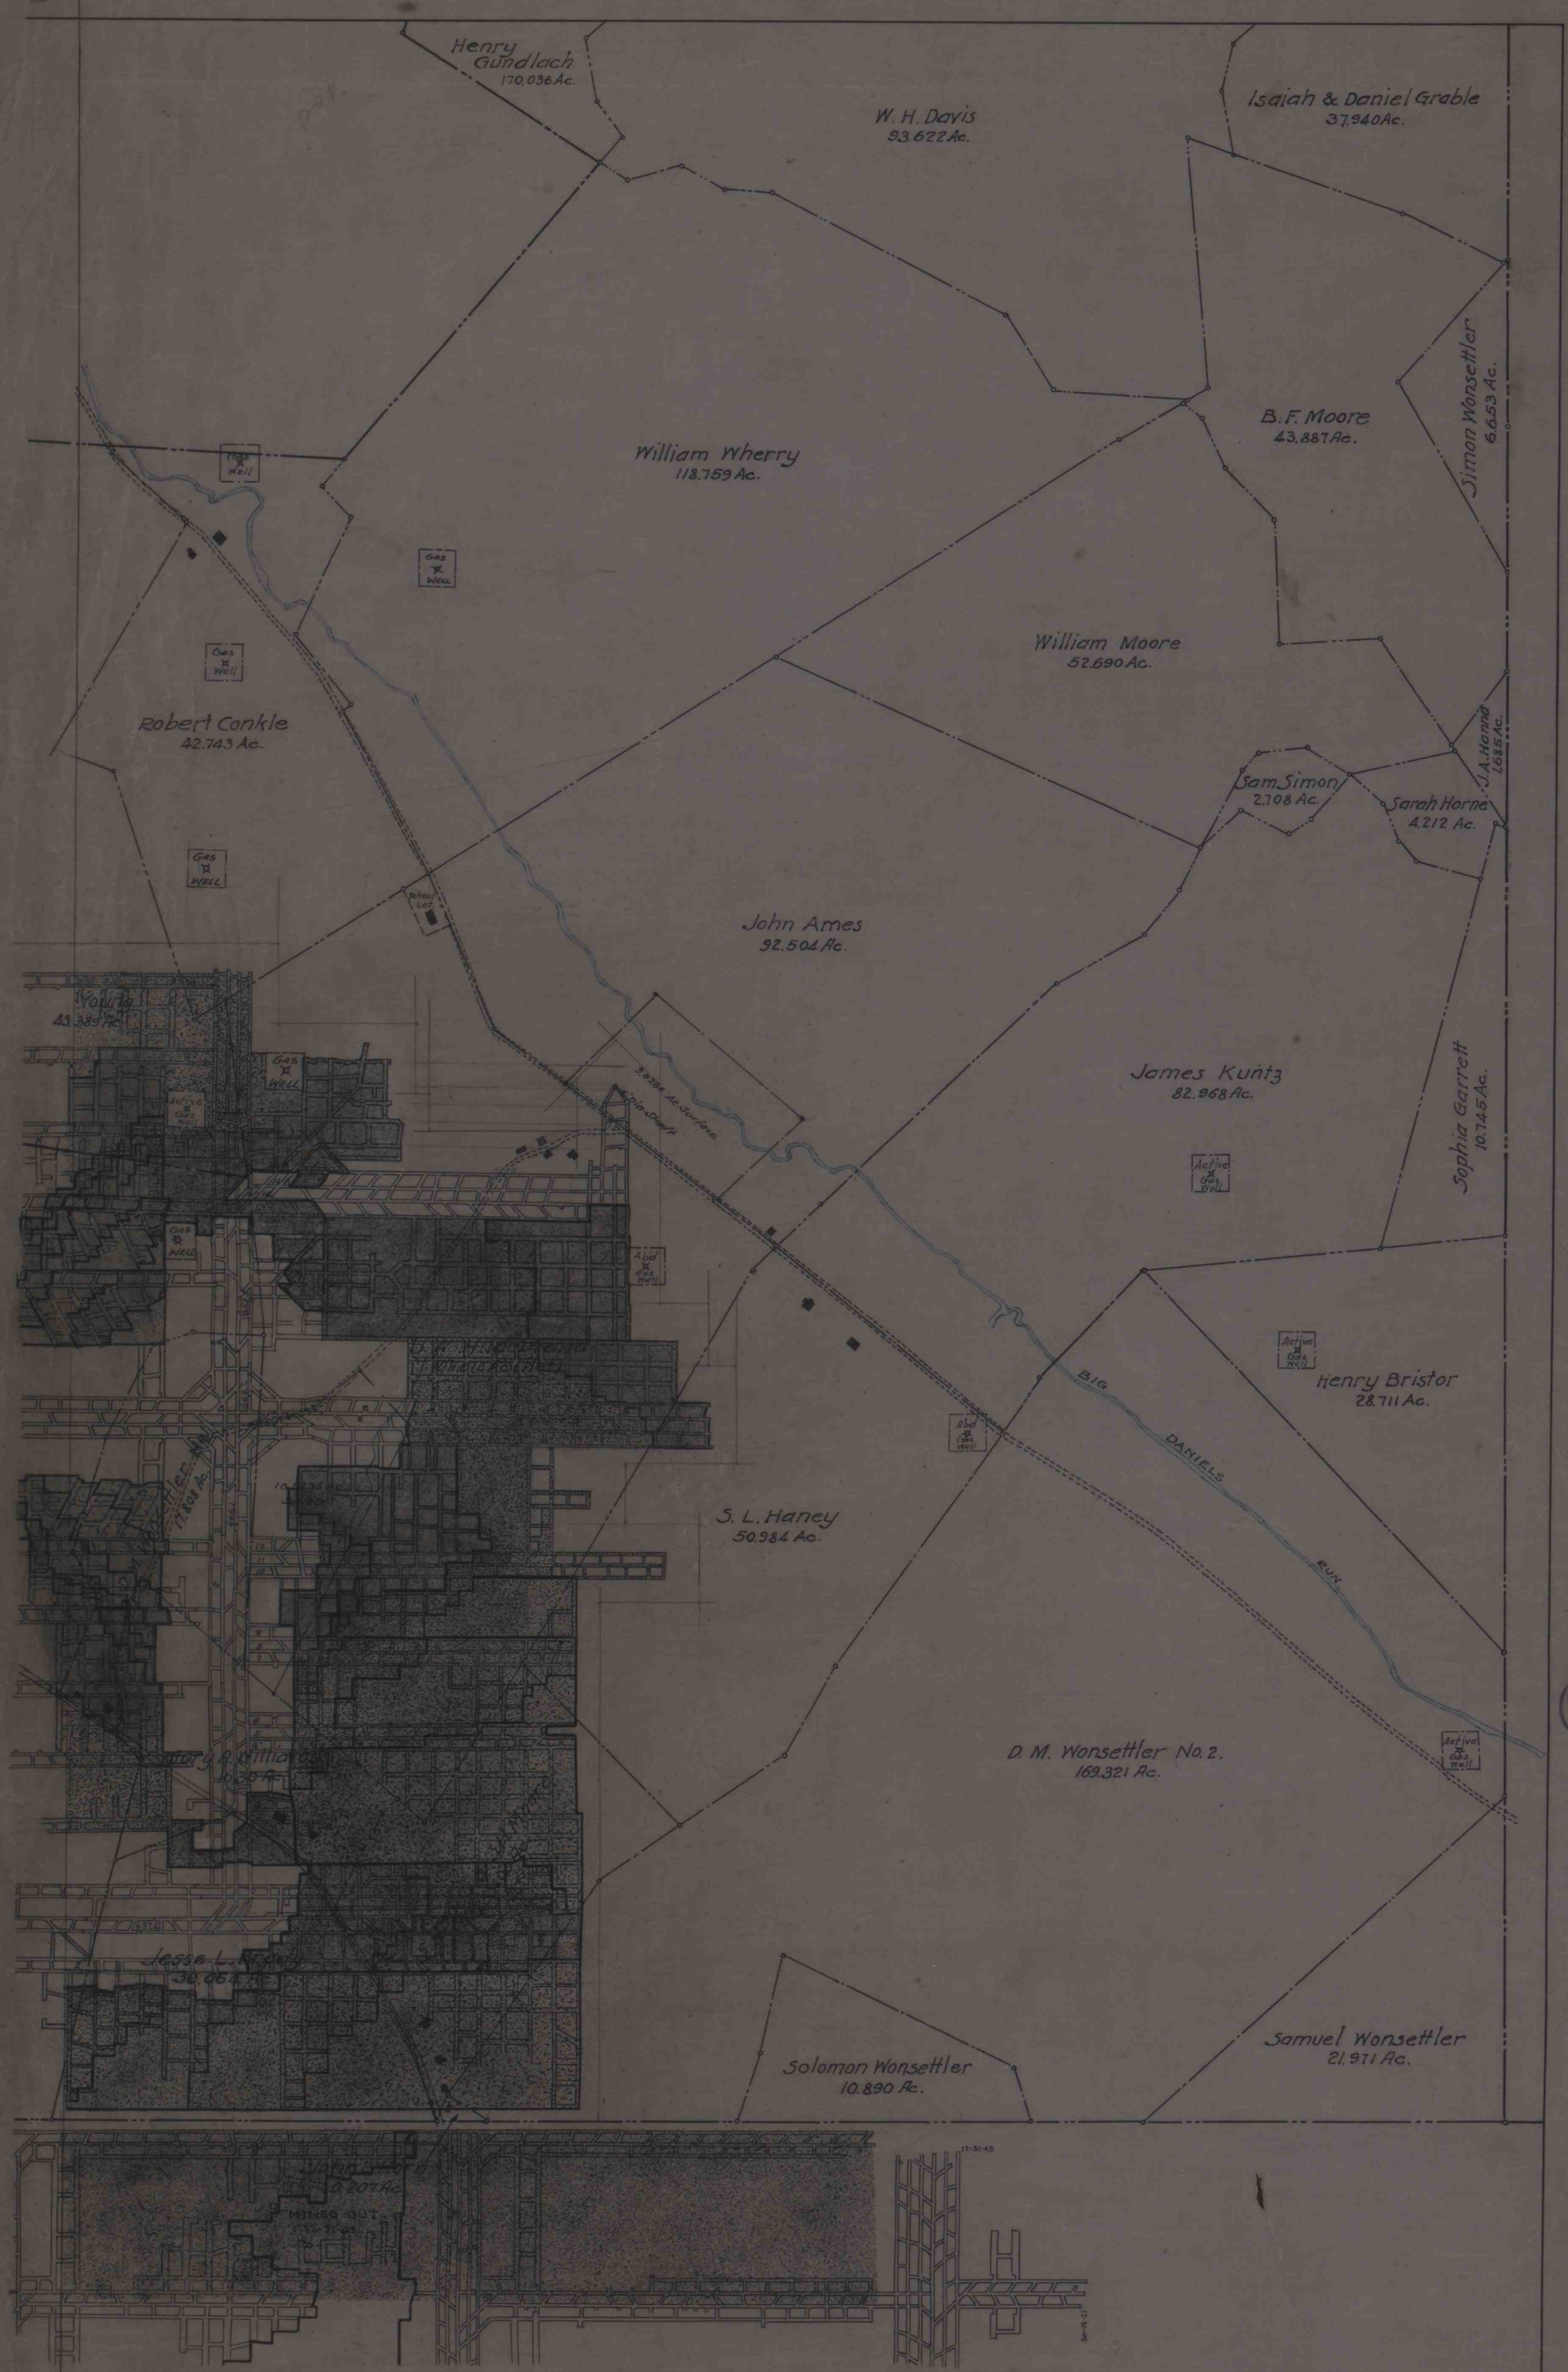
Henry Gundlach
170.036 Ac.
W. H. Davis
93.622 Ac.
Isaiah & Daniel Grable
37.940 Ac.
William Wherry
118.759 Ac.
B. F. Moore
43.887 Ac.
Simon Wonsettler
6.653 Ac.
William Moore
52.690 Ac.
Robert Conkle
42.743 Ac.
Sam Simon
2.708 Ac.
Sarah Horne
4.212 Ac.
J. A. Hand
1.685 Ac.
John Ames
92.504 Ac.
James Kuntz
82.968 Ac.
Sophia Garrett
10.745 Ac.
Henry Bristor
28.711 Ac.
S. L. Haney
50.984 Ac.
BIG DANIELS RUN
D. M. Wonsettler No. 2.
169.321 Ac.
Solomon Wonsettler
10.890 Ac.
Samuel Wonsettler
21.971 Ac.
Gas Well
Active Gas Well
Abd Gas Well
Refuse Col.
30.984 Ac. Surface
Mine Shaft
MINED OUT
12-31-49