


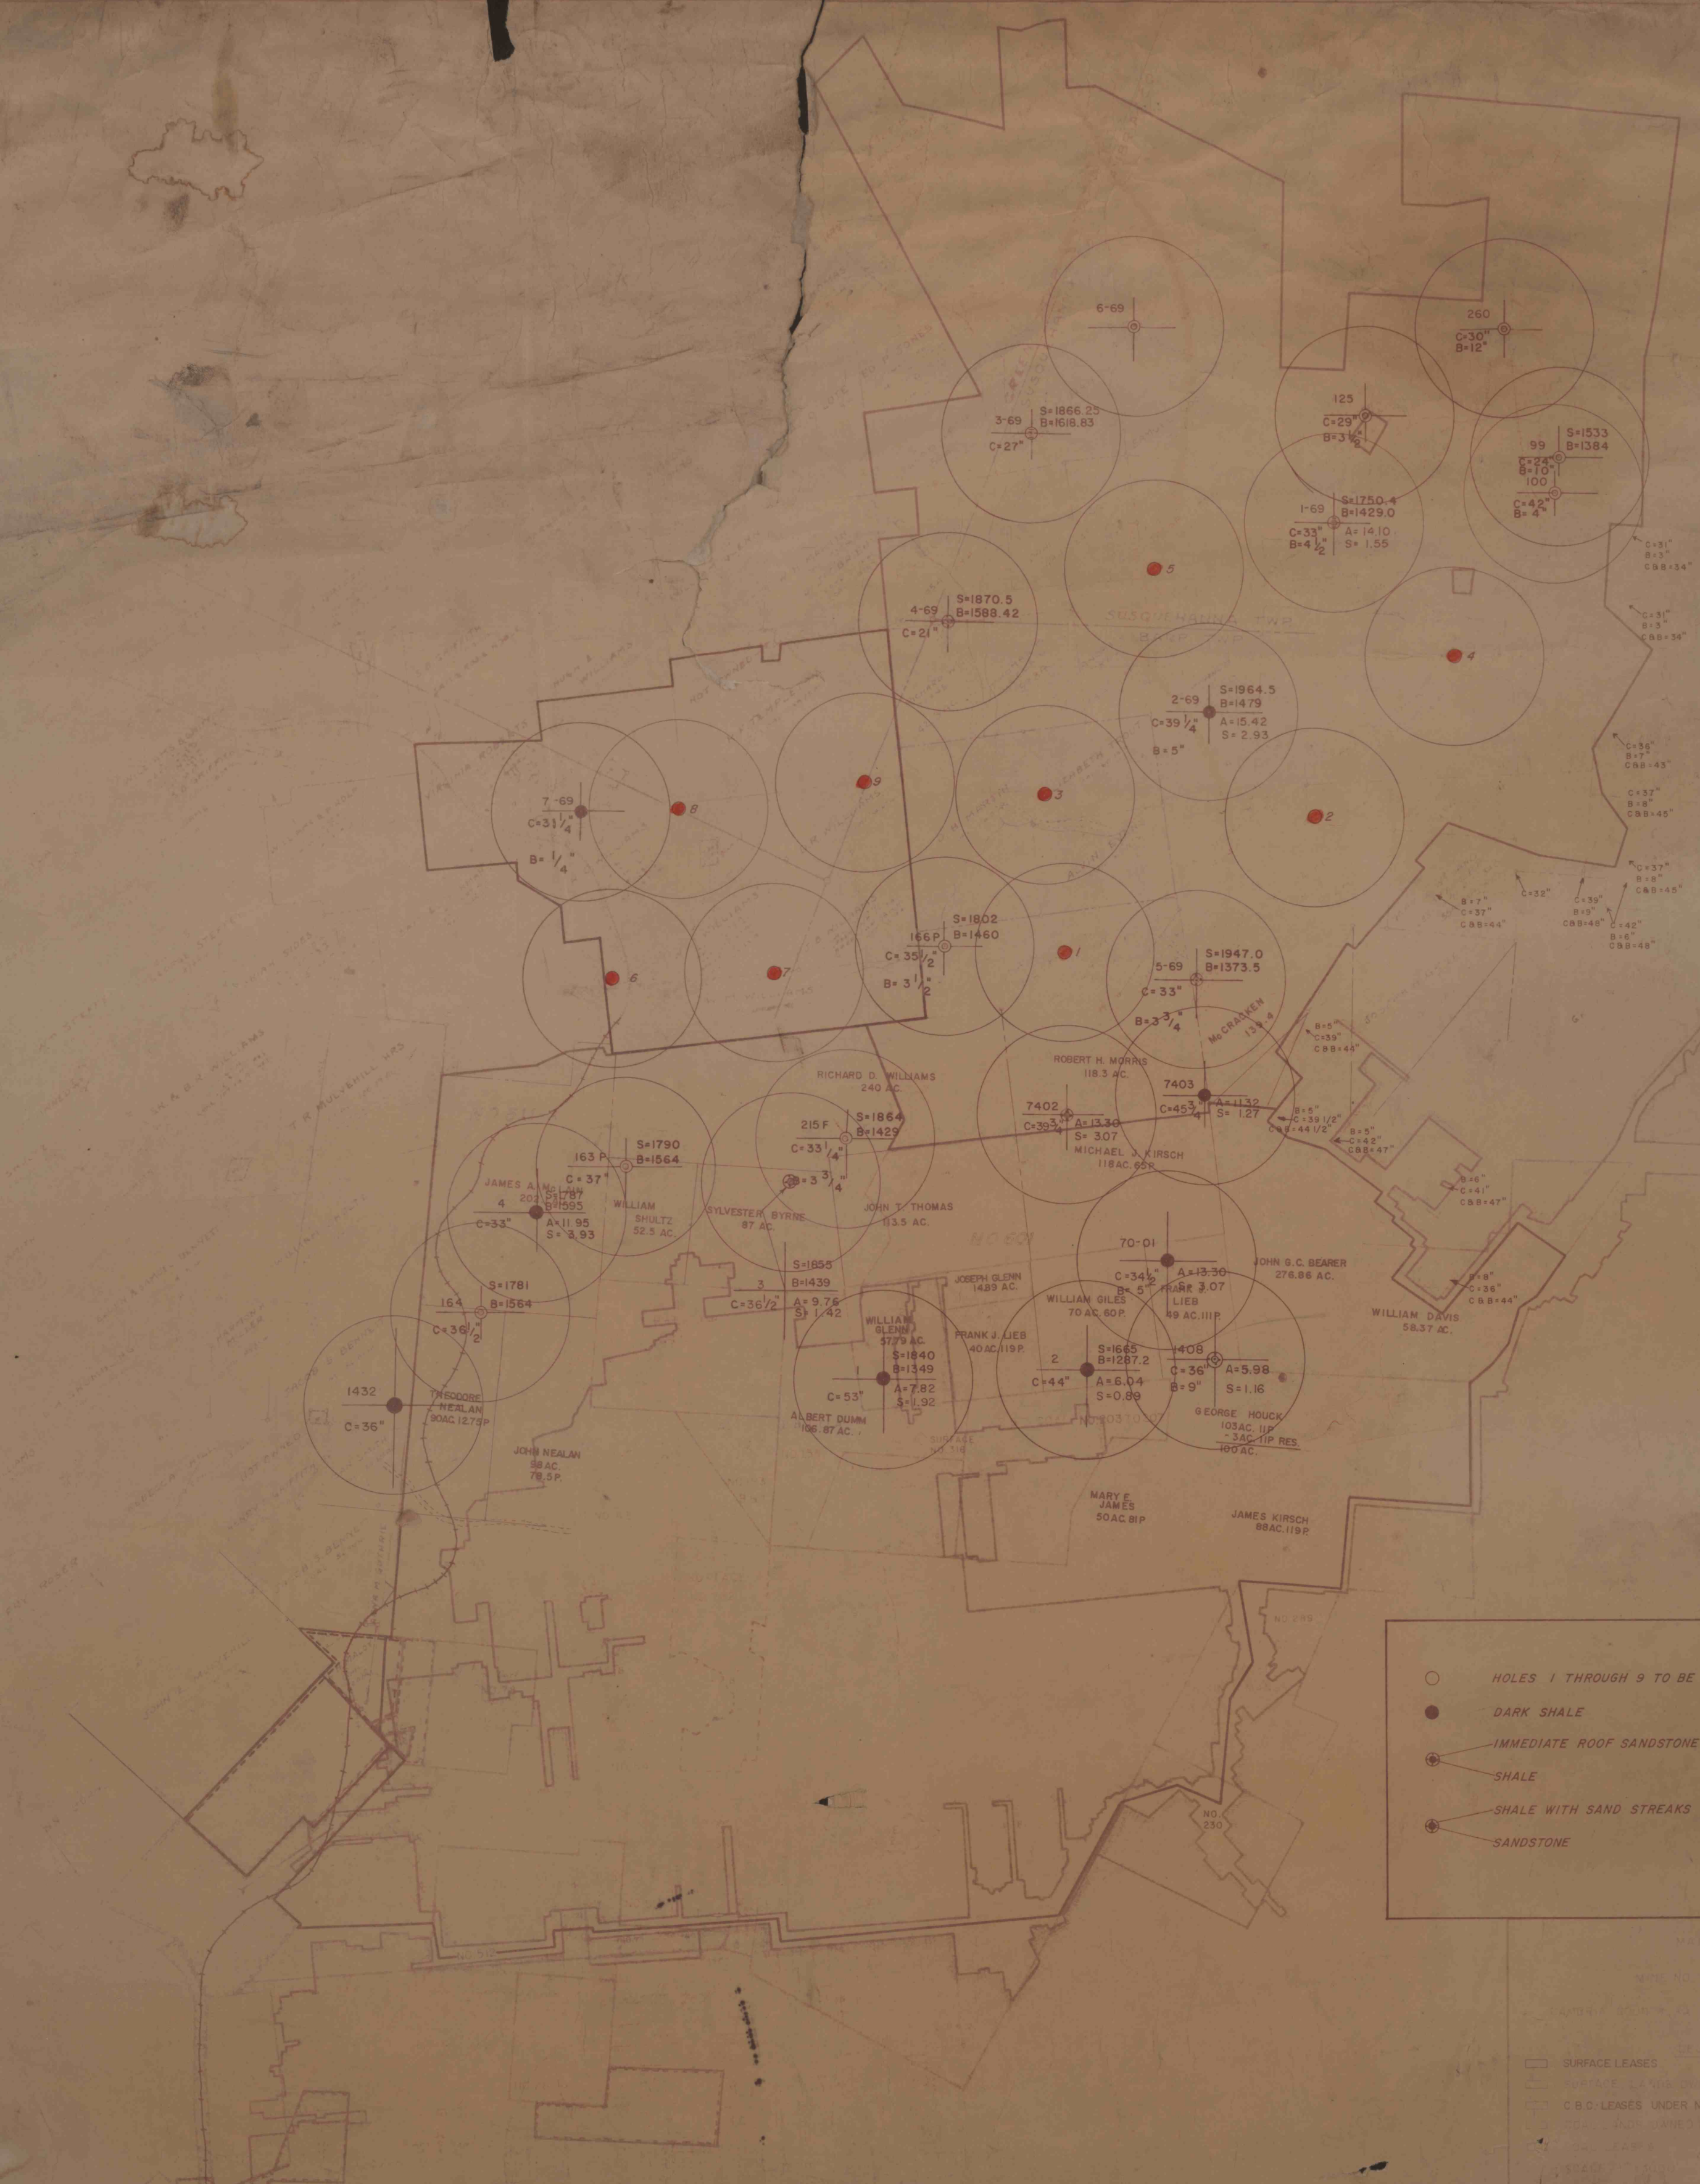

- HOLES 1 THROUGH 9 TO BE DRILLED
- DARK SHALE
- IMMEDIATE ROOF SANDSTONE
- SHALE
- SHALE WITH SAND STREAKS
- SANDSTONE

SURFACE LEASES
SURFACE LANDS OWNED BY
C.B.C. LEASES UNDER NEGOTIATION
TOWNSHIP LANDS OWNED IN PART
SCALE 1" = 1000'
EXHIBIT 1