


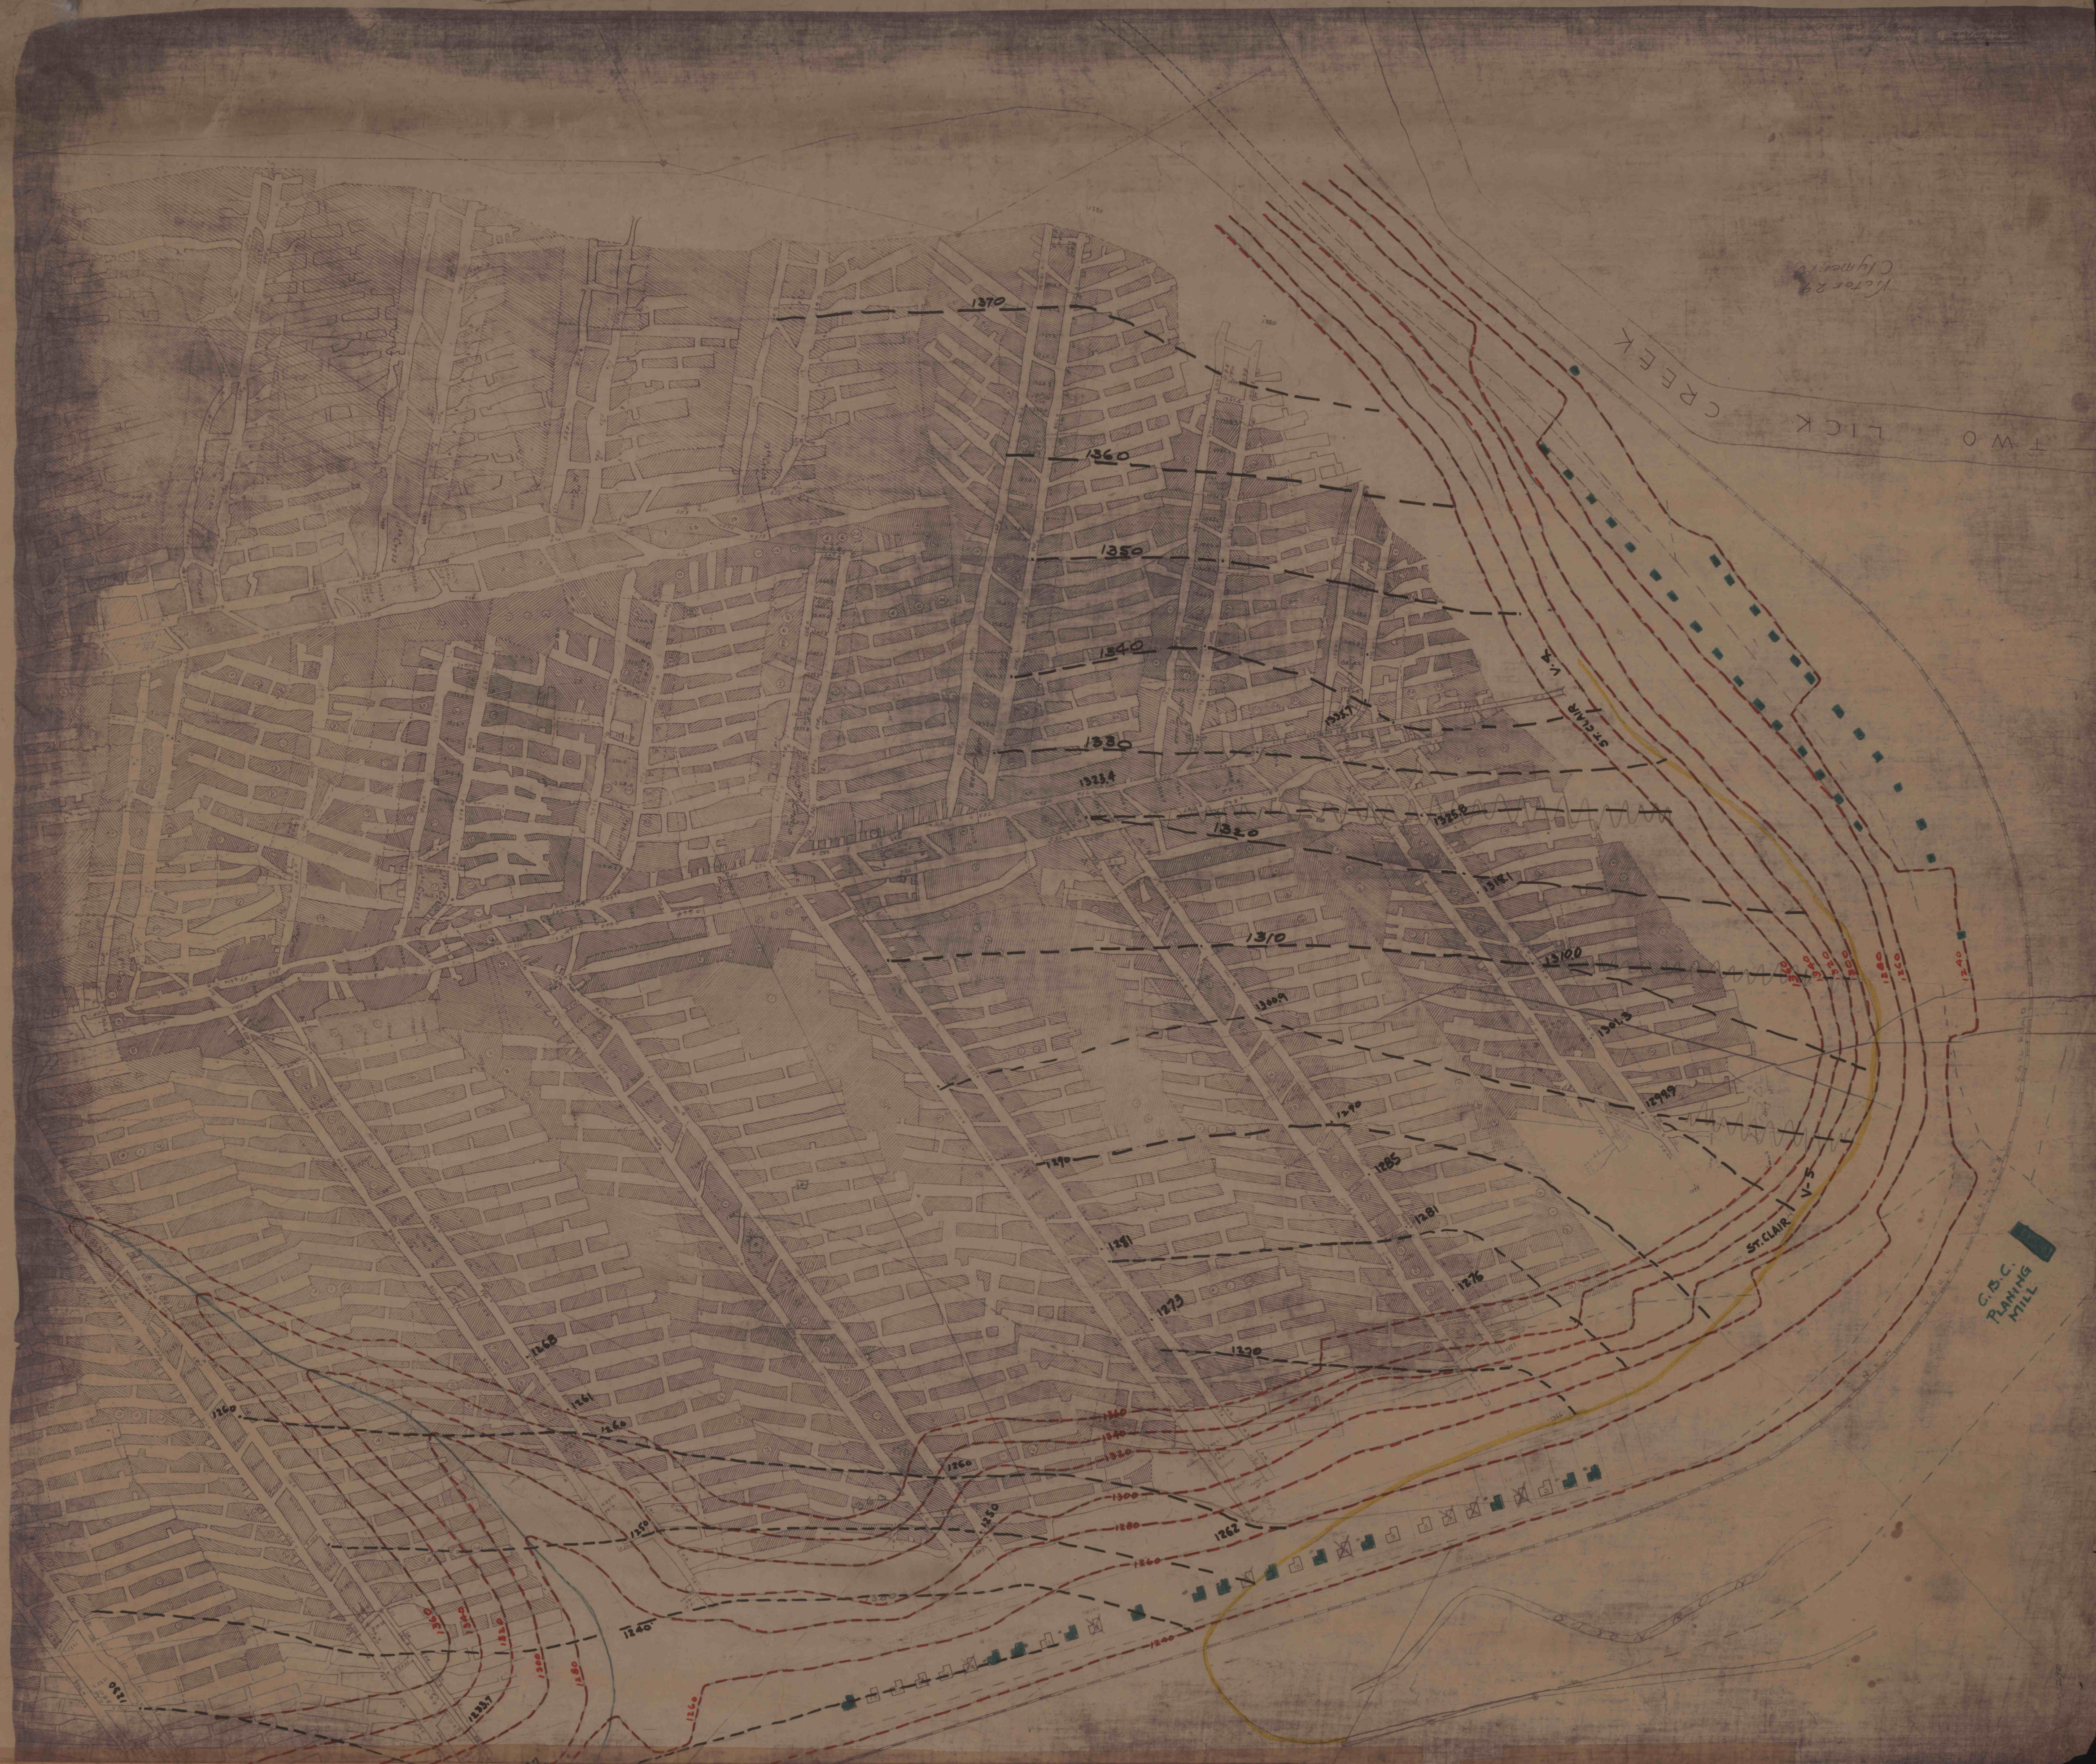

IMAPS#20830