


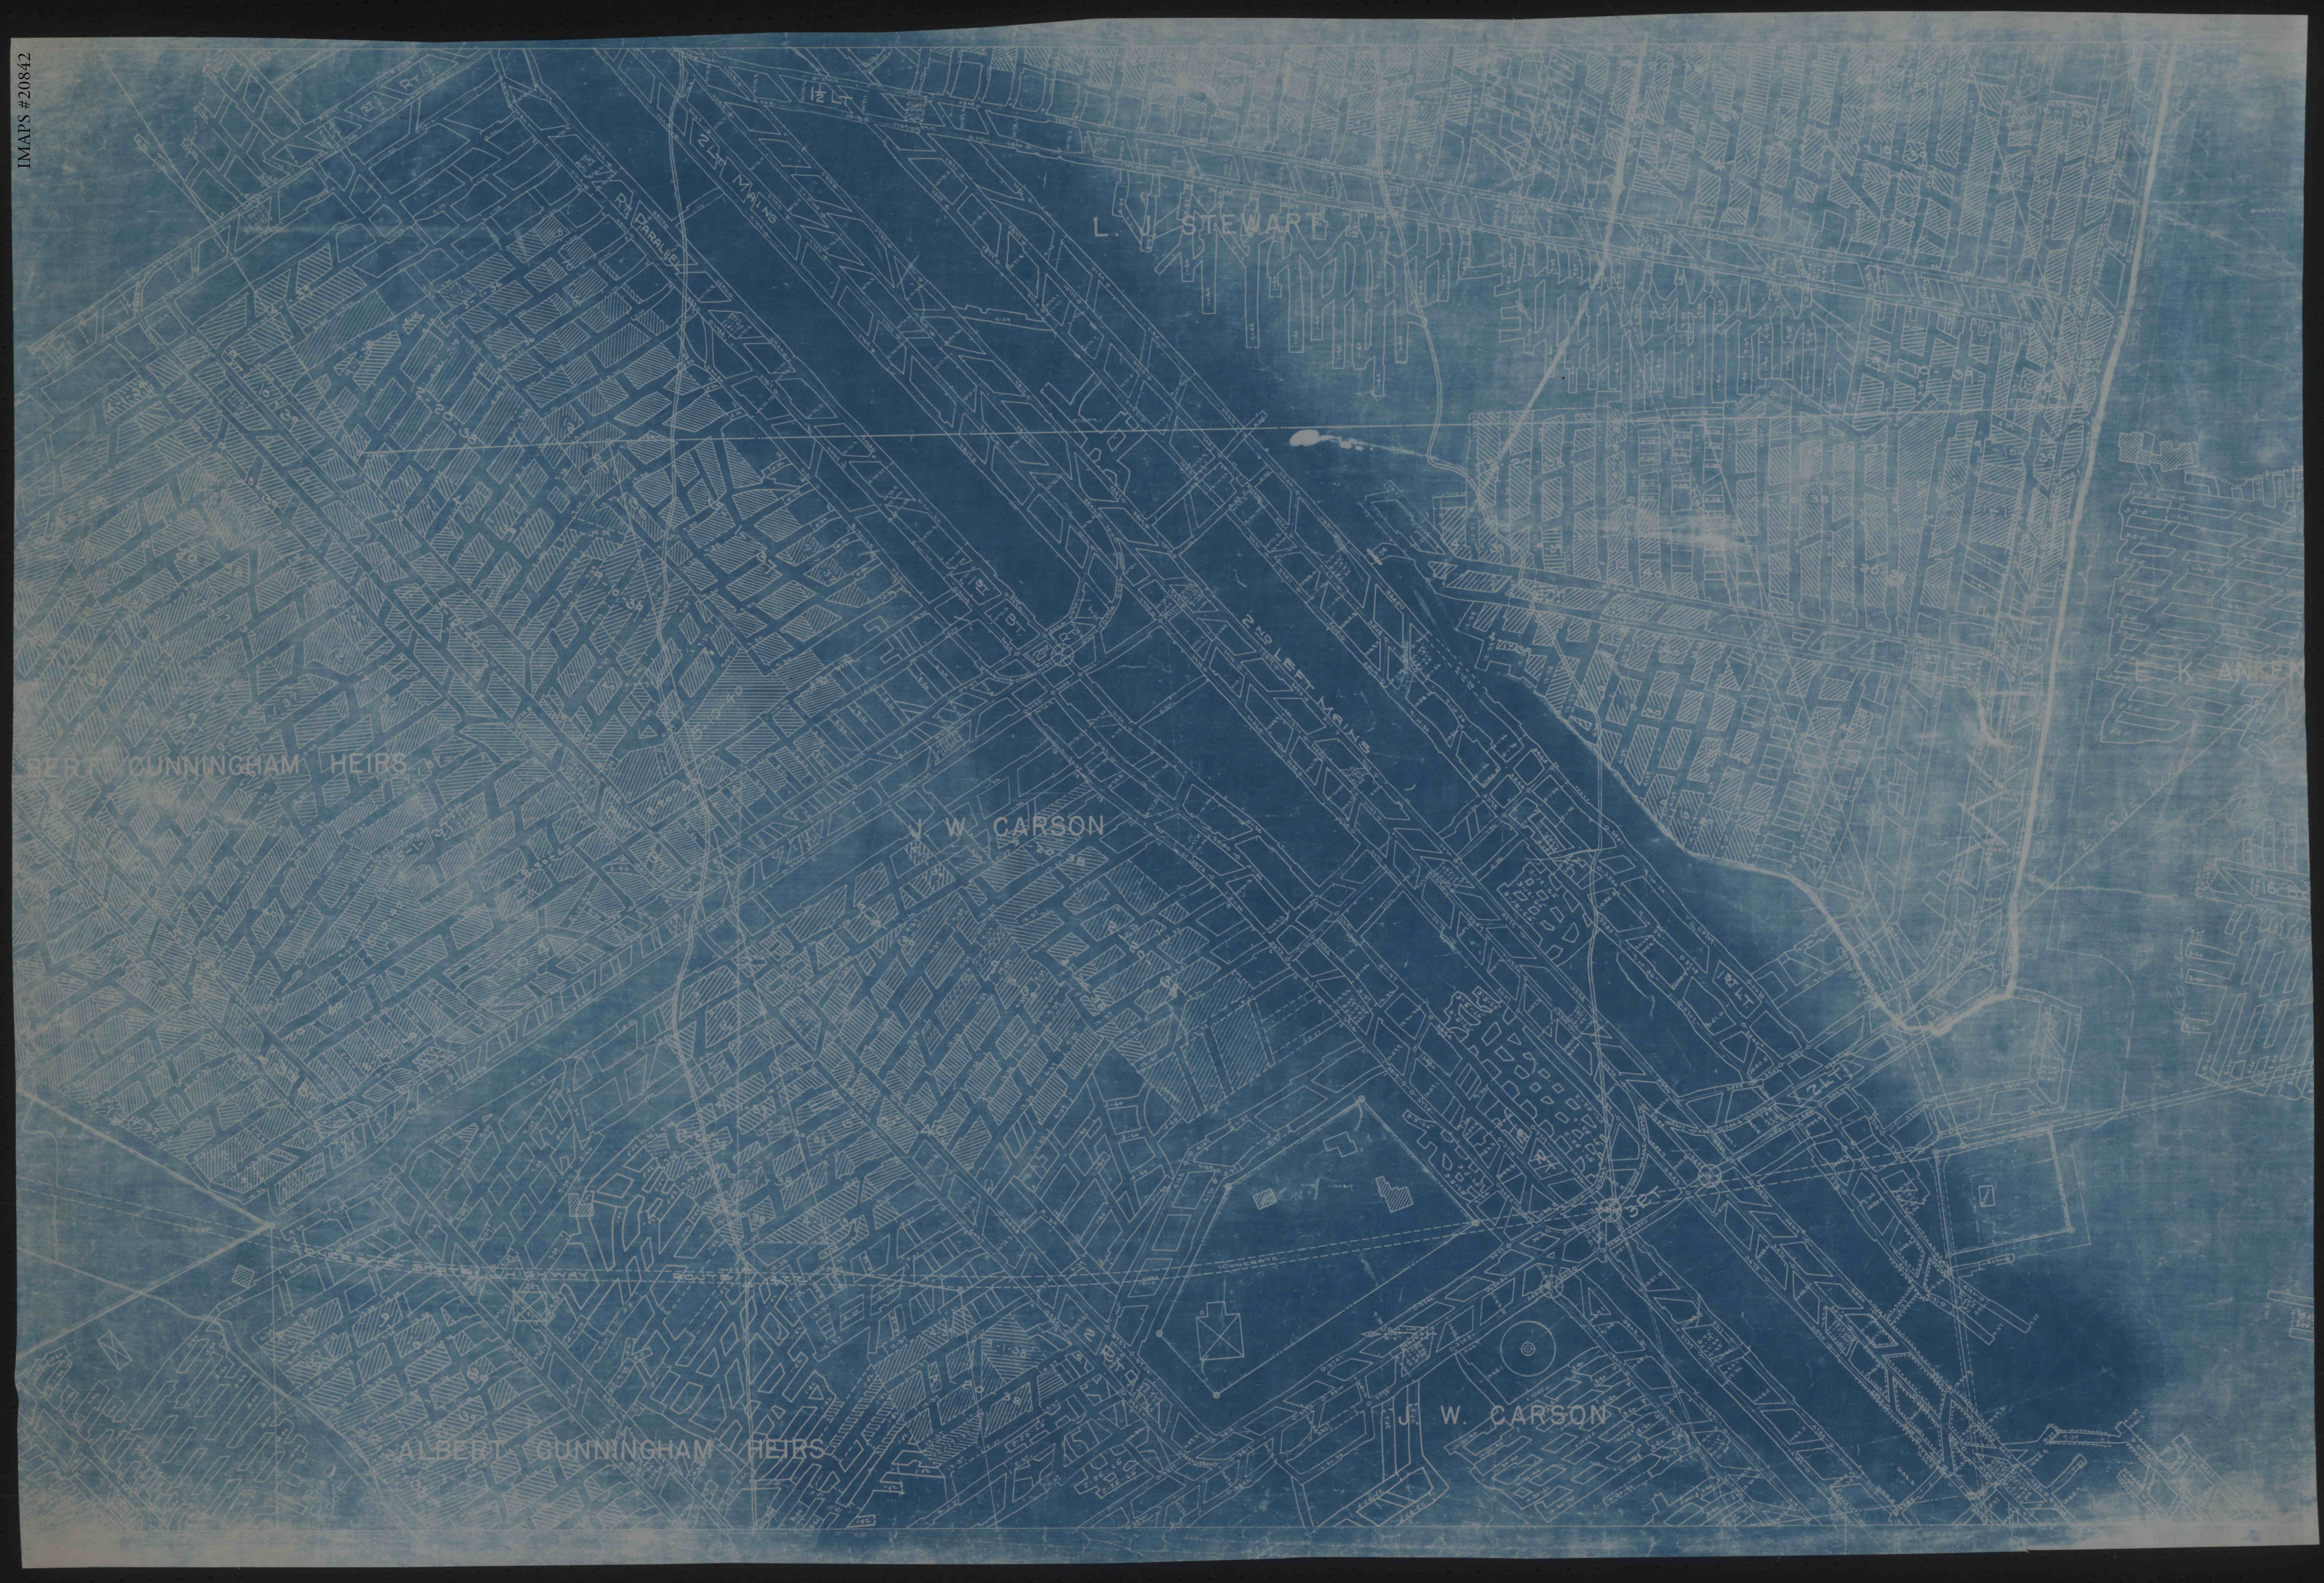

BERT CUNNINGHAM HEIRS

L J STEWART

J W CARSON

ALBERT CUNNINGHAM HEIRS

J W CARSON

2ND LEFT MAINS

2ND LEFT MAINS

50 FT HWY

PARALLEL

2ND LEFT MAINS

12 LT

12 LT

50 FT
























