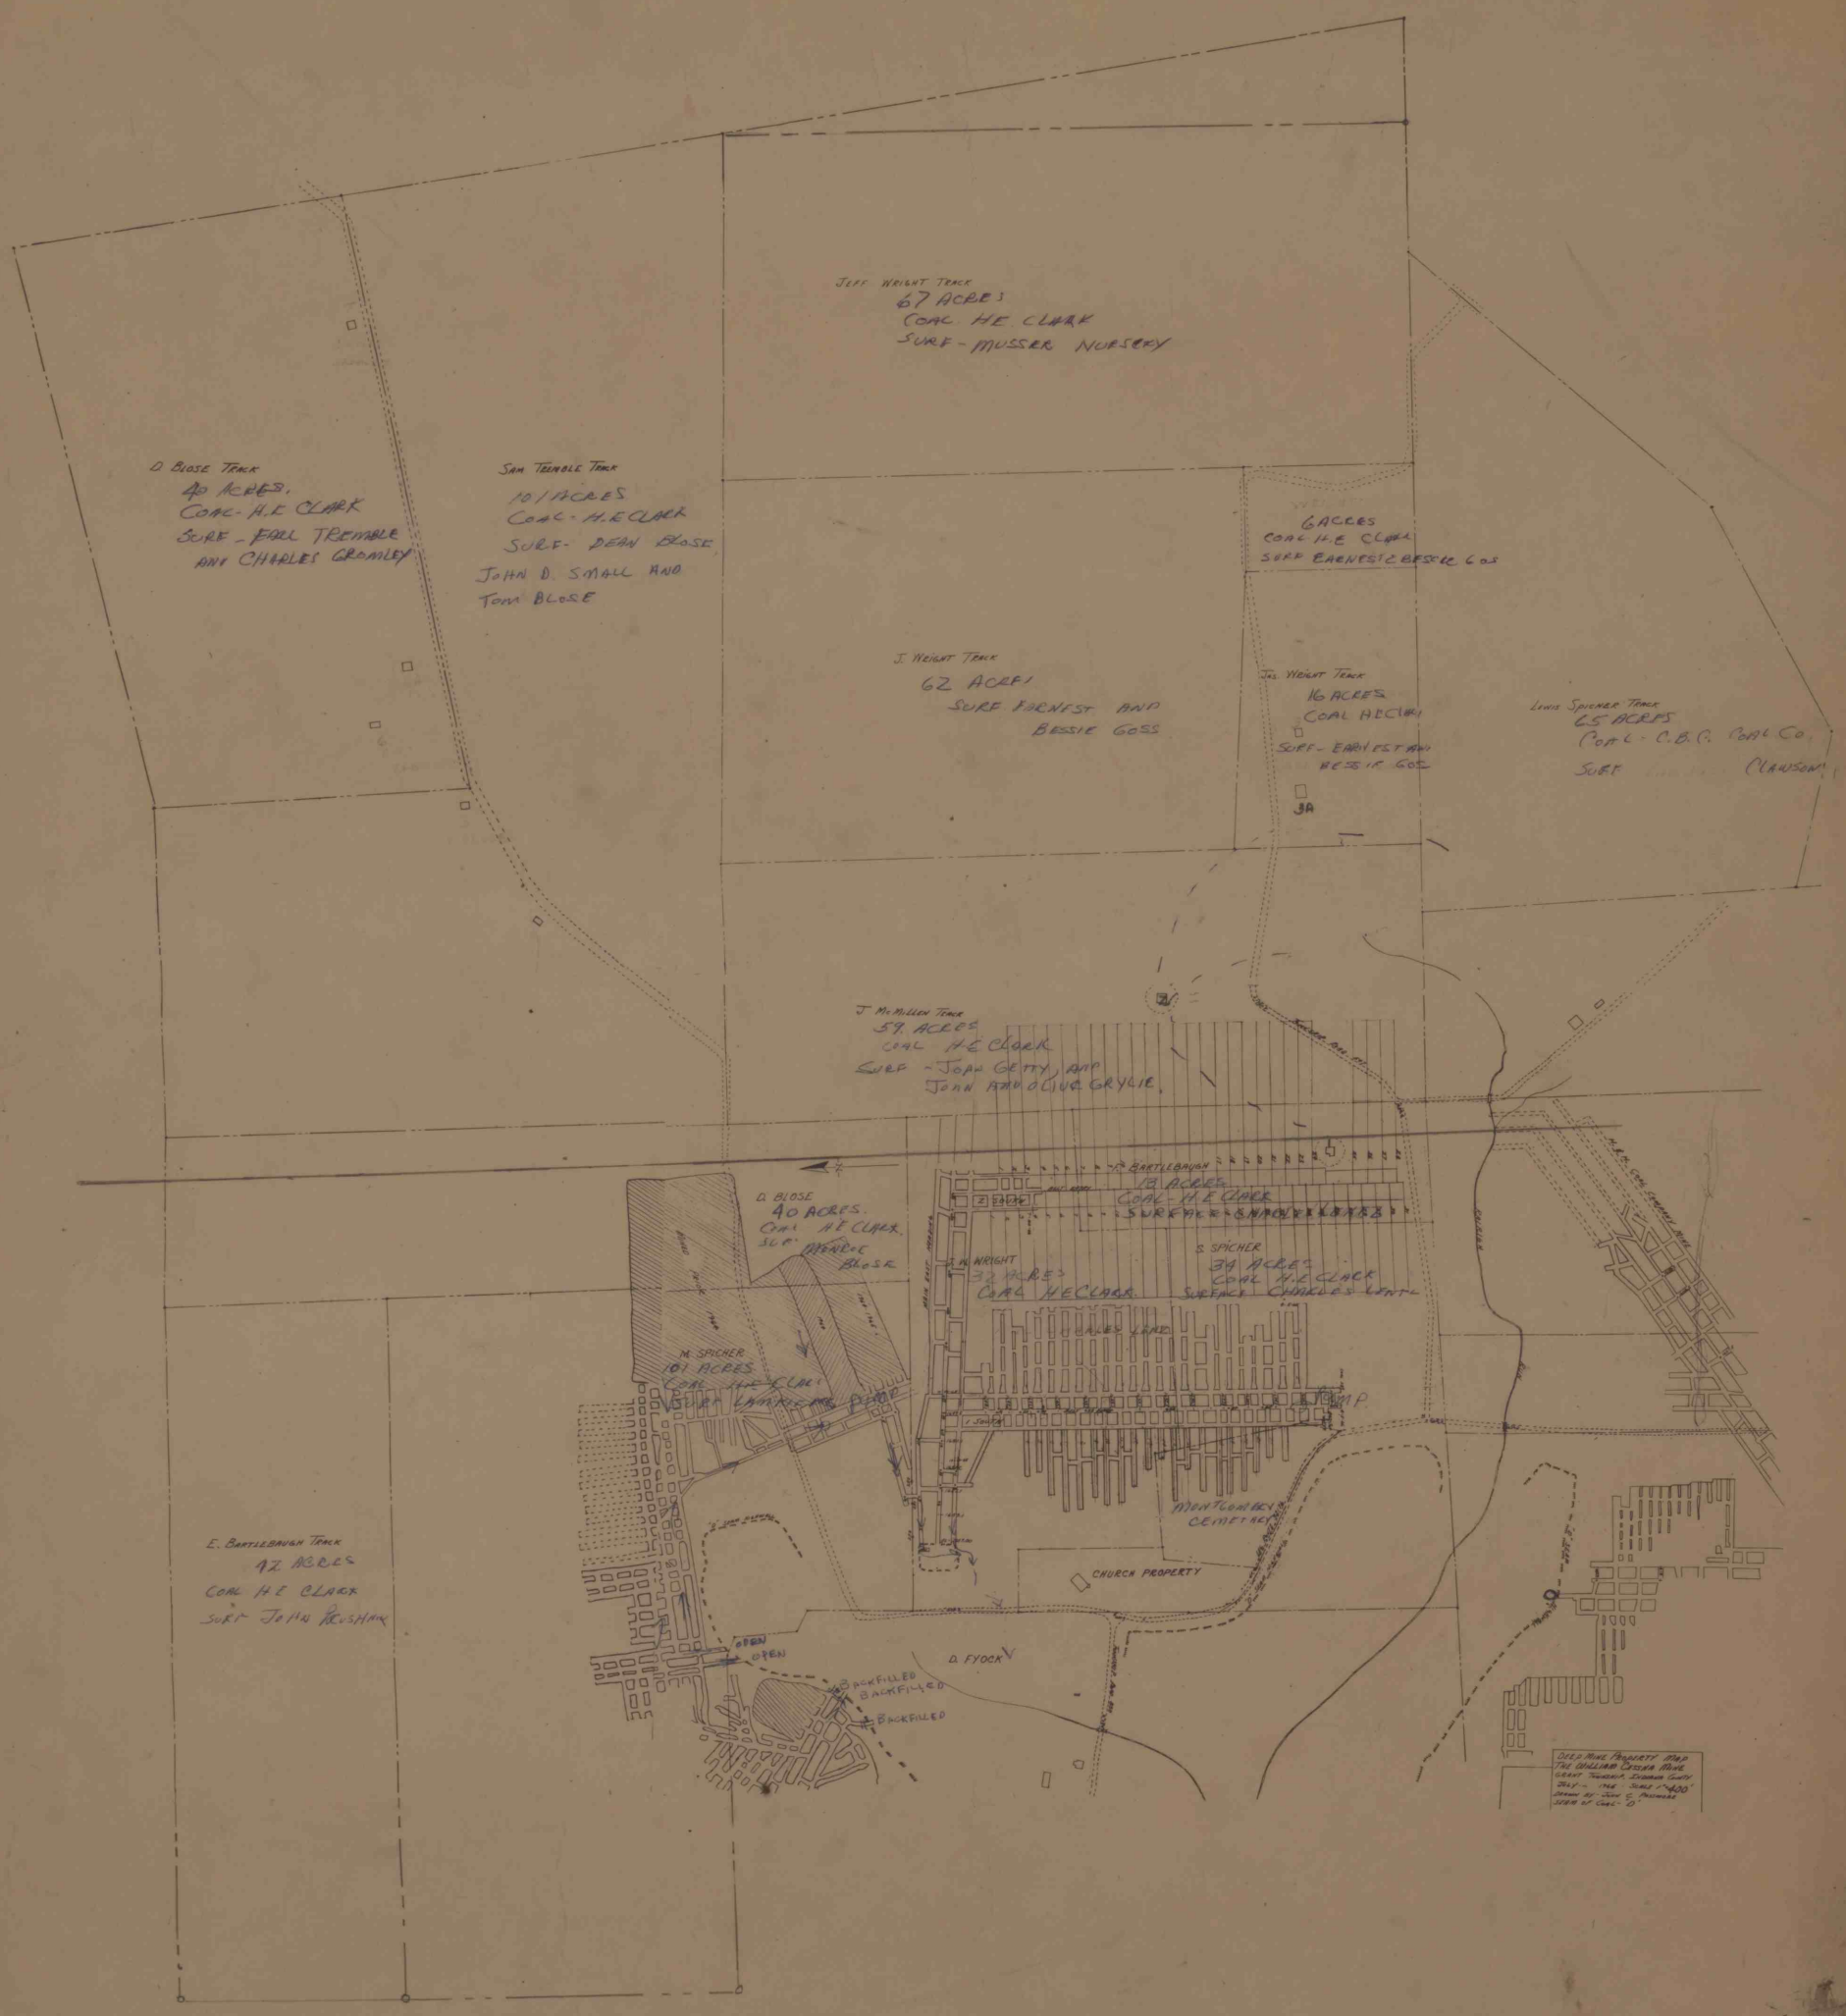
Jeff Wright Tract
67 Acres
Coal H.E. Clark
Surf - Musser Nursery
D. Blose Tract
40 Acres.
Coal - H.E. Clark
Surf - Earl Tremble
and Charles Gromley
Sam Tremble Tract
101 Acres
Coal - H.E. Clark
Surf - Dean Blose
John D. Small and
Tom Blose
6 Acres
Coal H.E. Clark
Surf Earnest & Bessie Goss
J. Wright Tract
62 Acres
Surf Earnest and
Bessie Goss
Jas. Wright Tract
16 Acres
Coal H.E. Clark
Surf - Earnest and
Bessie Goss
JA
Lewis Spicher Tract
65 Acres
Coal - C.B.C. Coal Co.
Surf Clawson
J. McMillen Tract
59 Acres
Coal H.E. Clark
Surf - John Getty, and
John and Olive Grylie
E. Bartlebaugh
13 Acres
Coal - H.E. Clark
Surface - Snavely Heirs
D. Blose
40 Acres.
Coal H.E. Clark.
Surf Minerd Blose
J. M. Wright
32 Acres
Coal H.E. Clark
S. Spicher
34 Acres
Coal H.E. Clark
Surface Charles Lentz
Sales Land
M. Spicher
101 Acres
Coal H.E. Clark
Surf Lantz
Pump
Montgomery Cemetery
Church Property
E. Bartlebaugh Tract
42 Acres
Coal H.E. Clark
Surf John Bushman
Open
Open
Backfilled
Backfilled
Backfilled
D. Fyock
Deep Mine Property Map
The William Costain Mine
Grant Township Jefferson County
July - 1948 Scale 1" = 400'
Seam of Coal - D'

IMAPS #20858