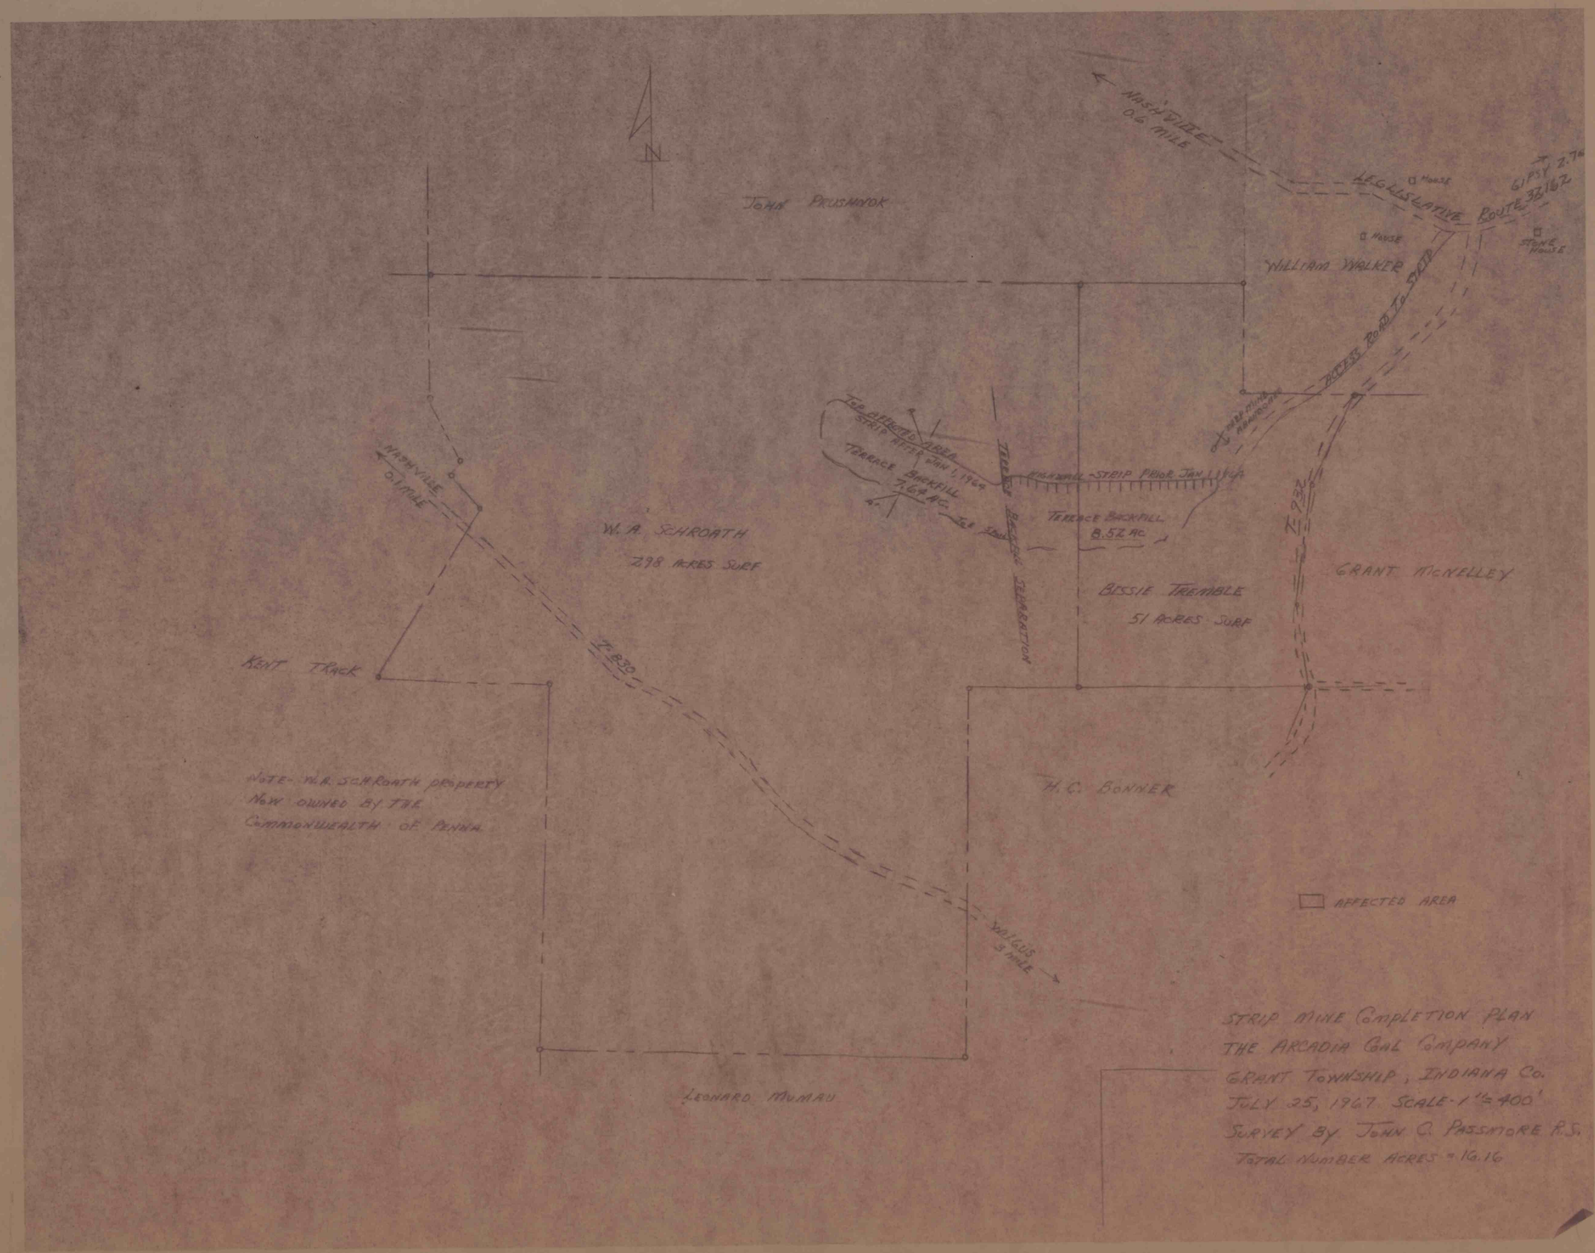
N
JOHN PRUSHNOK
WILLIAM WALKER
LEGISLATIVE ROUTE 32162
W. A. SCHROATH
278 ACRES SURF
BISSIE TRAMBLE
51 ACRES SURF
GRANT MCNELLEY
H. C. BONNER
KENT TRACK
LEONARD MUMAW
AFFECTED AREA
NOTE- W.A. SCHROATH PROPERTY NOW OWNED BY THE COMMONWEALTH OF PENNA.
STRIP MINE COMPLETION PLAN
THE ARCADIA COAL COMPANY
GRANT TOWNSHIP, INDIANA CO.
JULY 25, 1967 SCALE- 1"=400'
SURVEY BY JOHN C. PASSMORE R.S.
TOTAL NUMBER ACRES = 16.16

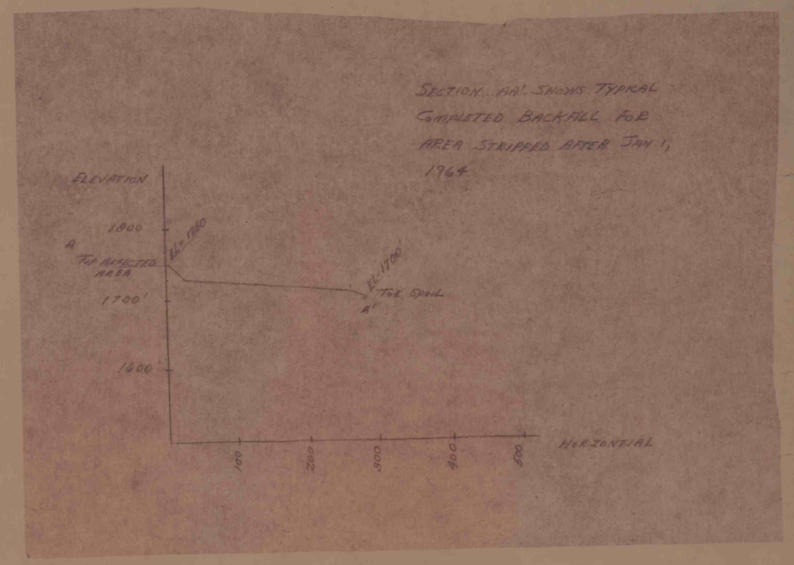
SECTION AA' SHOWS TYPICAL COMPLETED BACKFILL FOR AREA STRIPPED AFTER JAN. 1, 1964
ELEVATION
1800
1700
1600
A
A'
TOP OF SPOIL
HORIZONTAL
100
200
300
400
500

IMAPS#20872