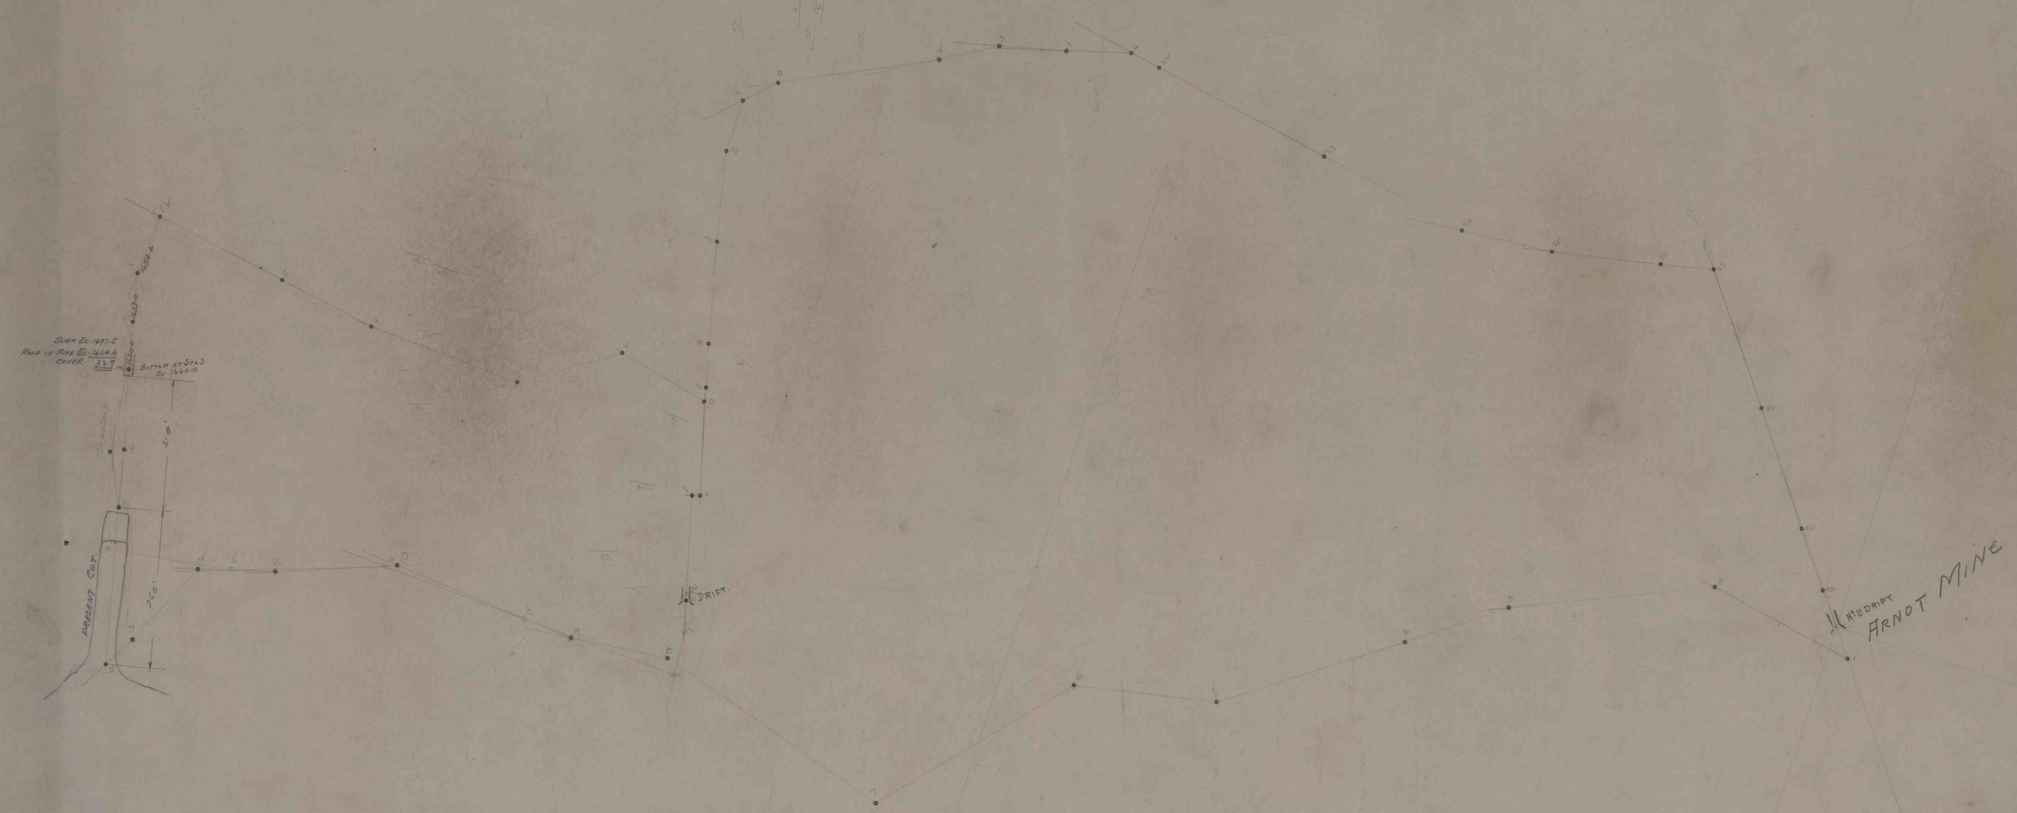
Sill El. 1671.6
Roof in Mine El. 1668.6
Cover. 3.0
Bottom of Sump El. 1665.0
PRESENT CUT
DRIFT.
No 2 DRIFT
ARNOT MINE