


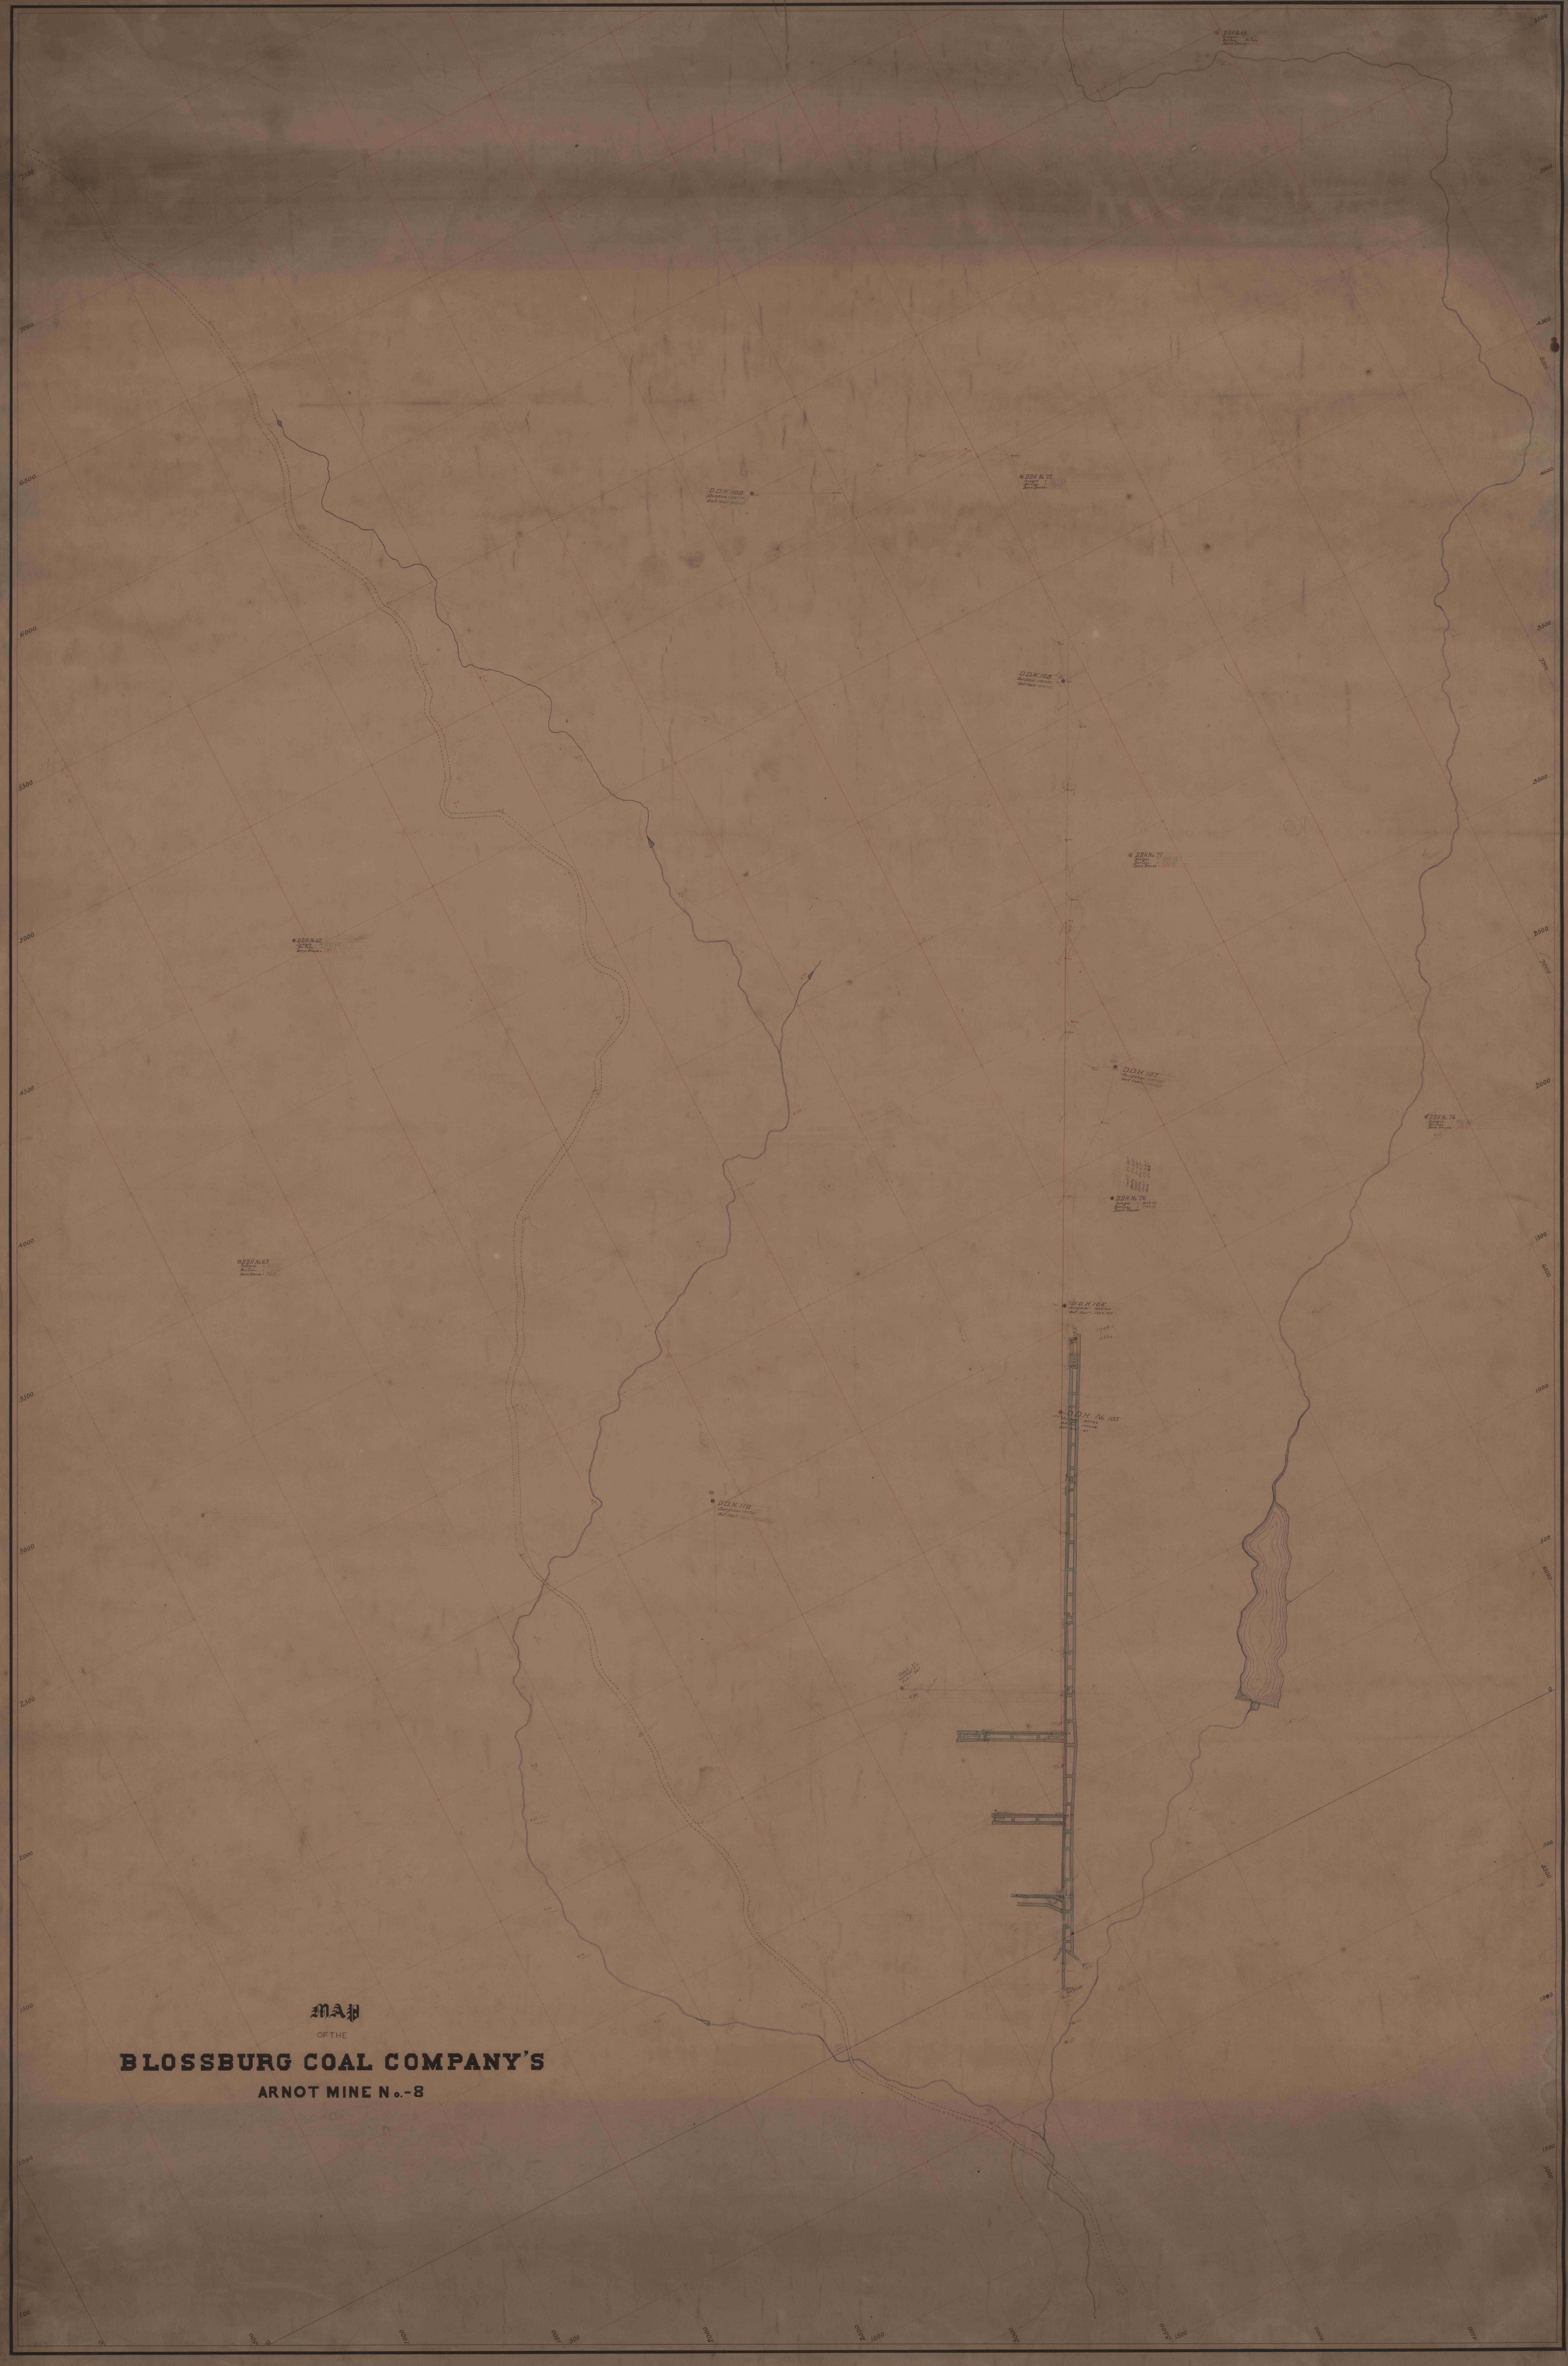

MAP
OF THE
BLOSSBURG COAL COMPANY'S
ARNOT MINE No.-8