


Water Shaded @ 50' / year

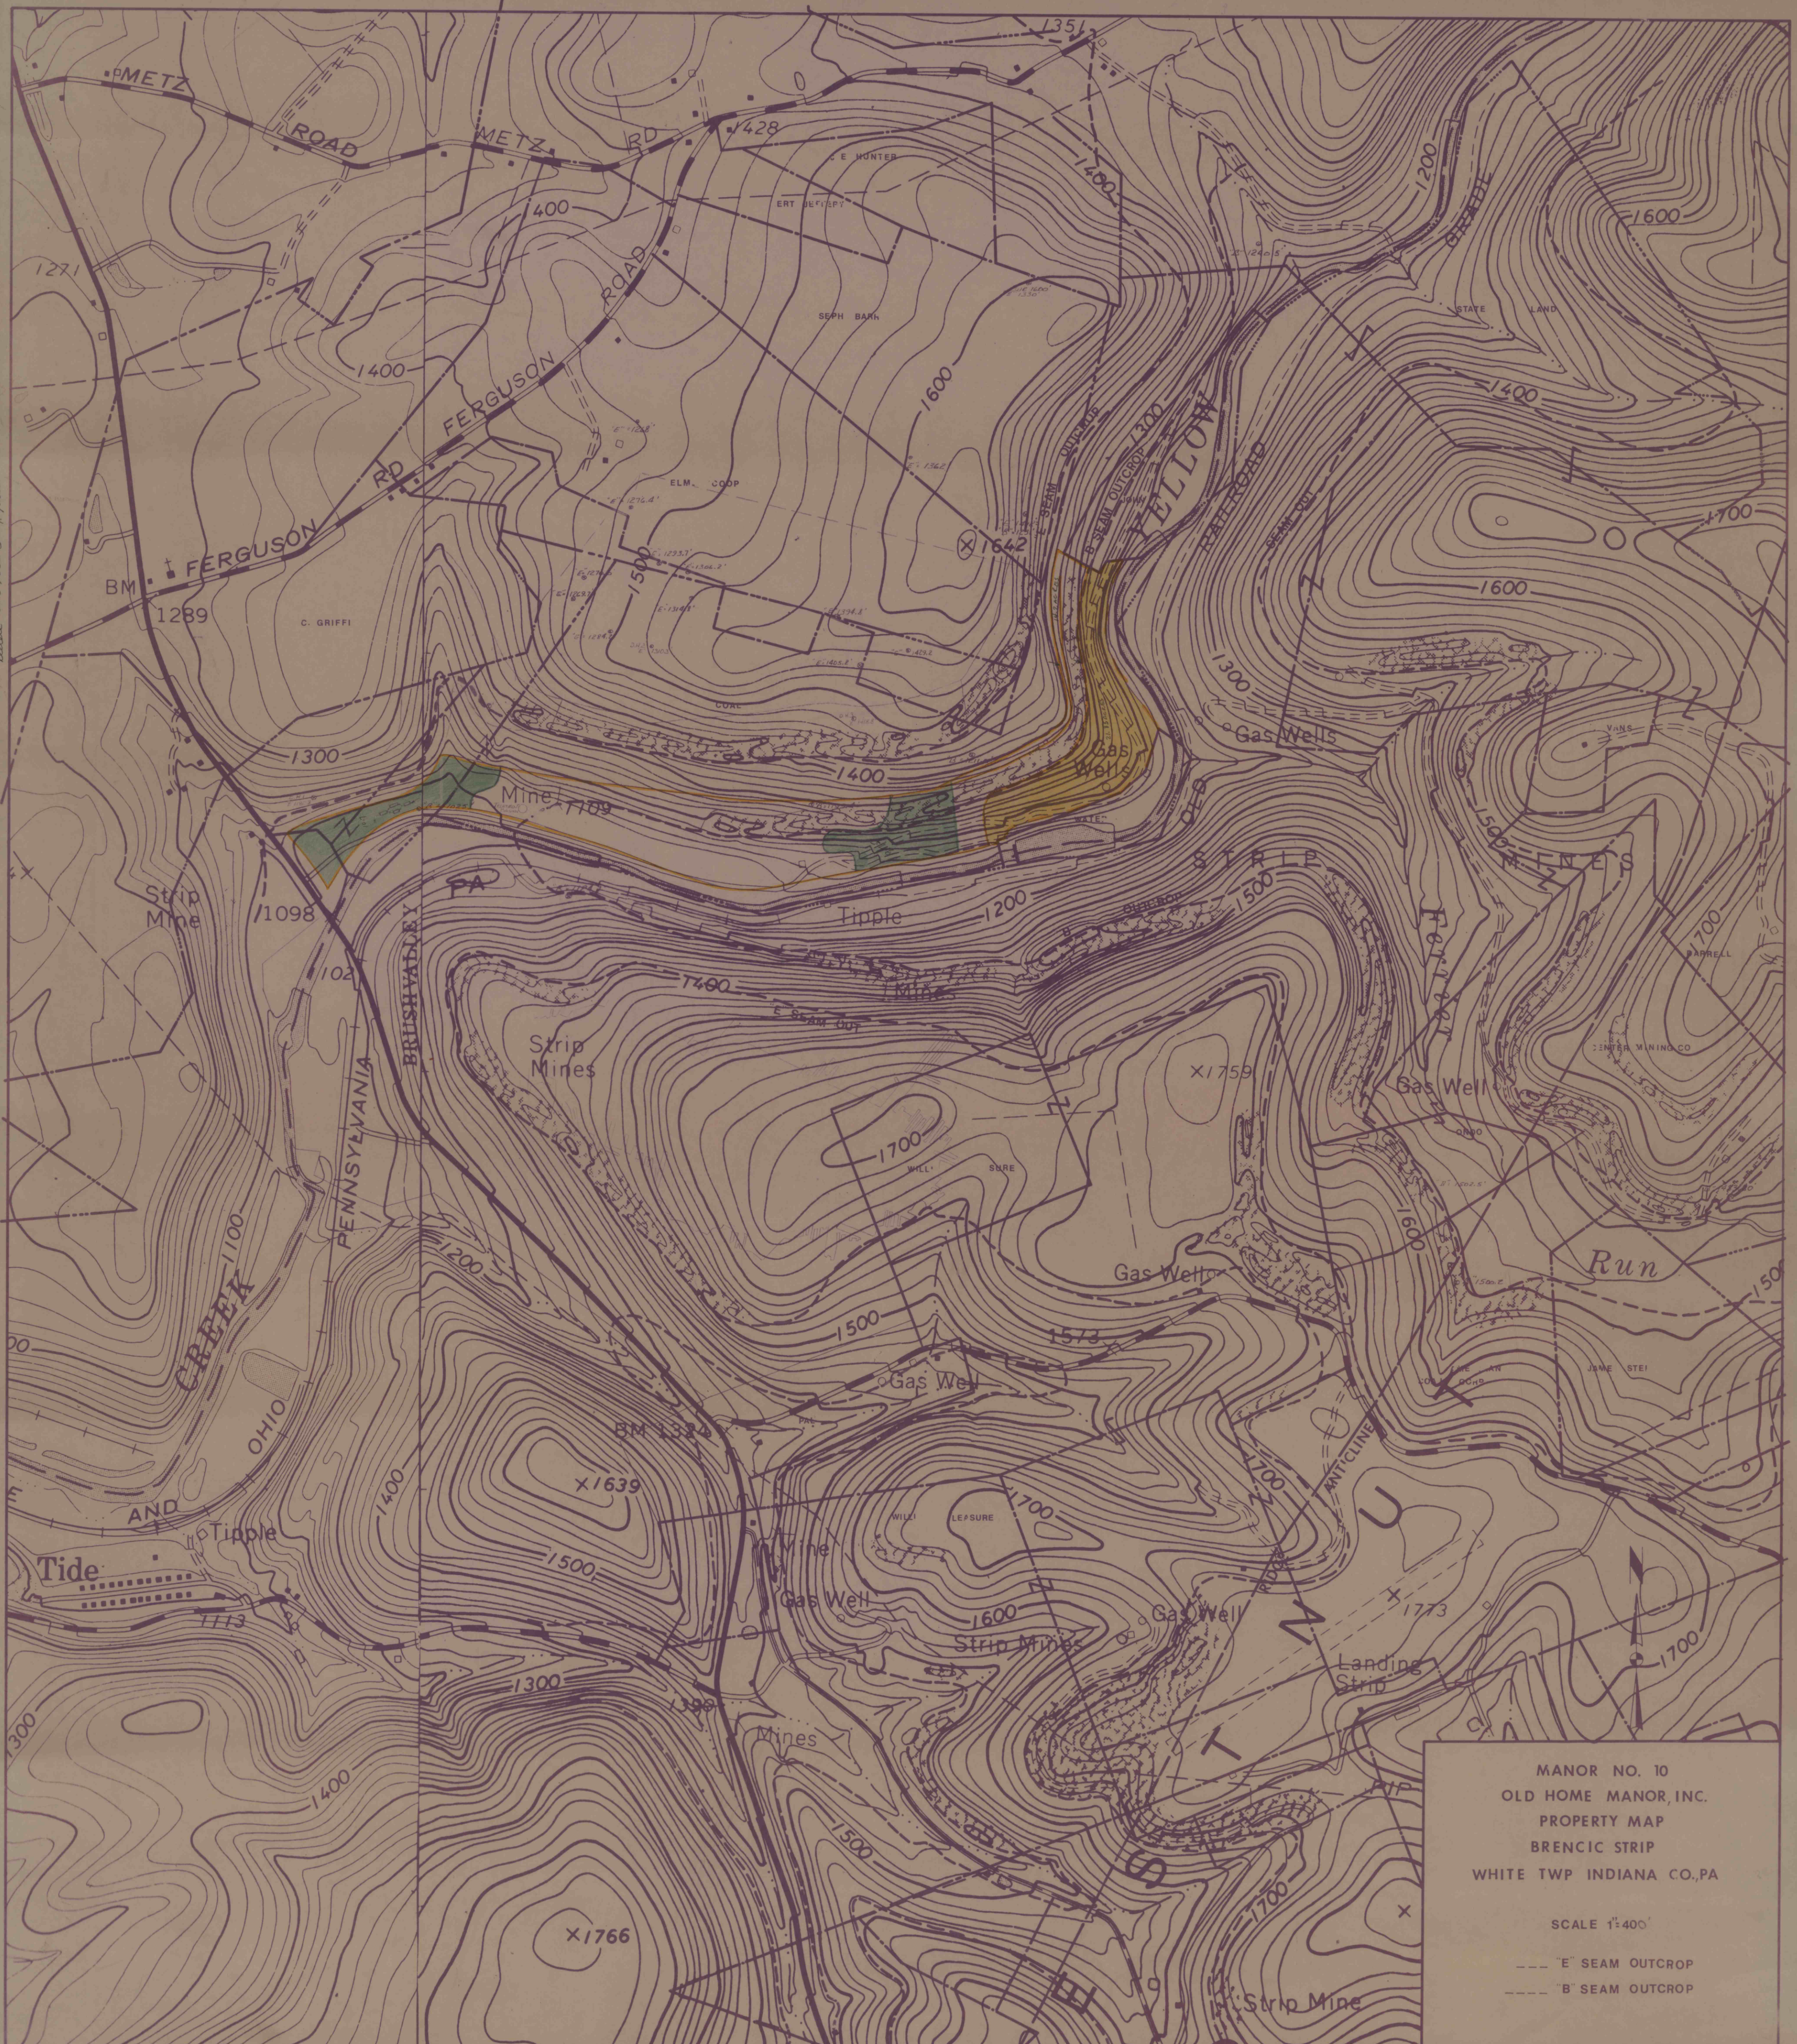

MANOR NO. 10
OLD HOME MANOR, INC.
PROPERTY MAP
BRENCIC STRIP
WHITE TWP INDIANA CO., PA

SCALE 1"=400'

--- "E" SEAM OUTCROP
--- "B" SEAM OUTCROP