


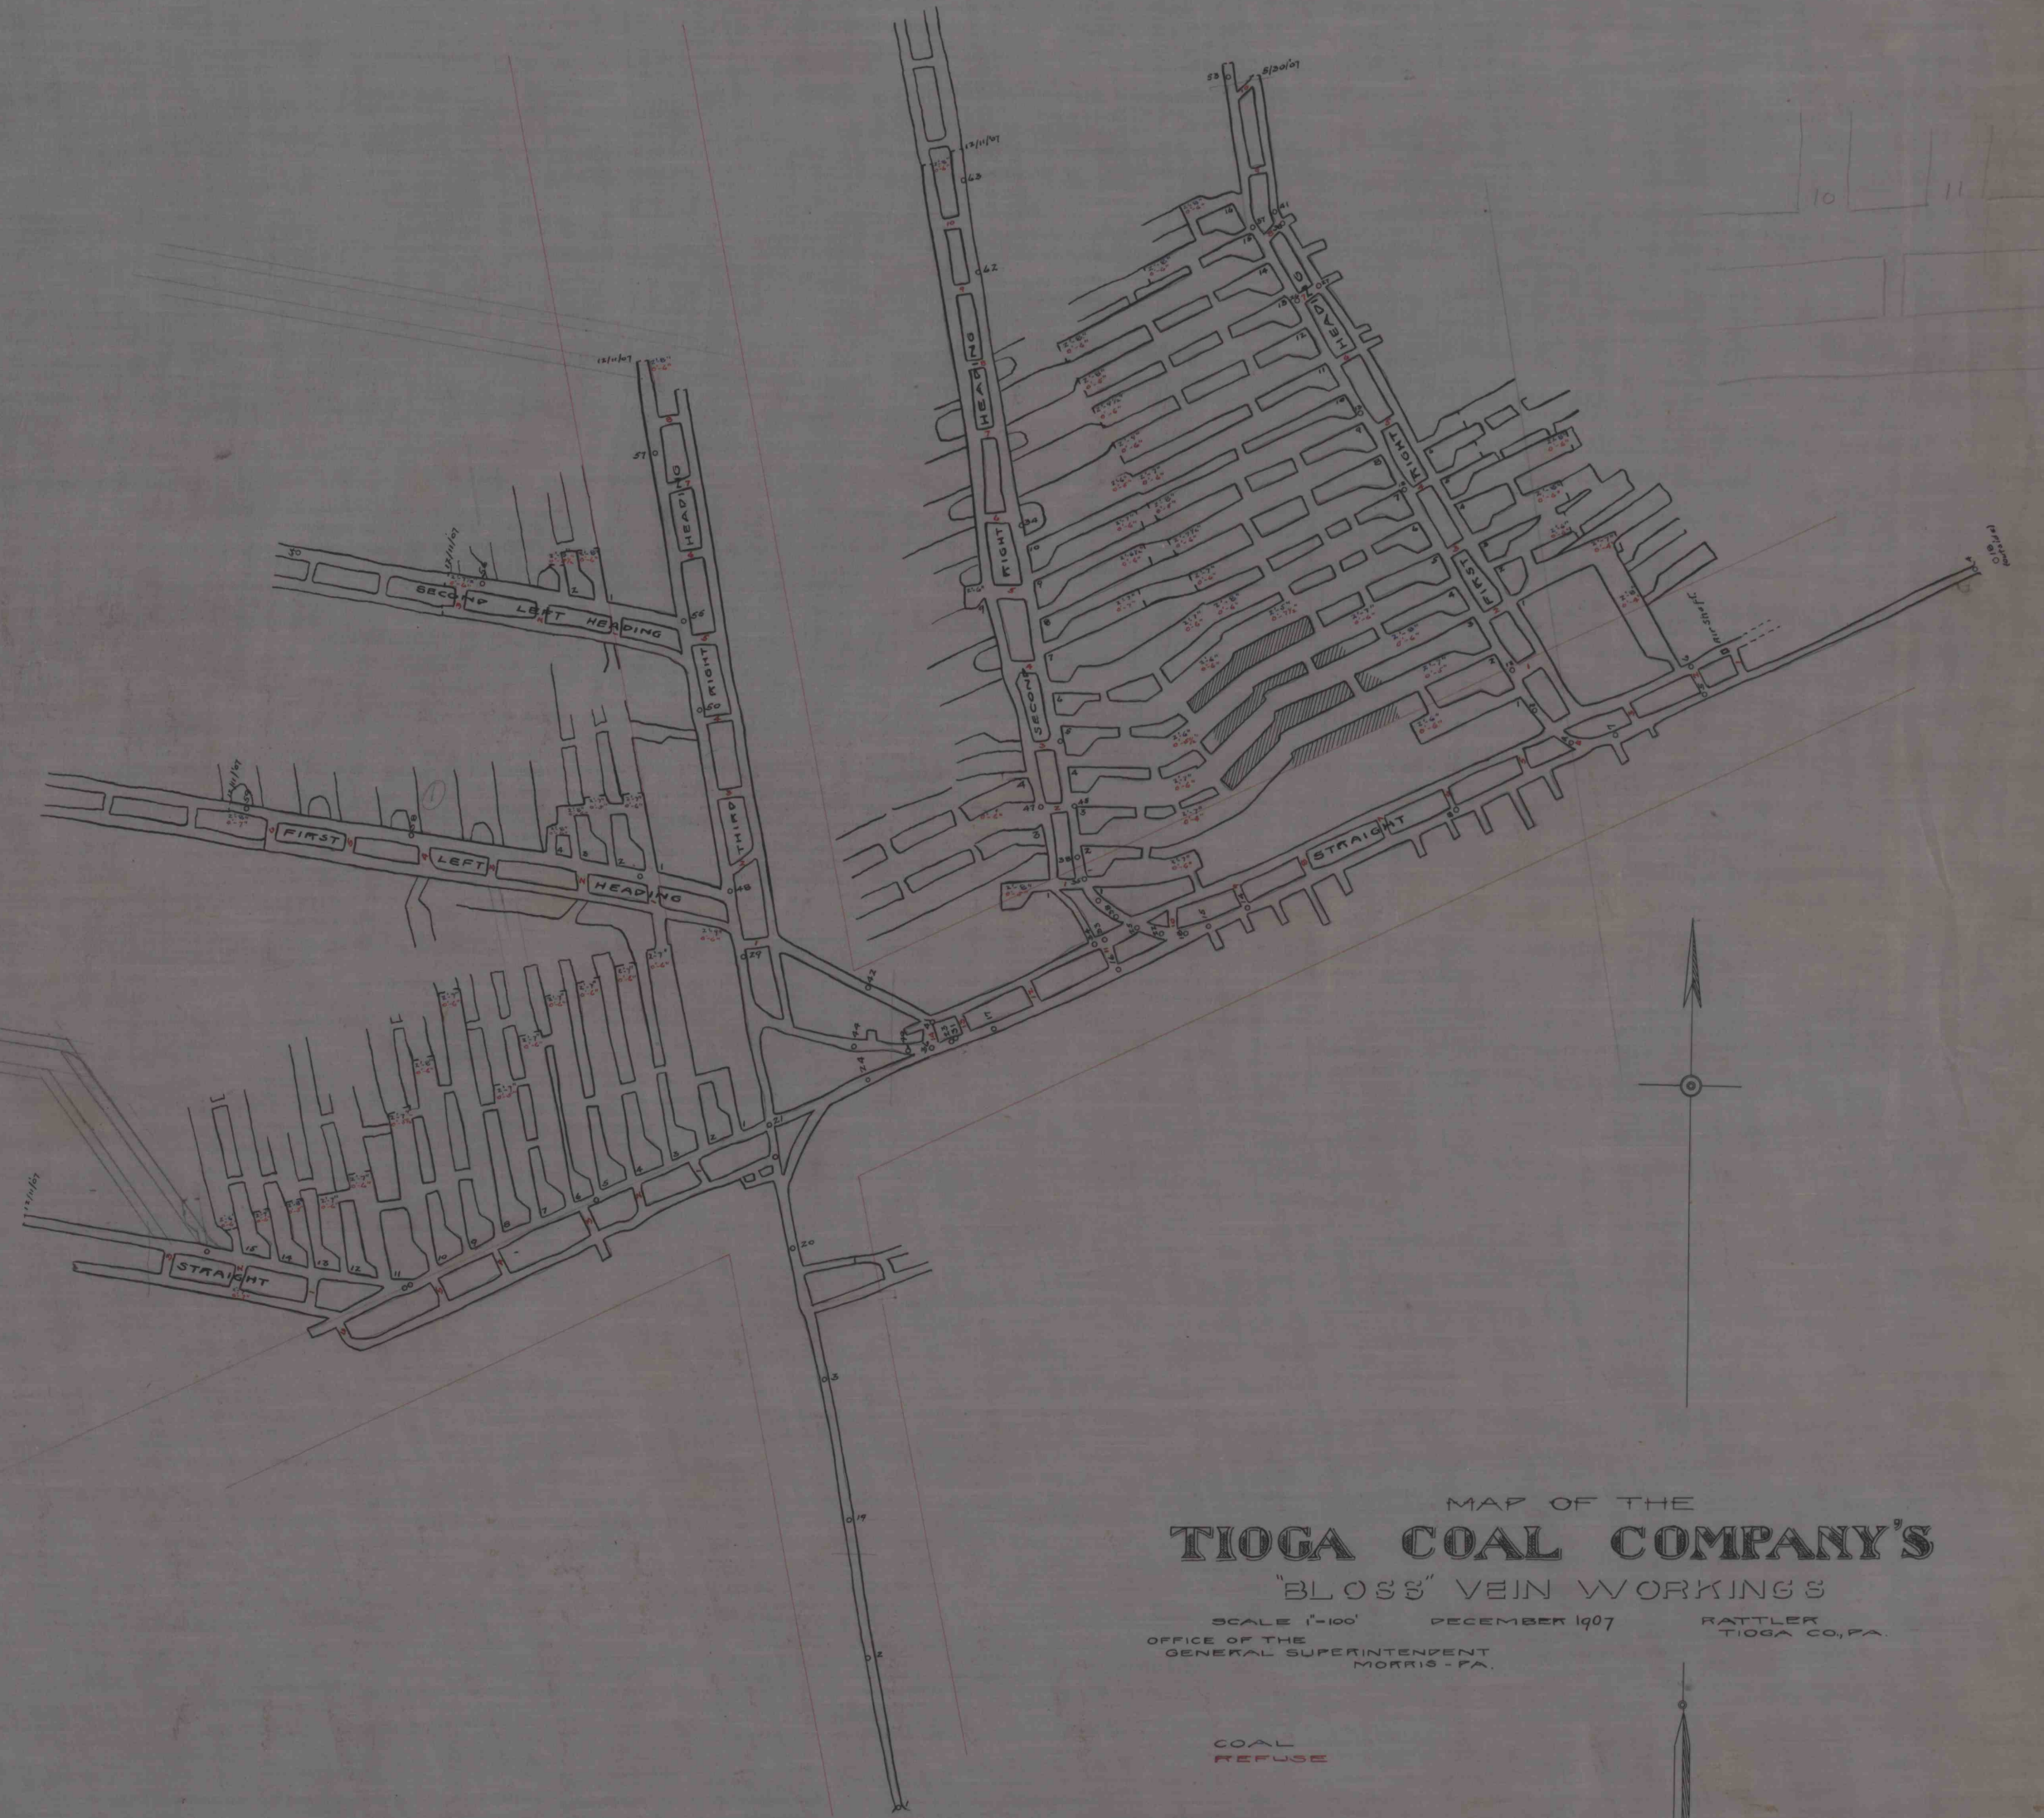

MAP OF THE
TIOGA COAL COMPANY'S
"BLOSS" VEIN WORKINGS

SCALE 1"=100' DECEMBER 1907 RATTLET
OFFICE OF THE GENERAL SUPERINTENDENT TIOGA CO., PA.
MORRIS, PA.

COAL
REFUSE