


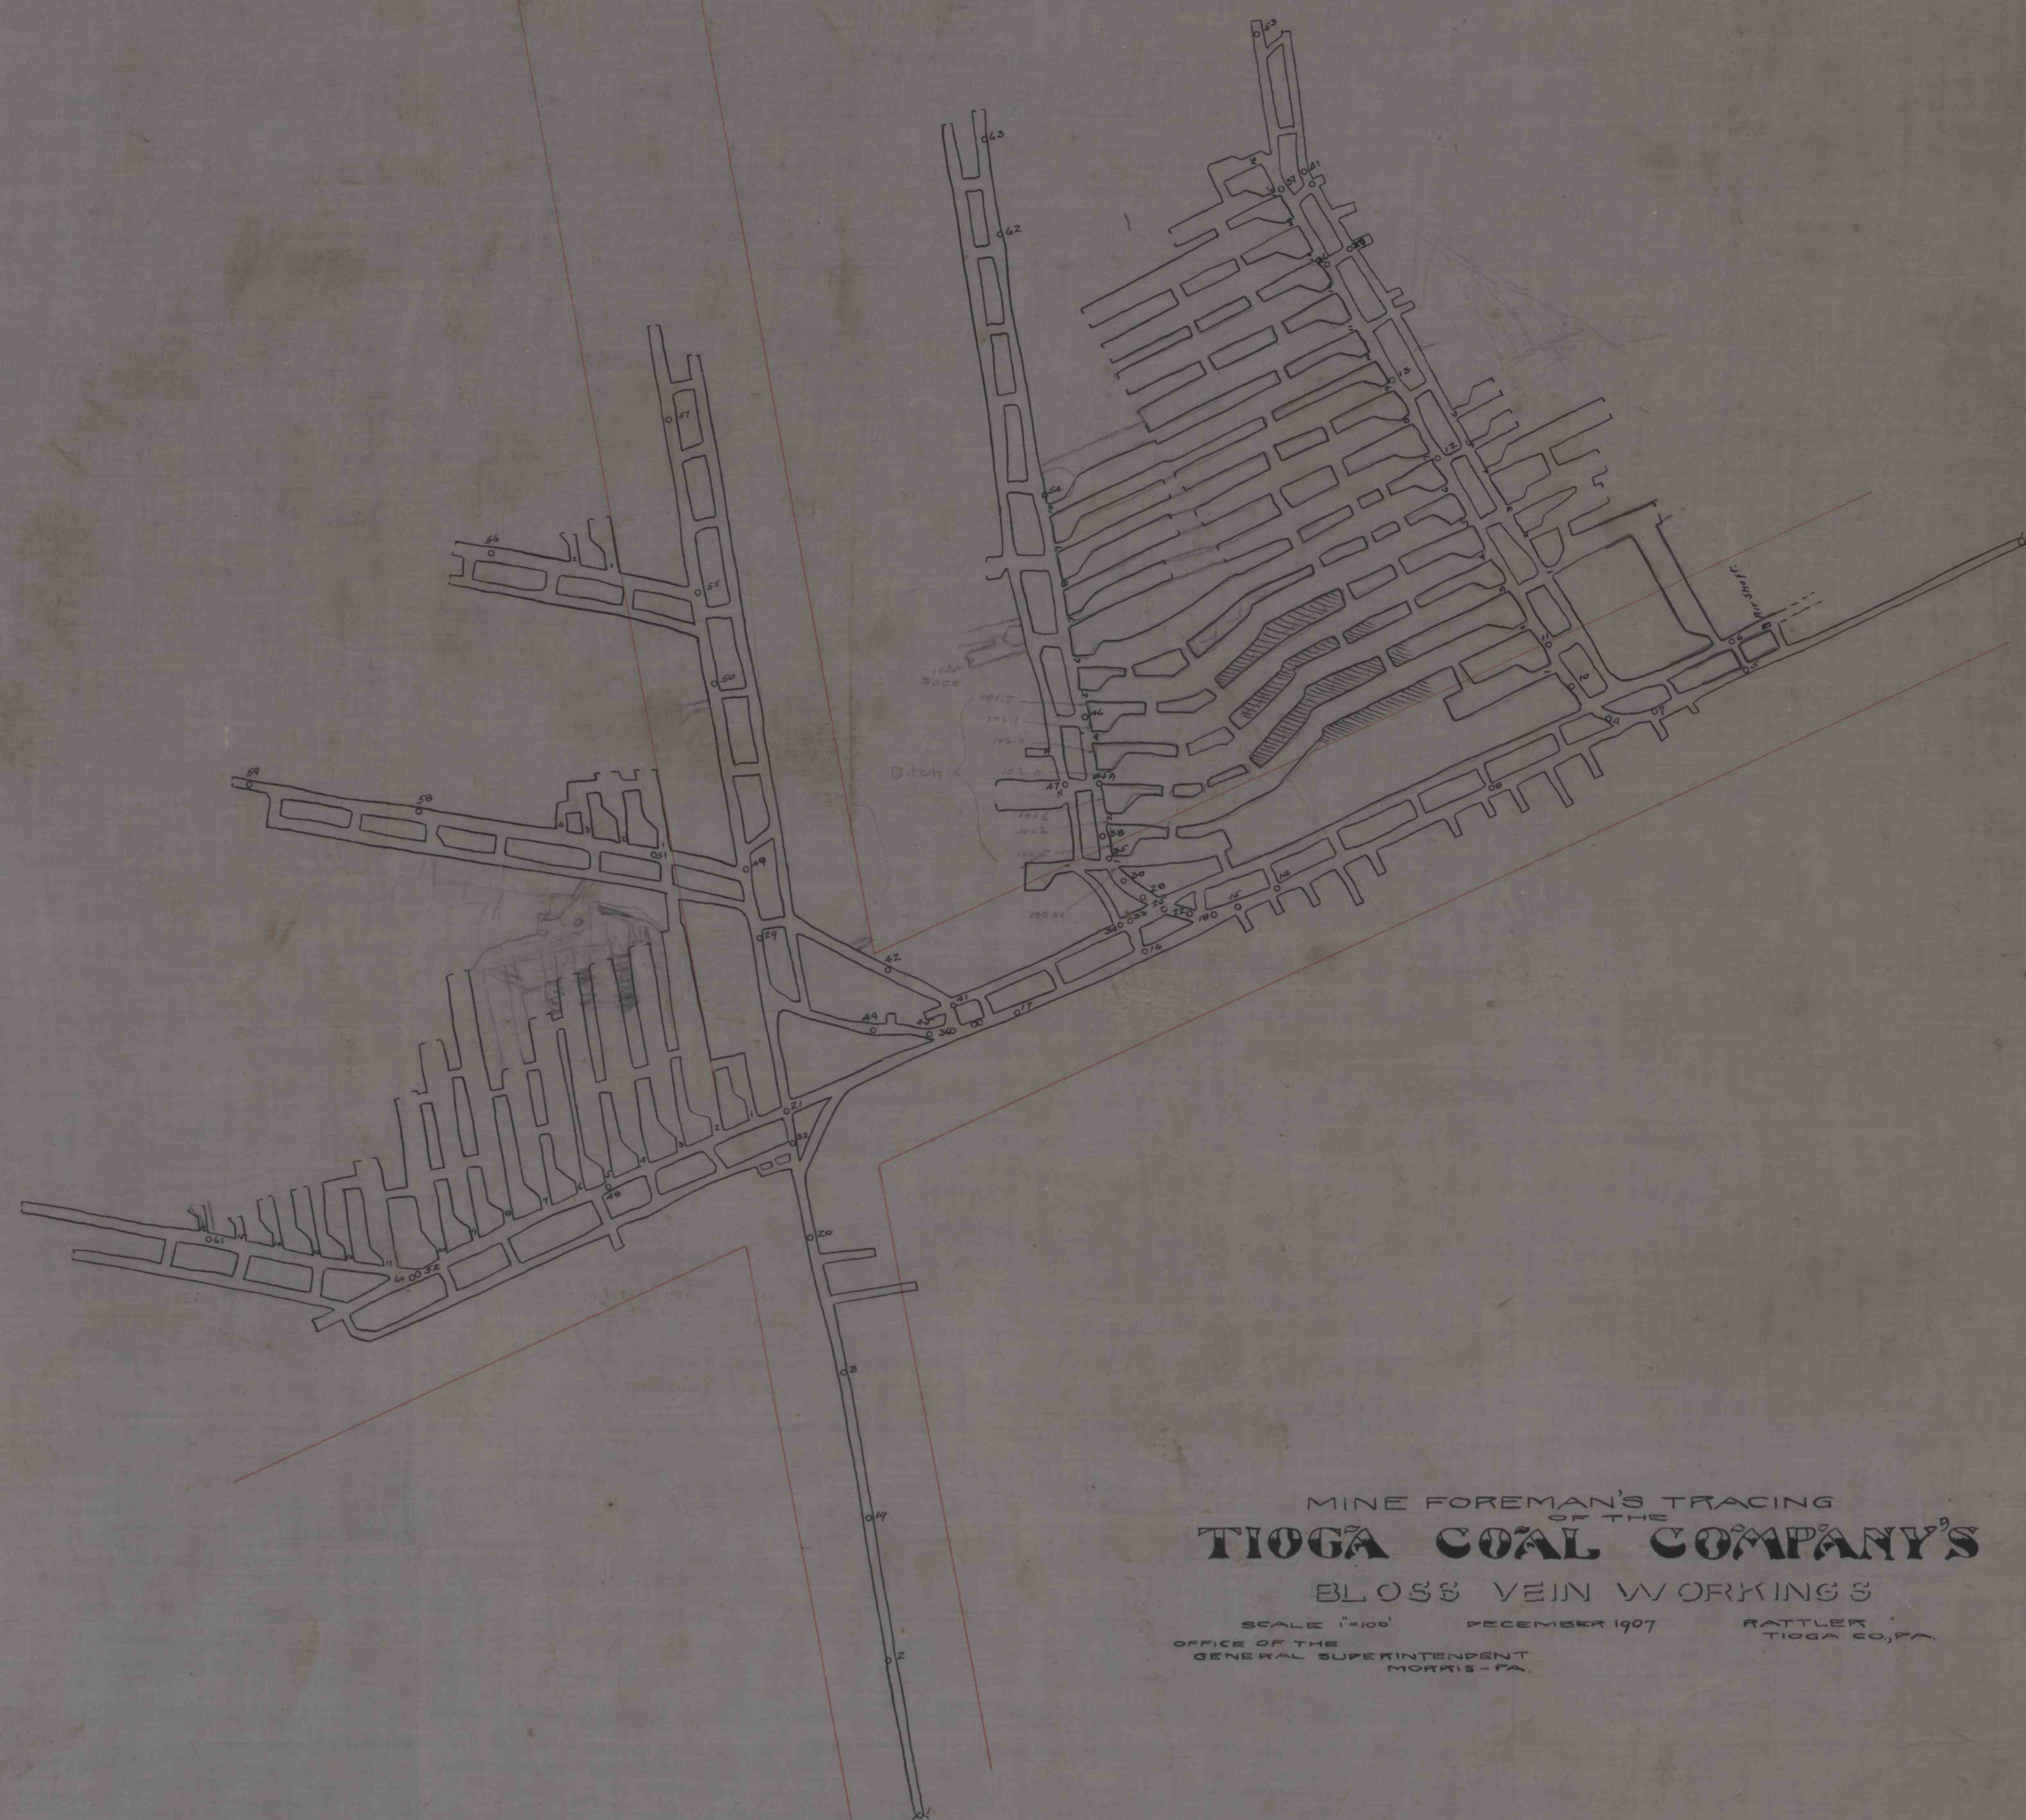

MINE FOREMAN'S TRACING
OF THE
TIoga COAL COMPANY'S
BLOSS VEIN WORKINGS
SCALE 1"=100' DECEMBER 1907
OFFICE OF THE GENERAL SUPERINTENDENT MORRIS-PA.
RATTLER
TIoga CO., PA.