


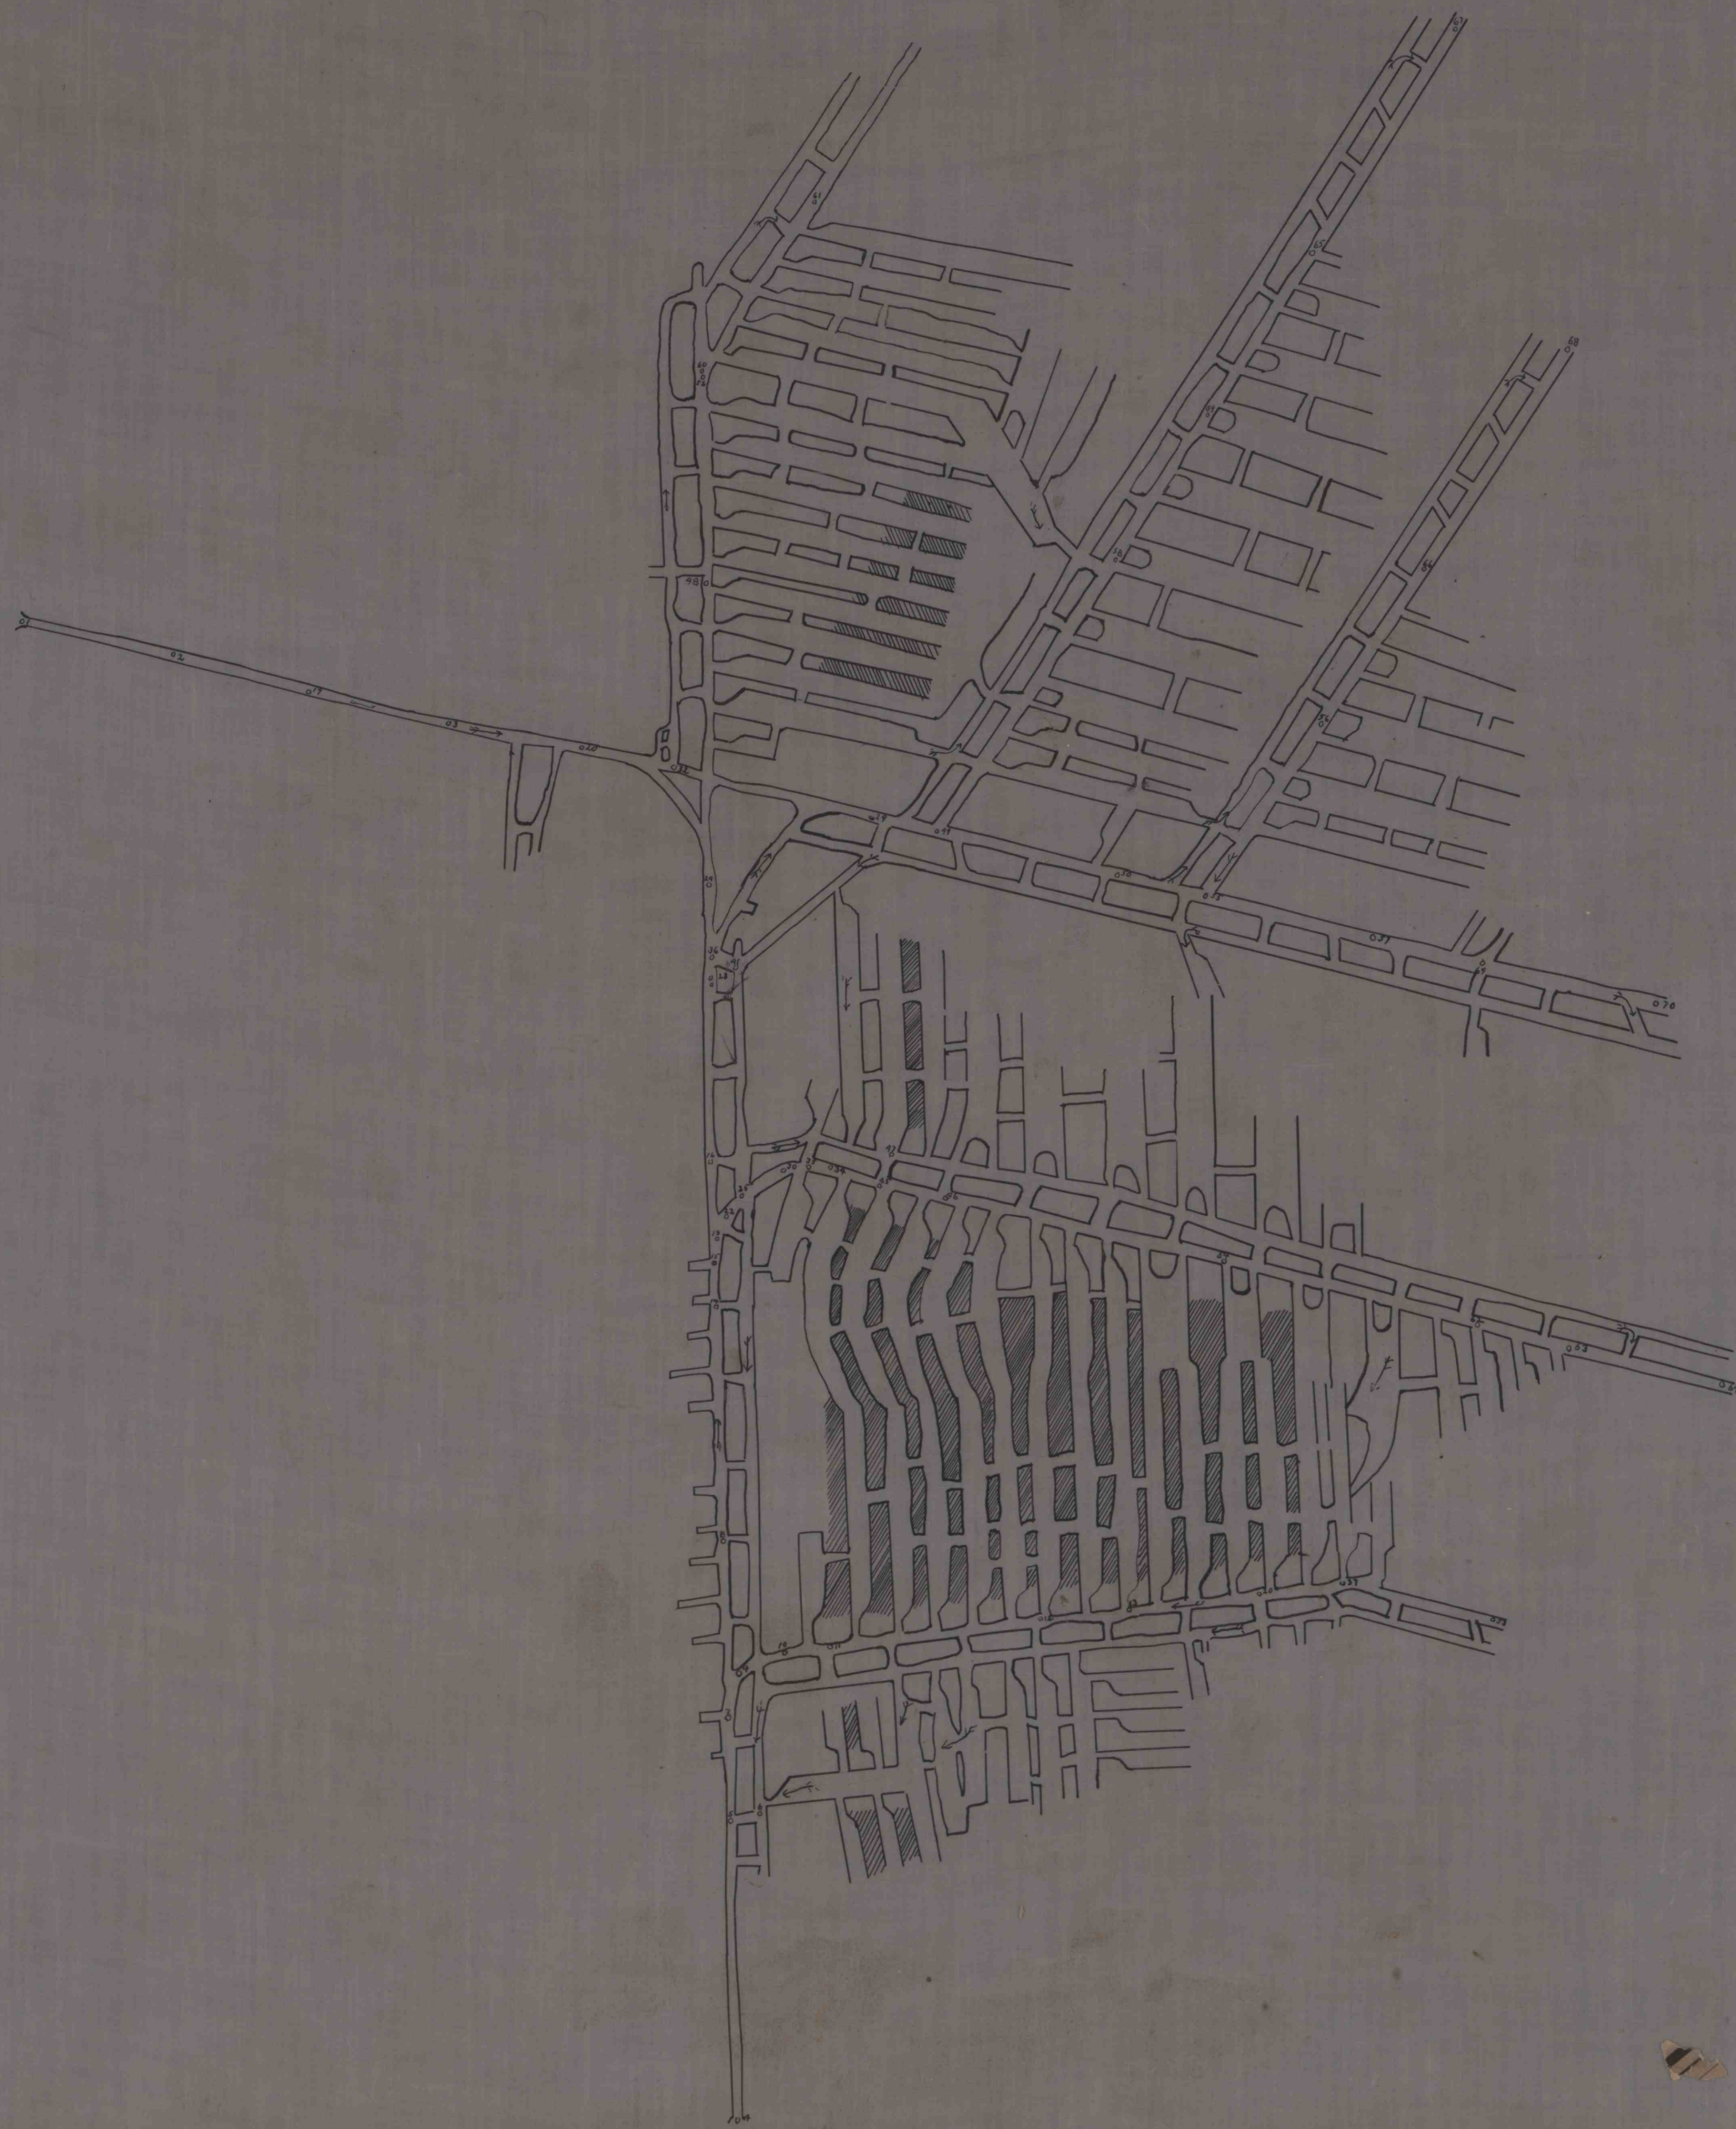

TIoga COAL CO.

Morris Tioga Co. Pa.
June 15 1909 J.B. Eng.

Rattler Colliery
Class Vm
A-16