


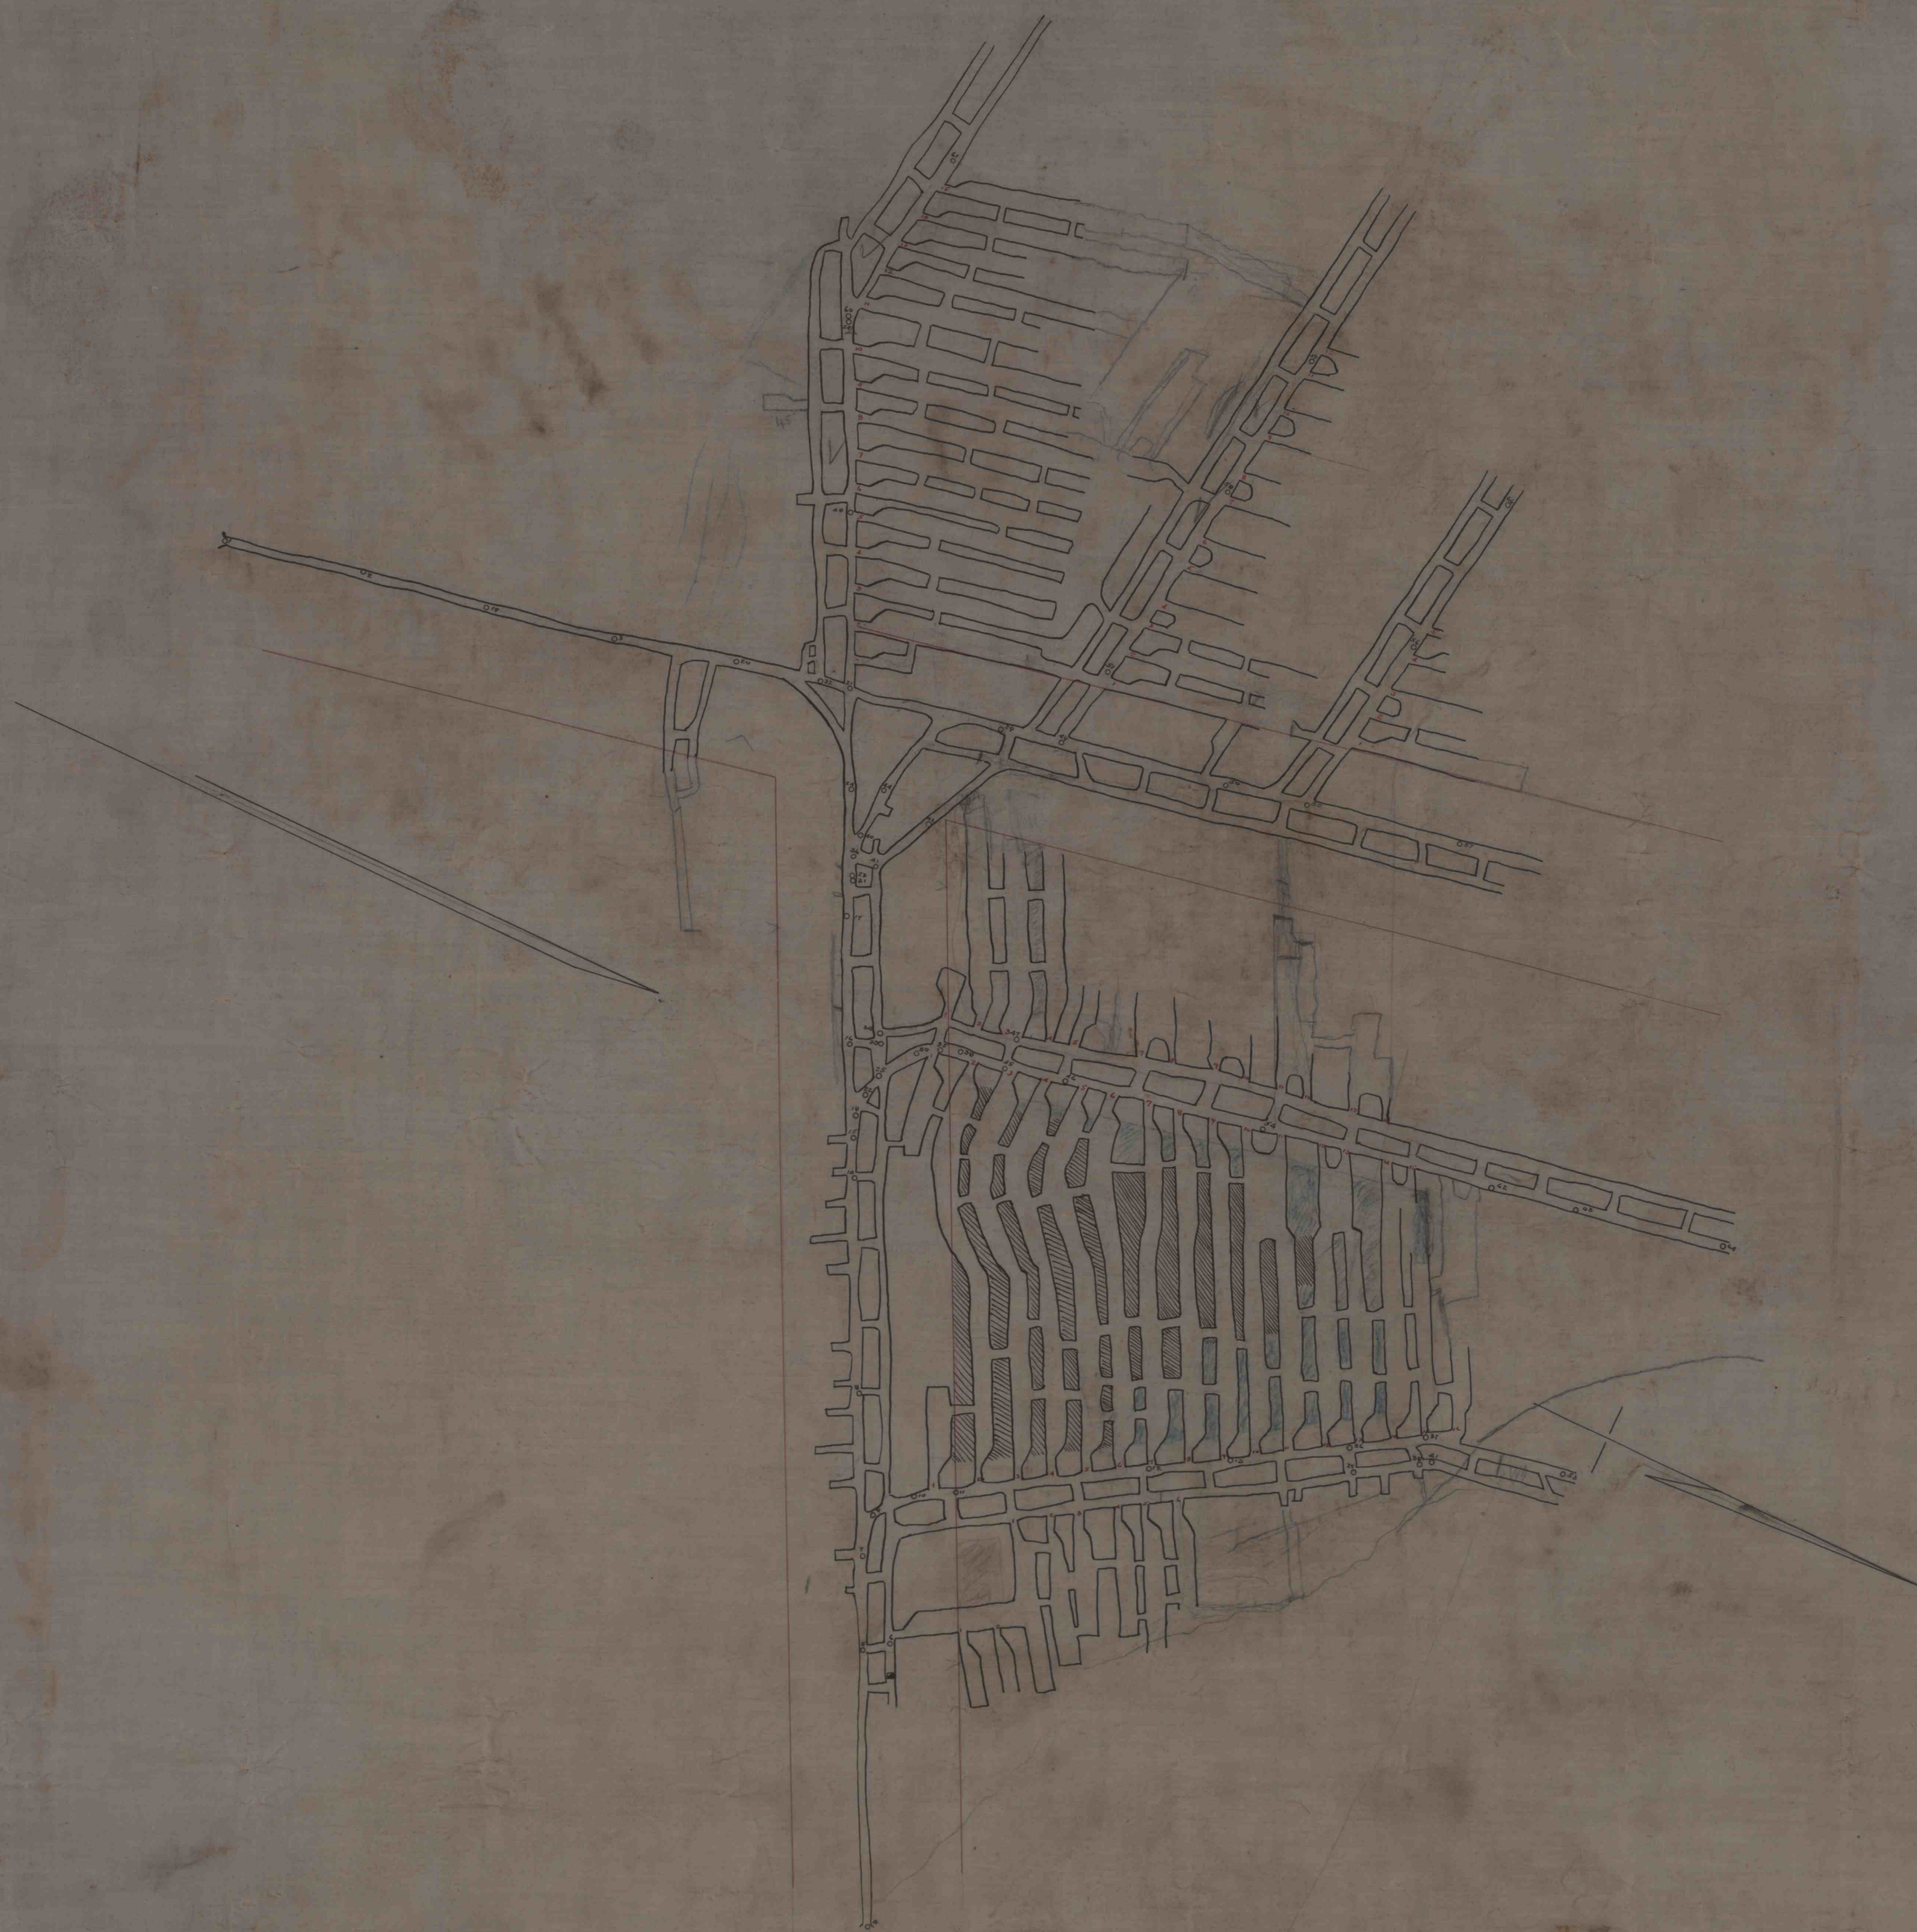

MINE FOREMAN'S MAP  
—OF THE—  
TIOGA COAL COMPANY'S  
BLOSS VEIN WORKINGS  
—MINES AT—  
RATTLER-TIOGA COUNTY-PA.

SCALE 1"=100'

1908

CKSHUPP-ENGR