


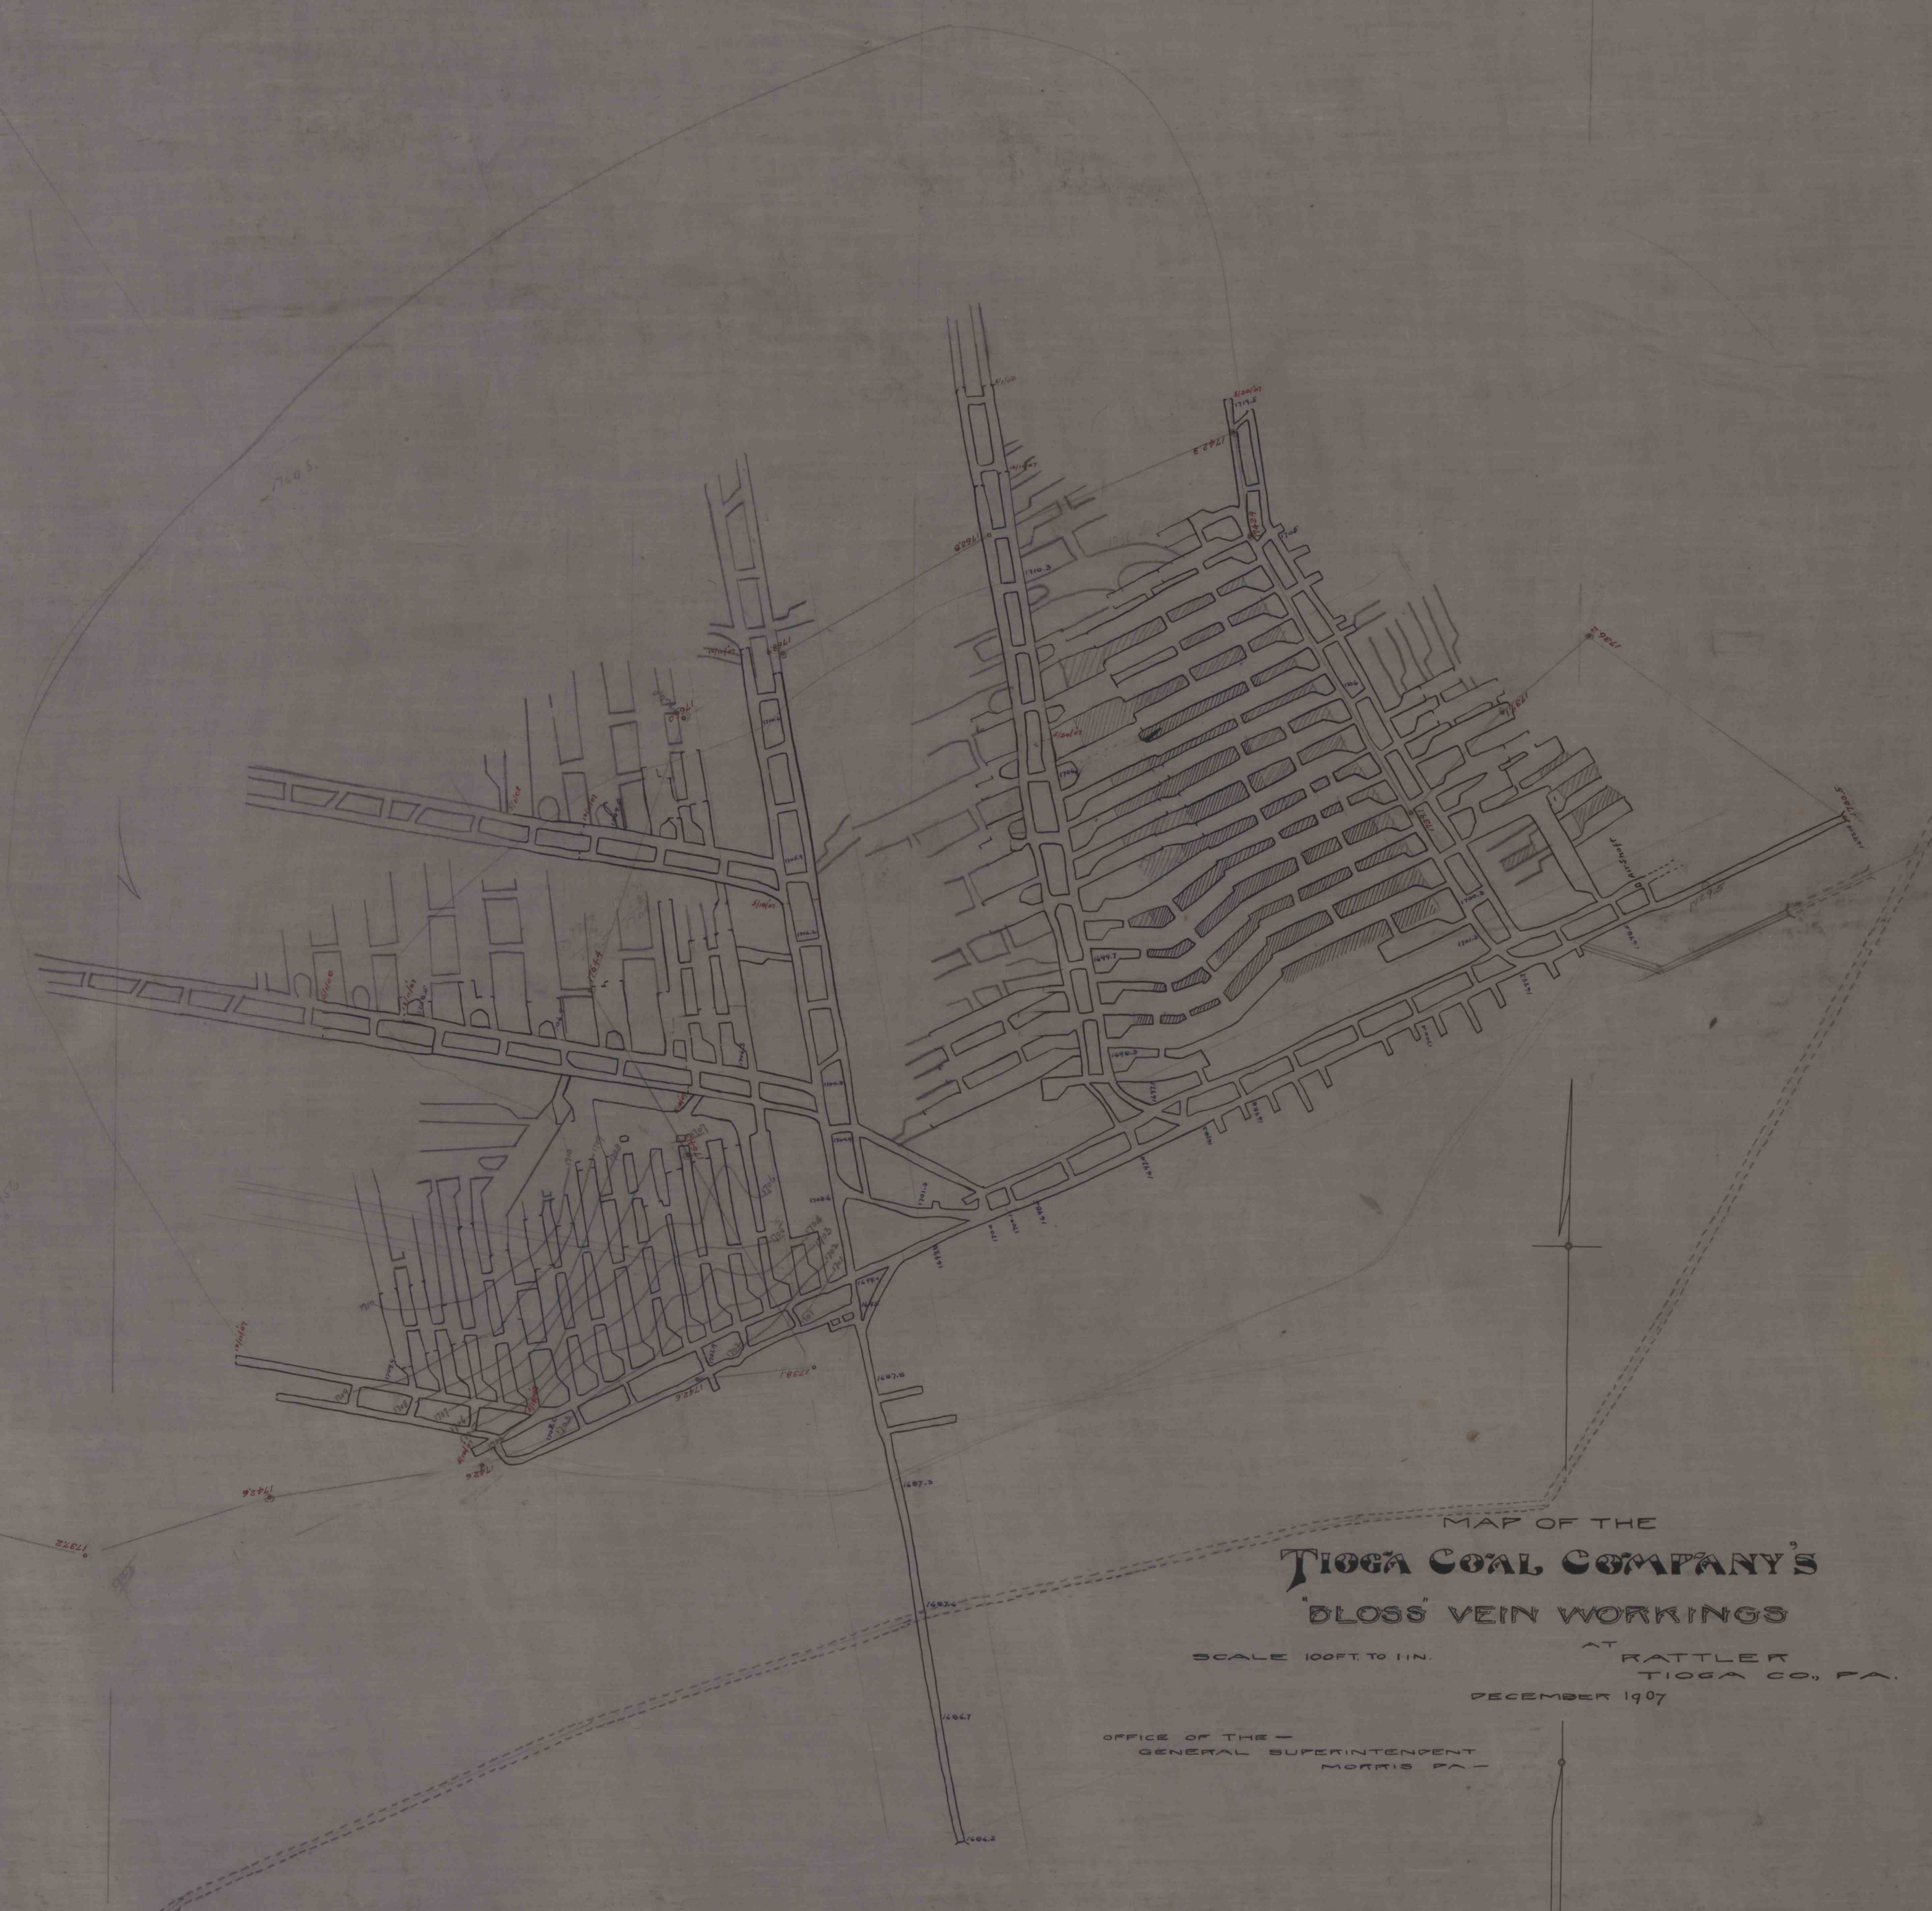

MAP OF THE
TIOGA COAL COMPANY'S
'BLOSS' VEIN WORKINGS

SCALE 100 FT TO 1 IN.

AT RATTLER
TIOGA CO., PA.

DECEMBER 1907

OFFICE OF THE
GENERAL SUPERINTENDENT
MORRIS PA.

