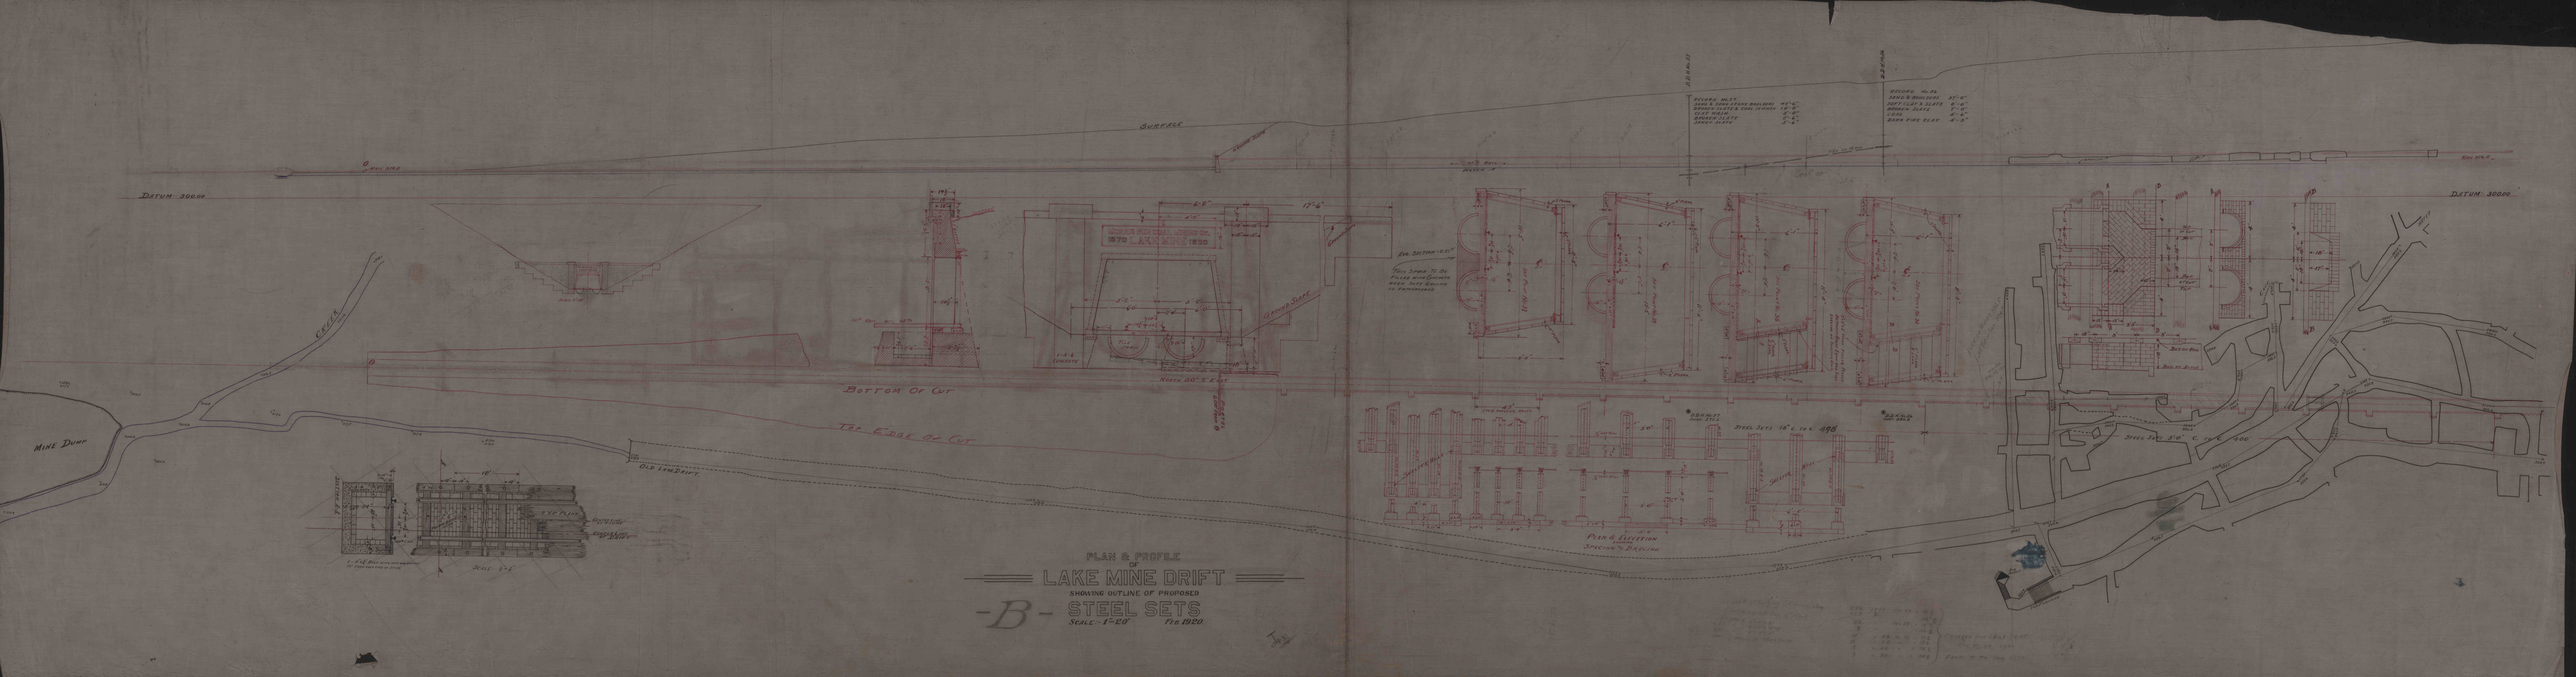
PLAN & PROFILE
OF
LAKE MINE DRIFT
SHOWING OUTLINE OF PROPOSED
-B- STEEL SETS
SCALE: 1"=20'
FEB 1920
DATUM: 300.00
SURFACE
MINE DUMP
CREEK
BOTTOM OF CUT
TOP EDGE OF CUT
OLD LAKE DRIFT
STEEL SETS 18" C. TO C.
STEEL SETS 3'0" C. TO C.
PLAN & ELEVATION
SPACING & BRACING