

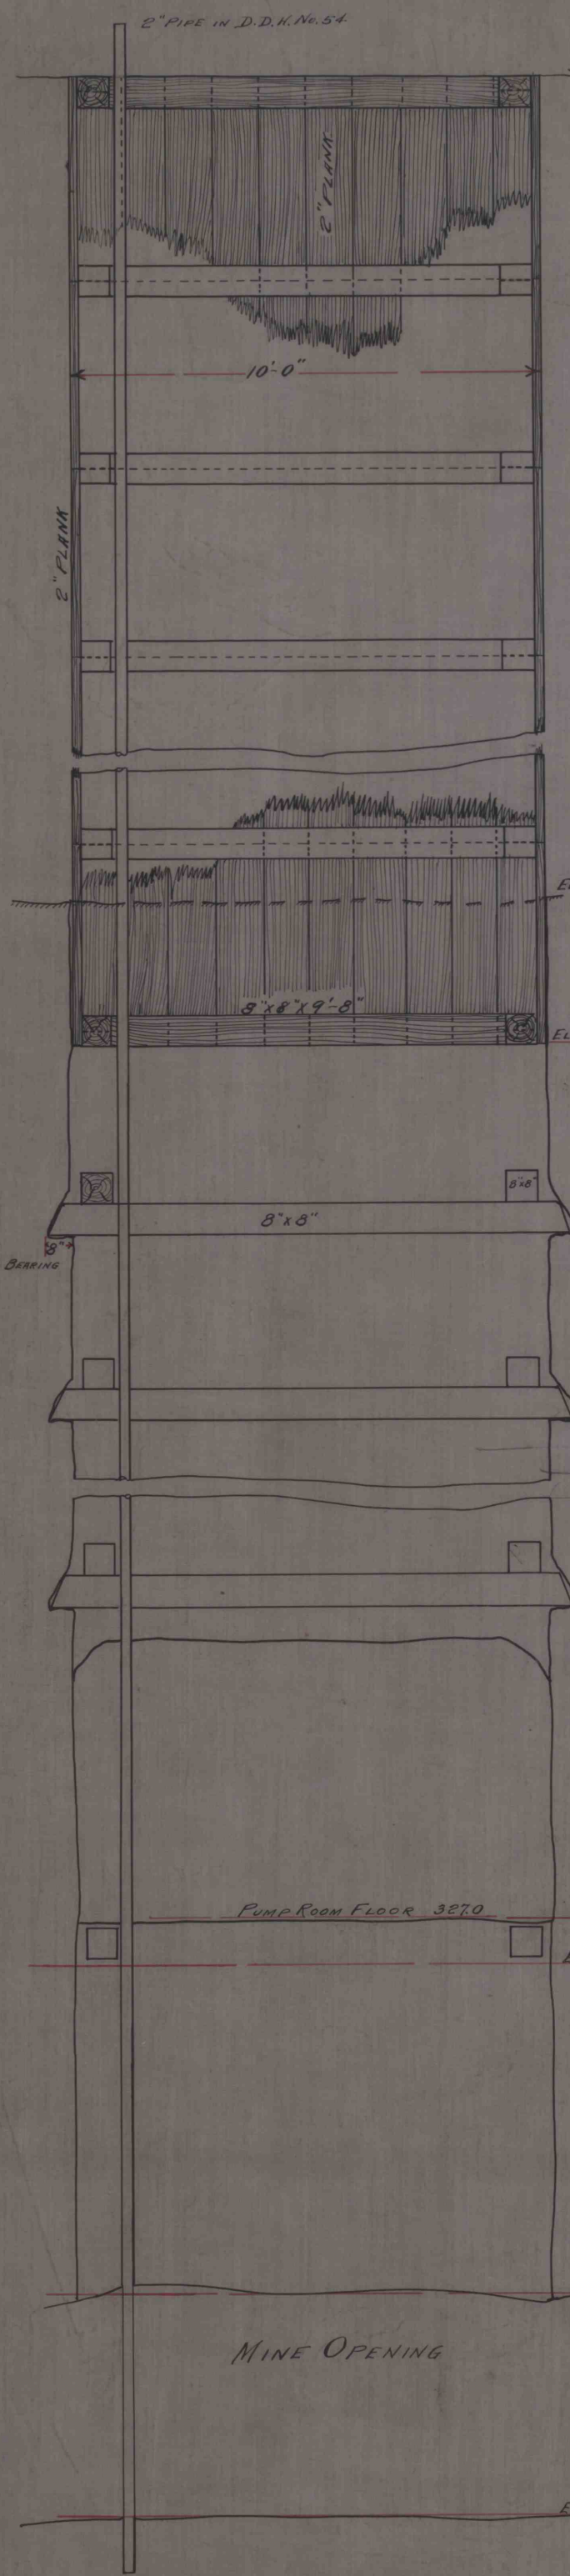


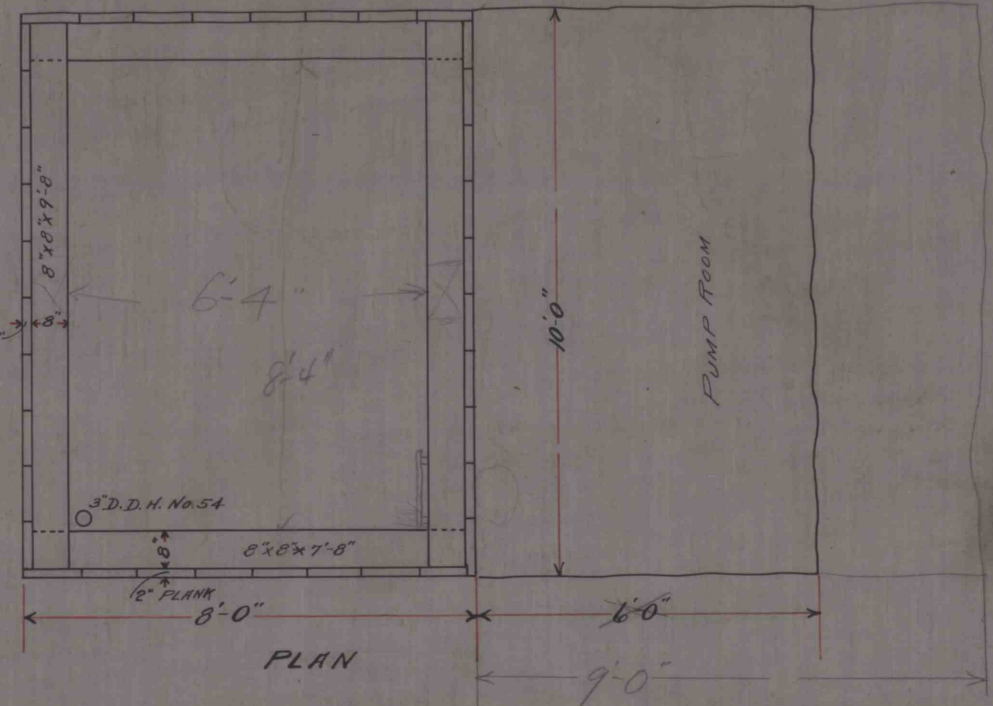

SECTION D.D.H. No. 54

	THICKNESS	TOTAL
BOULDERS	25'-6"	25'-6"
SAND STONE	12'-0"	37'-6"
BLACK SLATE	8'-6"	46'-0"
CORL	1'-0"	47'-0"
SHALEY FIRE CLAY	1'-0"	48'-0"
BLACK SLATE	19'-0"	67'-0"
OPENING IN MINE	5'-0"	72'-0"
CORL	1'-0"	73'-0"

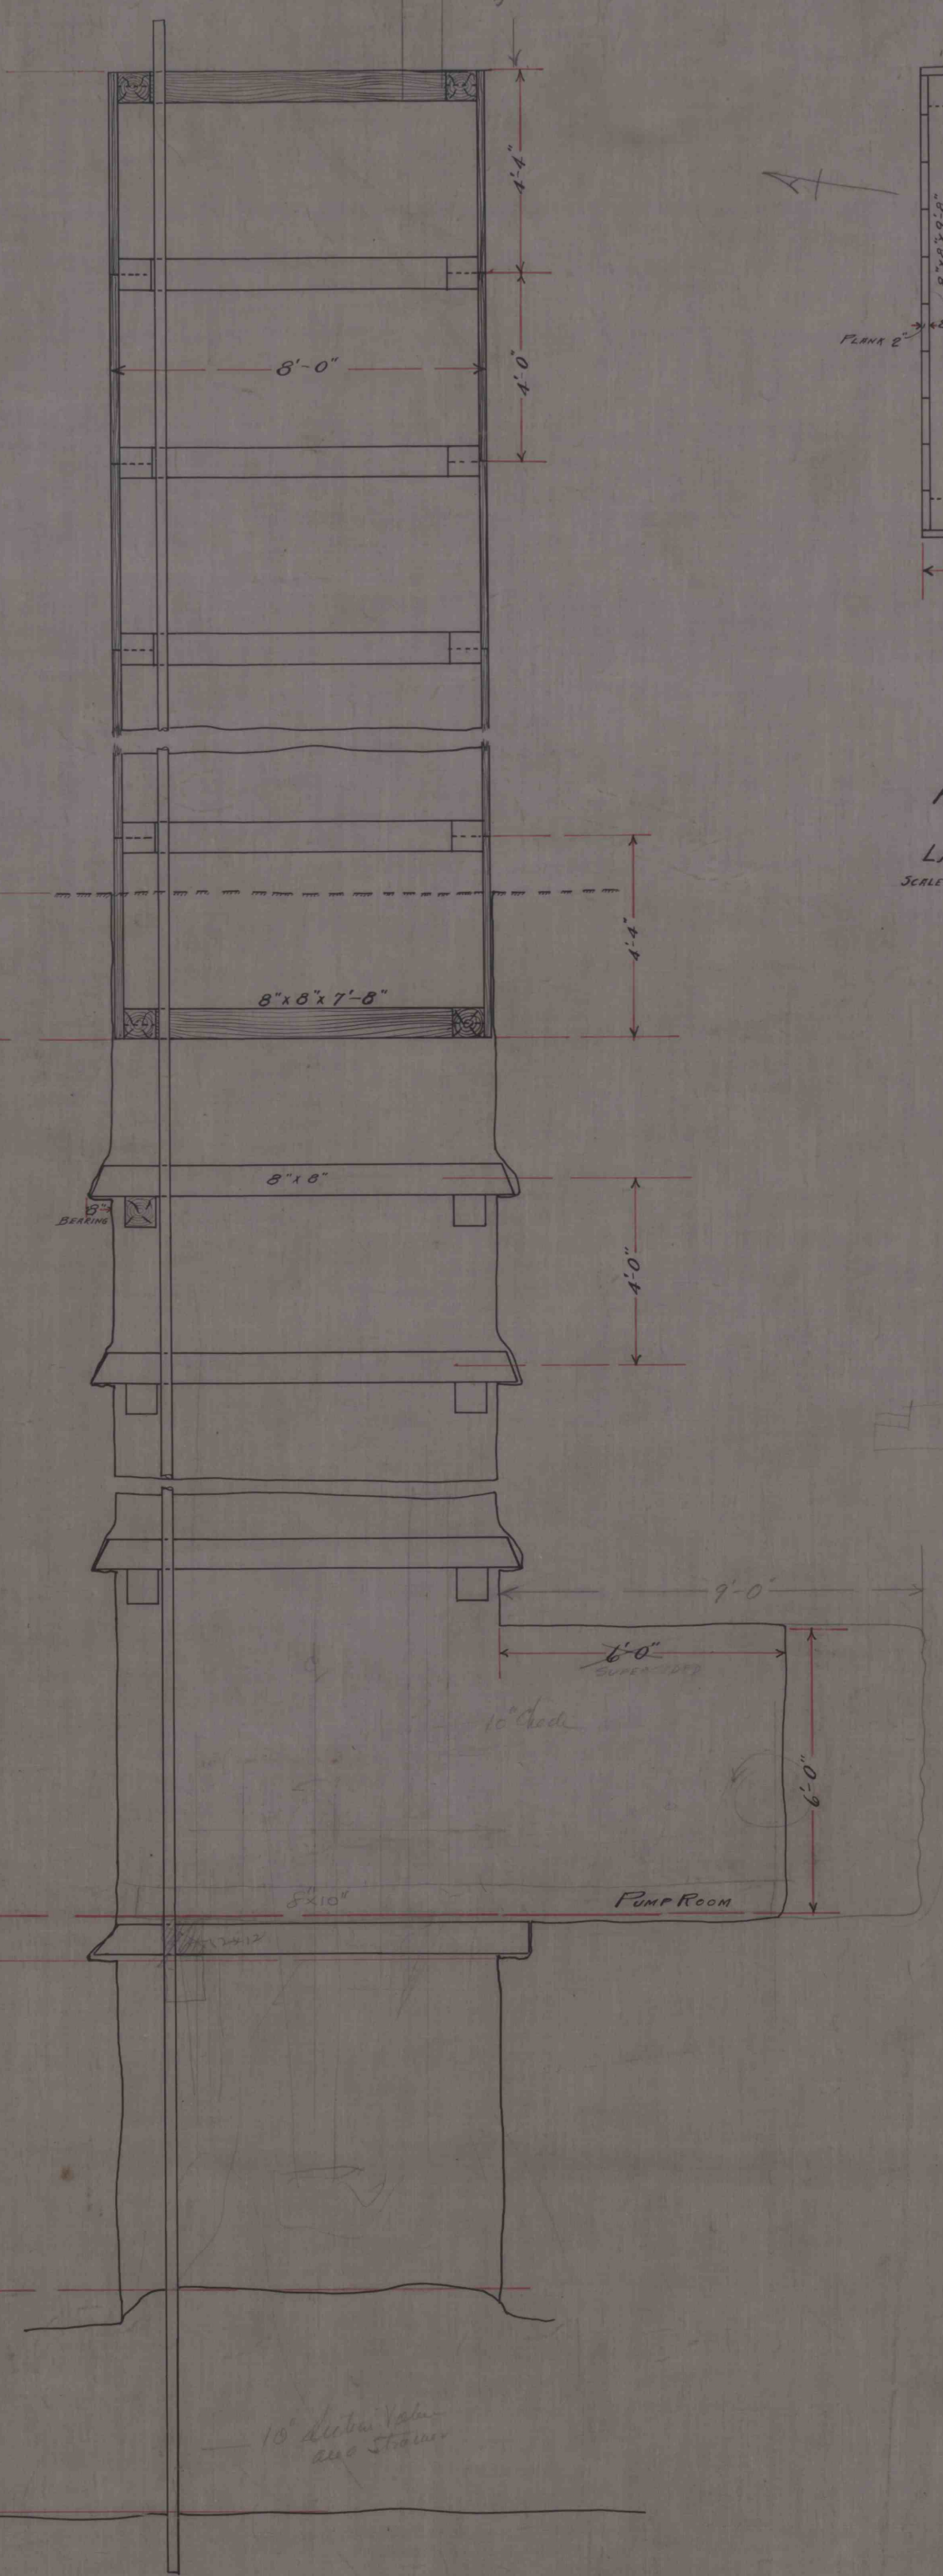

PUMP SHAFT
TO
LAKE MINE
SCALE - 8'-1" MARCH 1920

MINE OPENING

PUMP ROOM

SEE 44-5 FOR HEADFRAME

B36

386
49.5
336.5