


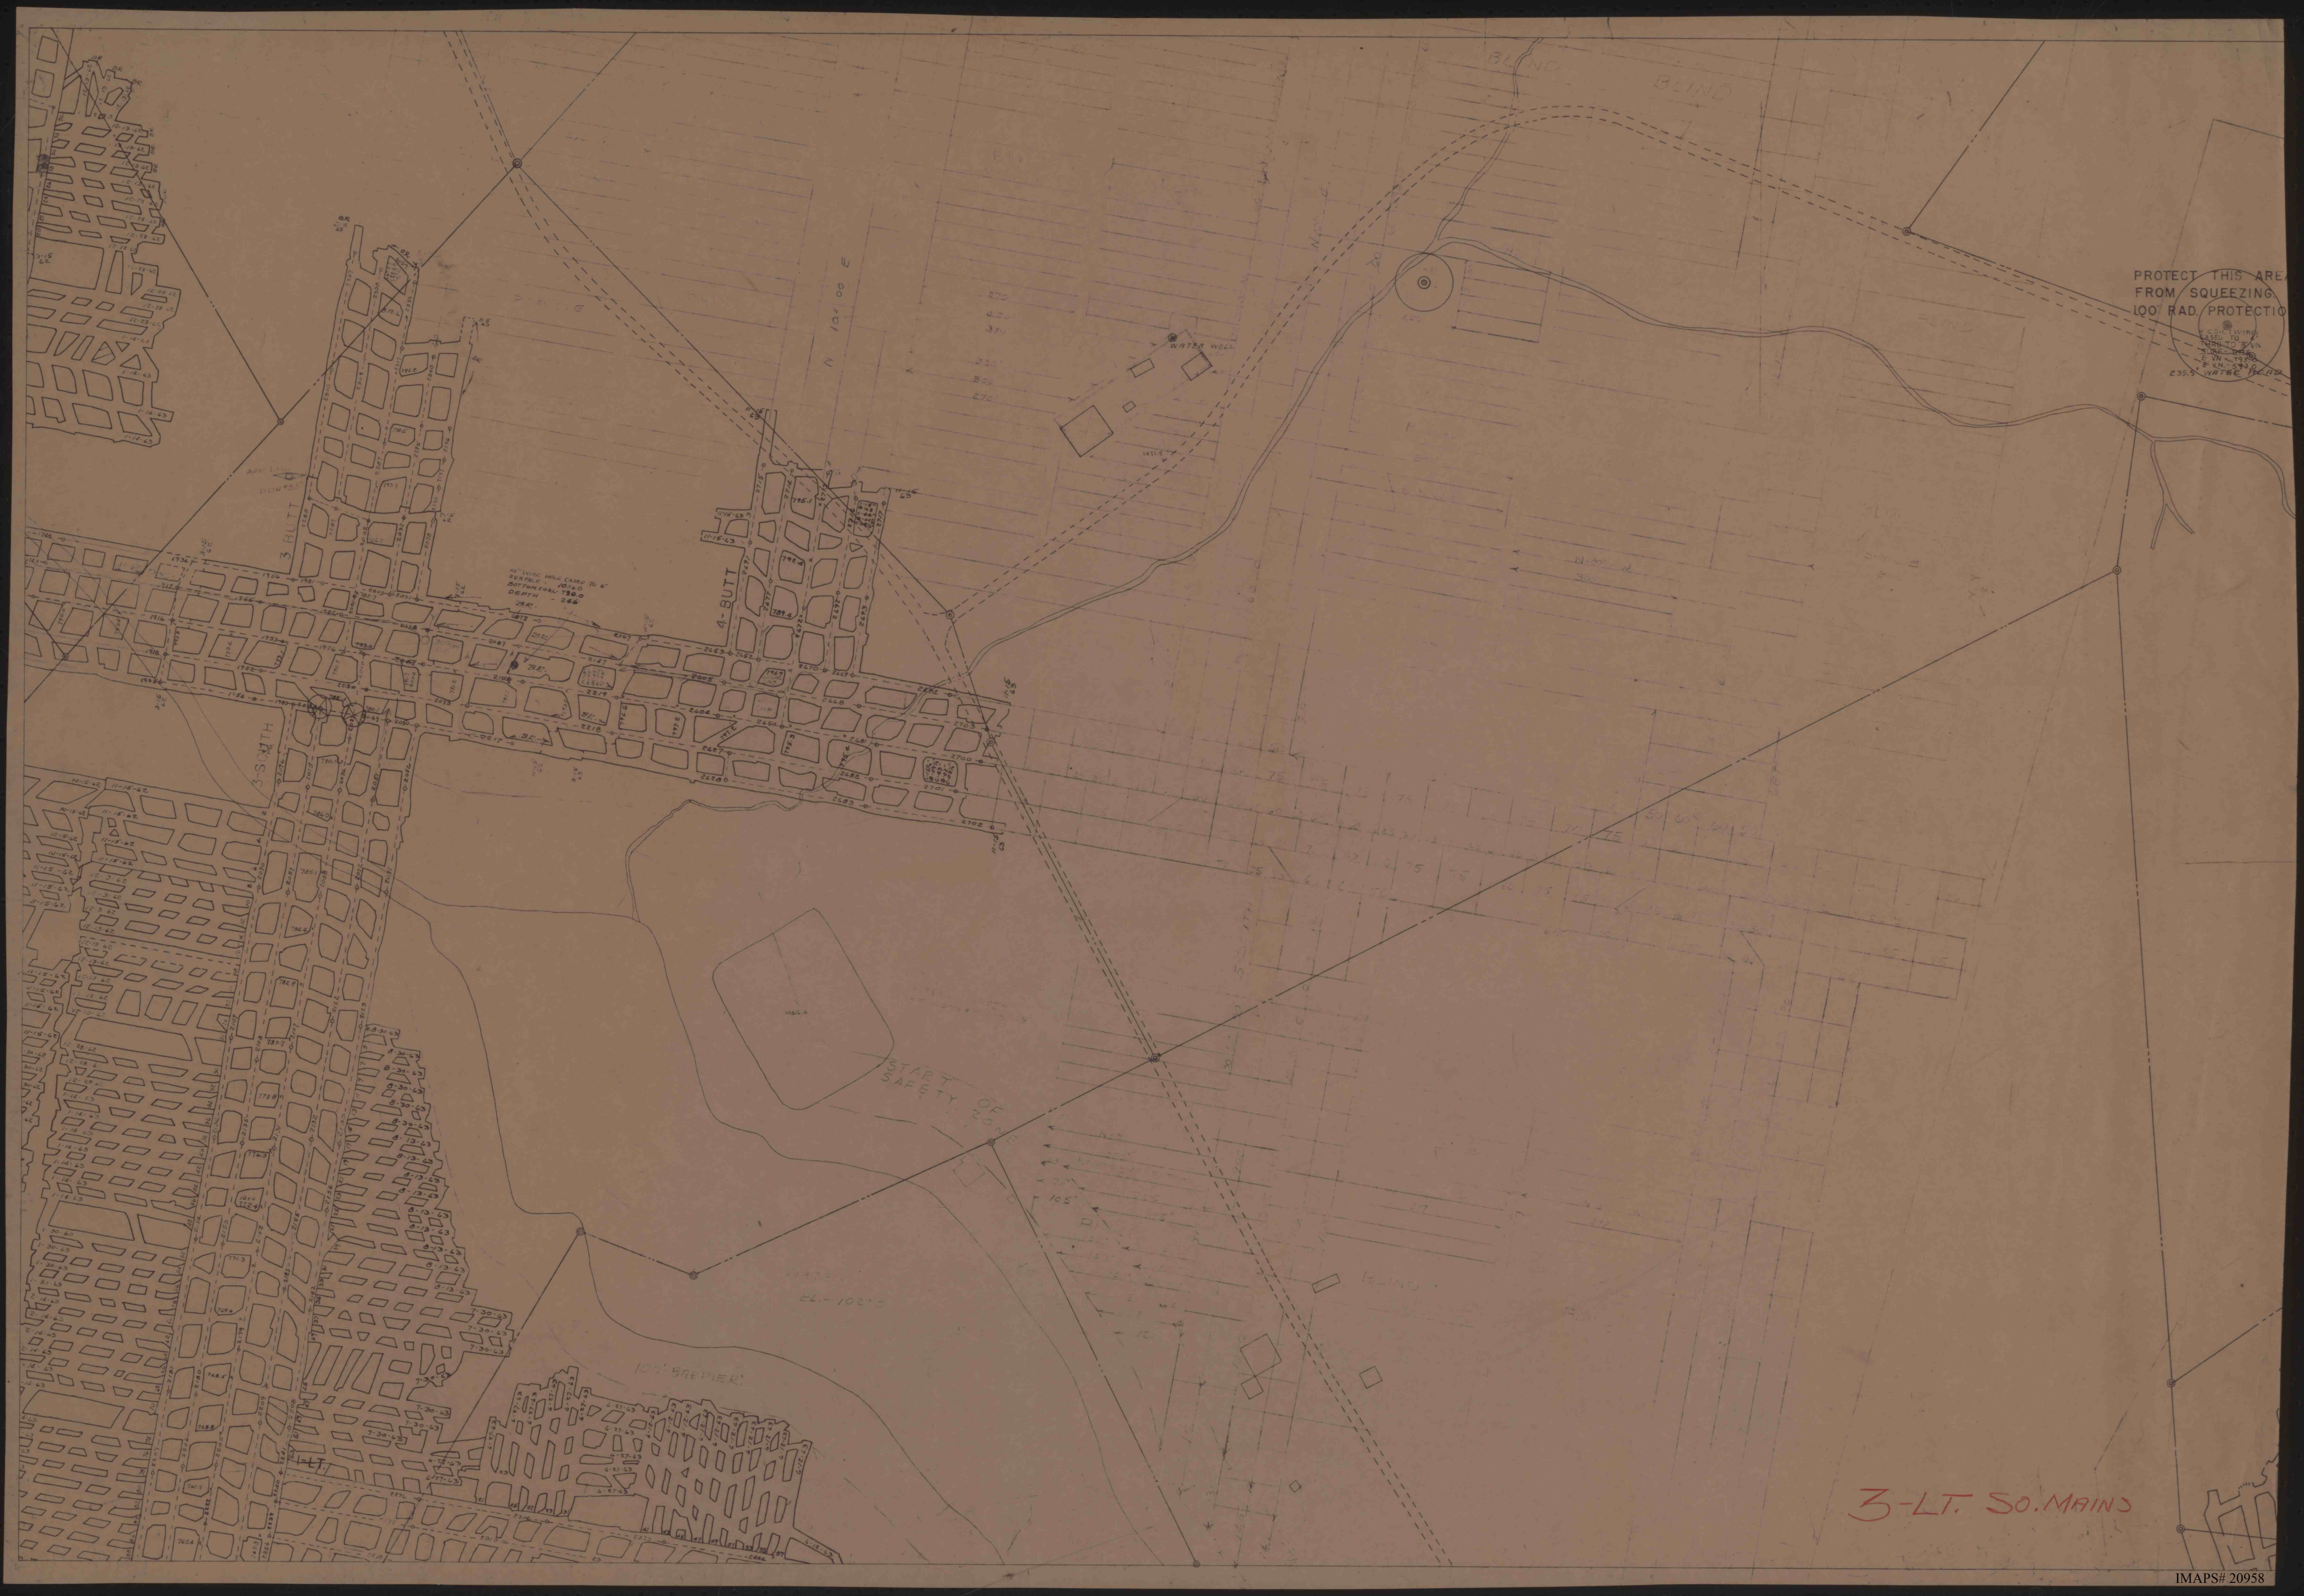

PROTECT THIS AREA
FROM SQUEEZING
100' RAD. PROTECTION

3-BUTT

4-BUTT

3-SOUTH

START OF
SAFETY OF
ROAD

100' BARRIER

3-LT. SO. MAINS